D 87 A

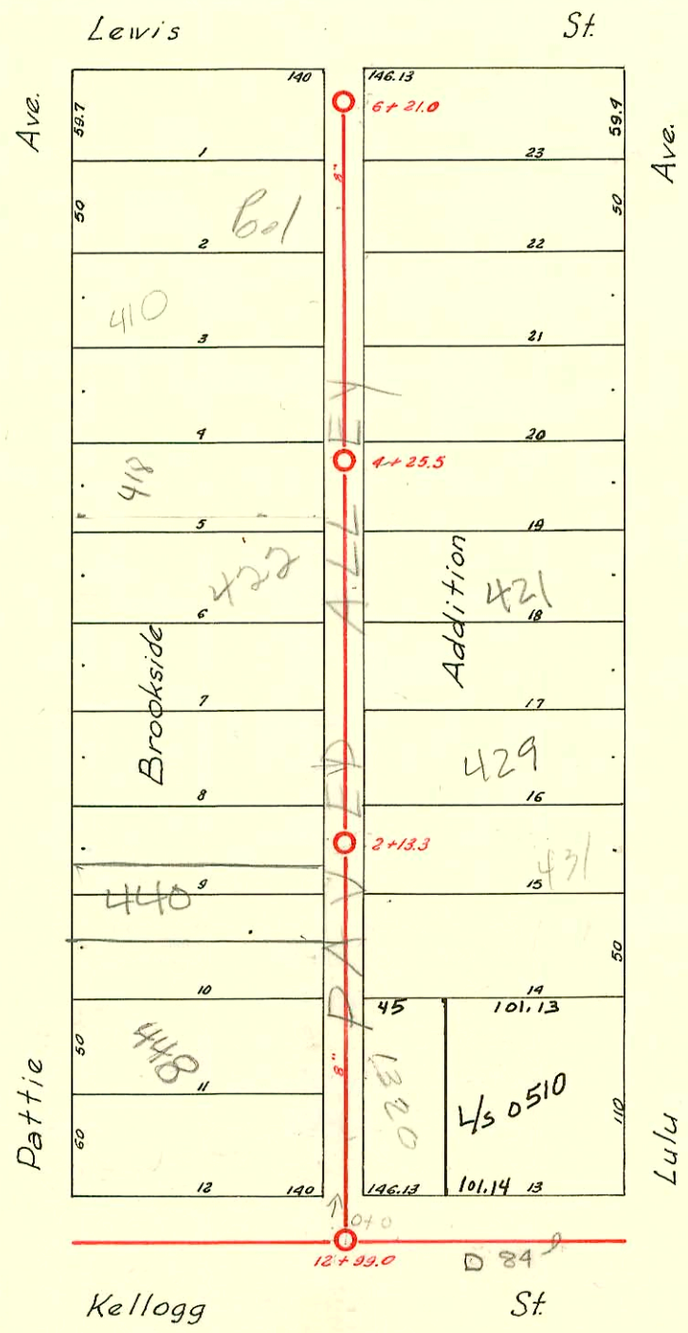


DIST. 1 – S.S. NO. 20 – 1919

2001 – 00014 – 1/3/01 – 440 S Pattie – Creekmore Plbg – 4" SCH40 – ITWIN CO – 44' NO HUB / 1 WYE / soil pipe ext PVC to existing ABS

D87

Form 41-(54) 8-53

# CONSTRUCTION RECORD / SERVICE RECORD

SAN SEWER FOR LOT 1 WOODCHUCK VILLAS 2ND ADDN

| STATION | ELEVATION Ground | ELEVATION Grade | Depth | MANHOLE | 4-INCH "Y" BRANCHES North West | 4-INCH "Y" BRANCHES South East | No. of Permit North West | No. of Permit South East | House Number North West | House Number South East | DATE OF PERMITS North West | DATE OF PERMITS South East |
|---|---|---|---|---|---|---|---|---|---|---|---|---|
| 0+00 | 144.00 | 133.91 | 10.1 | 0+00 EXISTING | 4"STUB W | 0+20 0 Tap | | 7615 | | 408 Woodchuck | | 3-8-83 |
| | 142.56 | 134.16 | 8.4 | 0+62 | 4"STUB NW | 4"STUB NE | 7614 | | 406 Woodchuck | | 3-8-83 | |
| | | | | | | | | | | | | |
| | | | | | | | | | | | | |
| | | | | | | | | | | |