
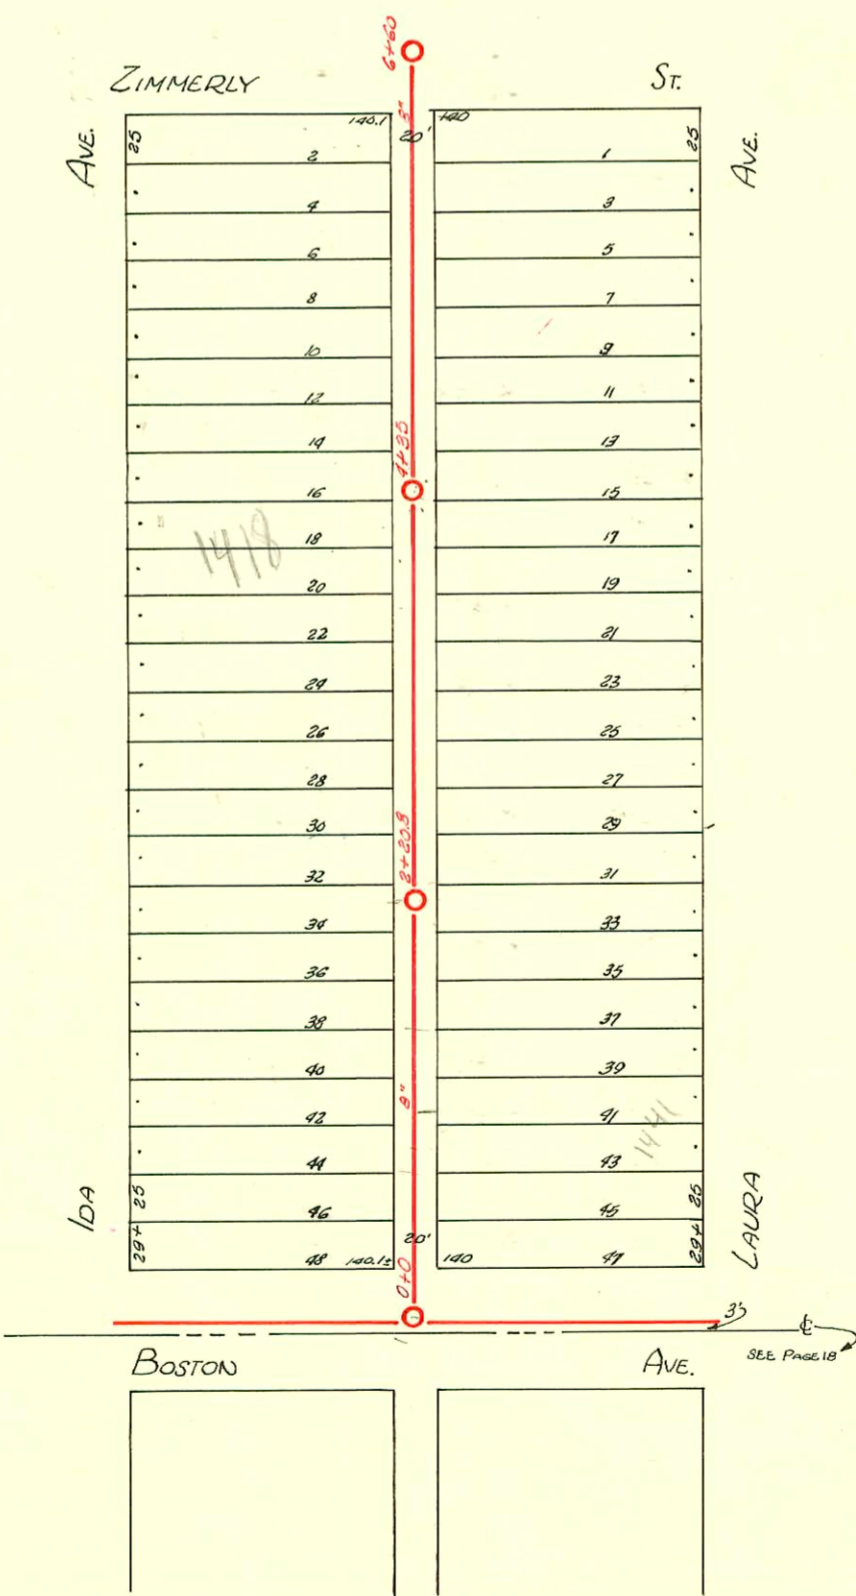


DIST. F-S.S. NO. 80-1980

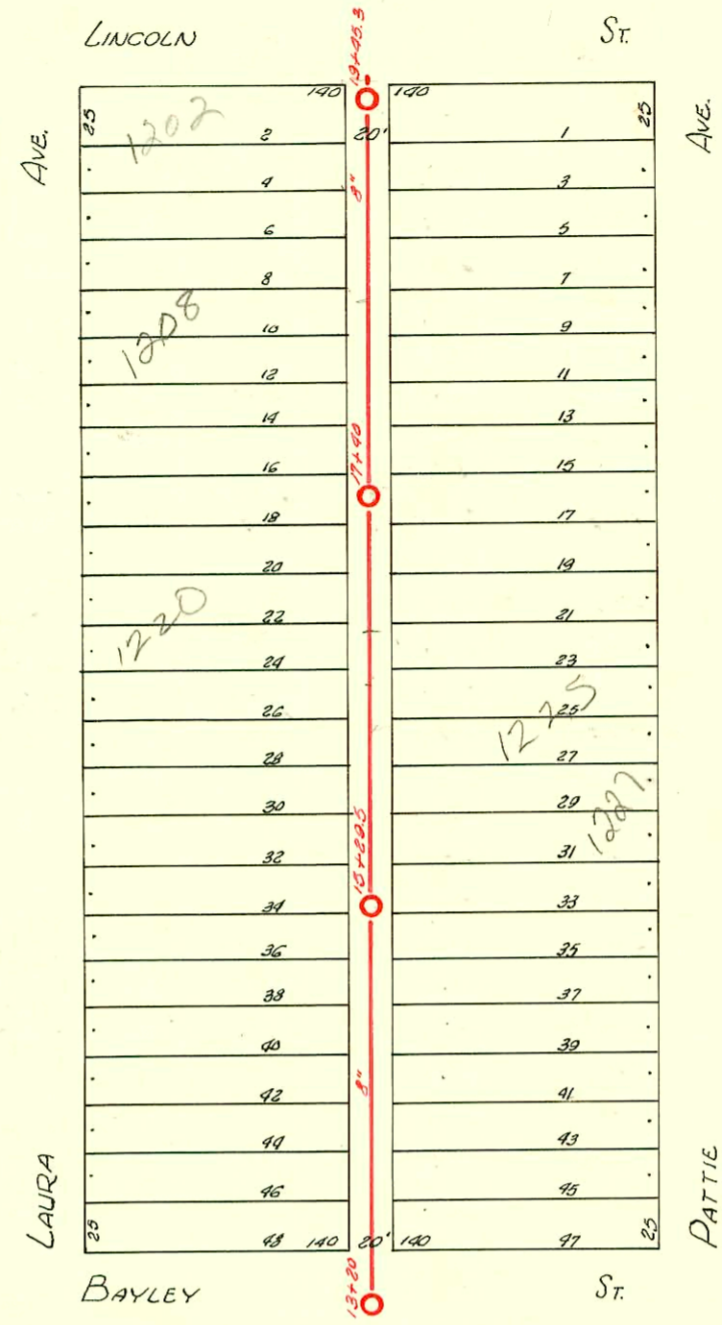

D-105

CONSTRUCTION RECORD						SERVICE RECORD						
STATION	ELEVATION		Depth	MANHOLE	4-INCH "Y" BRANCHES		No. of Permit		House Number		DATE OF PERMITS	
	Ground	Grade			North West	South East	North West	South East	North West	South East	North West	South East
13	105.70	98.80	6.90	+20	+58.5	+56	# 531		1854 Laura	1848 Bayley	3-22-24	5-27-20
					+83.5	+81		# 445				
14	106.73	99.00	7.73		+10	+87.5		# 337	1850 Laura		3-1-24	
					+36.5	+34		# 203			2-10-23	
					+62.5	+60						
					+94.5	+89						
15	106.55	99.20	7.35	+29.5	+14	+11.5	# 1018		1830 Laura	1829 Pattie	11-17-27	3-30-21
					+40.5	+38		# 209				
					+63.5	+63		# 573	1226 Laura	1229 SD Pattie	3-26-24	9-9-78 1-2-30
					+92	+89.5						
16	106.99	99.40	7.59		+17.5	+15	# 20701		1220 B Laura		12-10-20	
					+41	+49	# 733		1224 Laura		4-8-24	
					+69	+66.5	# 450		1227 Laura	1227 Pattie	3-11-24	
					+94.5	+92	# 559	# 135	1218 Laura		4-10-24	2-25-22
17	107.20	99.60	7.60	+40	+21	+10.5		# 178				3-17-21
					+47	+44.5						
					+74	+71.5						
					+99	+96.5	# 629	# 391	1216 Laura	1221 Pattie	4-1-24	4-25-22
18	107.25	99.80	7.45		+23.5	+21	# 616	# 1306	1212 Laura	1211 Pattie	7-21-26	3-26-42
					+30.5	+48	# 830		1210 Laura		9-28-26	
					+74	+71.5		# 1270	1205 Laura	6. Lincoln		9-29-22
					+98	+95.5	# 2318	# 337	1202 Laura	1207 E. Lincoln	10-15-24	4-10-30
19	107.40	100.00	7.40	+45.3	+19.5	+17	# 1199		1201 Laura		8-17-59	
					+41	+38.5						
0+0	102.21±	96.68	5.53	0+0	+34.5	+32		# 634	1427 Laura	1426 Laura		4-1-24
					+59	+56.5	# 292	# 1362	1427 Laura	1427 Laura	4-2-30	10-27-48
					+85	+82.5	# 1398		1428 Laura		6-13-24	
1	102.33	96.78	5.55		+10	+87.5		# 633	1420 Laura	1421 Laura		4-1-24
					+36	+33.5	# 1645		1420 Laura		7-16-24	
					+60	+57.5	# 1494	# 478	1430 Laura	1439 Laura	6-25-24	3-13-24
					+85.5	+83						
2	102.65	96.88	5.77	+20.8	+11	+88.5	# 23311	# 313	1426 Laura	1435 Laura	6-25-24	2-27-24
					+37	+34.5	# 2016	# 1105	1424 Laura	1431 Laura	5-17-71	5-14-24
					+61.5	+59						
					+87.5	+85		# 783	1429 Laura			4-10-24
3	102.86	96.98	5.88		+13	+10.5	# 1955		1422 Laura		8-28-24	
					+39	+36.5		# 561	1425 Laura			3-25-24
					+63.5	+63						
					+90.5	+88		# 560	1421 Laura			3-25-24
4	103.16	97.08	6.08	+35	+16.5	+14	# 49	# 975	1418 Laura	1417 Laura	2-11-25	4-30-24
					+43	+40.5	# 1401		1416 Laura		6-14-24	
					+68	+65.5						
					+94.5	+92		# 1463	1413 Laura			6-23-24
5	104.04	97.18	6.86		+20.5	+18	# 1425	# 289	1404 Laura	1405 Laura	6-17-24	2-25-24
					+46	+43.5		# 600	1404 Laura	1404 Laura		3-28-24
					+72.5	+70						
					+98.5	+96						
6	103.91	97.28	6.63	+60	+25	+22.5	# 429		1402 Laura		5-22-20	

6436 - Setting wye - 1839 Pattie - 9-15-53 - Trailer -
 # 394 - Private Line - 1207 E. Lincoln - 4-21-30 - C.W. Burgan
 # 114 - Private Line - 1211 E. Lincoln - 10-24-34 - Plummer & Skinnell
 # 115 - Private Line - 1201 Pattie - 10-24-34 - Plummer & Skinnell
 # 5380 - 1443 Laura - 9-28-51 - R. McCoy - Used old connection

4053 - Sep - 14043 Ida - McCarroll - 3-13-57