

15th St

Ave.

Lot 1  
Ferrell's 9th  
Addition


14th St


13th St


Woodland (ives Carlos)


Woodland St

Biting Ave.

LAT. K - DIST. R  
S.S. NO. 20  
MEILERT - 1928


2  
↑  
L=150

LAT. J - DIST. R  
S.S. NO. 20  
H.L. MILES  
1928

LAT. K - DIST. R  
S.S. NO. 20  
MEILERT - 1928

Salina Ave.

Burns

Woodland

Shady

Way

Woodland (ives Carlos)

Biting


D-184

CONSTRUCTION RECORD

SERVICE RECORD

STATION	ELEVATION		Depth	MANHOLE	4-INCH "Y" BRANCHES		No. of Permit		House Number		DATE OF PERMITS	
	Ground	Grade			North West	South East	North West	South East	North West	South East	North West	South East
0+0	119.74	108.41	11.33	0+0	0+37.5	0+35	# 920		1533	Woodland		6-13-38
					0+63	0+60.5	# 1655		1538	Burns	6-19-39	
					0+88.5	1+05	# 1966	376	1533	Woodland	11-9-39	4-14-28
1+0	119.86	108.51	11.35		1+12.5							
					+37.5	1+35	# 907	# 317	1542	Woodland	1-24-42	6-24-37
					+63	+60.5						
2+0	119.66	108.61	11.05		+89	+86.5						
					2+15	2+12.5	# 2419	# 41	1538	Woodland	6-15-40	8-19-37
					2+19.6	+40.5	# 5123	1673	1532	Woodland	3-7-40	11-27-29
3+0	119.51	108.71	10.80		+66	+63.5						
					+92	+89.5	# 2036	# 1473	1532	Woodland	12-14-39	10-15-29
					3+17.5	3+15						
4+0	117.54	108.81	8.73		+43	+40.5						
					+69	+66.5	# 1065		1533	Woodland		5-16-39
					+94.5	+92	# 1006	# 1478	1524	Woodland	3-6-29	4-21-39
5+0	115.46	108.91	6.55		4+20.5	4+18						
					4+39.5	+48.5	# 2088	# 802	1516	Woodland	2-20-40	4-13-39
					+74	+71.5						
6+0	114.01	109.01	5.0		5+0	4+27.5						
					+26	5+23.5	# 2537		1518	Woodland	7-31-40	1-5-39
					+51	+48.5	# 3704	# 1420	1508	Woodland		3-31-39
7+0	117.72	109.11	8.61		+77	+74.5						
					6+22.5	6+20						
					6+61	+25.5	# 2125		1508	Woodland	3-7-40	6-15-29
8+0	118.07	109.21	8.86		+89.5	+87						
					7+13.5	7+13	# 181	# 1462	1460	Woodland	9-22-41	10-14-29
					+40.5	+38						
9+0	118.50	109.31	9.19		+66.5	+64	# 55		1458	Woodland	5-6-46	6-1-39
					+91.5	+89	# 1612		1455	Woodland		
					8+17.5	8+15	# 1228		1427	Woodland		1-5-39
					+43.5	+41	# 1625		1423	Woodland		6-23-39
10+0	117.19	109.41	7.78	8+87.1	+68.5	+66	# 2928		1228	Woodland	12-5-40	
					+94.5	+92	# 1717		1423	Woodland		12-5-29
					9+20	9+17.5	# 2053	# 2228	1444	Woodland	10-30-03	
							# 2079		1454	Woodland	2-8-40	
11+0	117.27	109.51	7.76		+47	+44.5	# 1931	# 158	1431	Woodland	10-30-39	3-6-30
					+78.5	+70	# 2244		1440	Woodland	4-19-40	
					+97.5	+95	# 302		1229	Woodland		6-15-37
					10+24	10+21.5	# 141		1426	Woodland	11-19-47	
12+0	117.09	109.61	7.48		+50.5	+48	# 3379	# 1075	1432	Woodland	7-27-51	9-9-38
					+76	+73.5						
					11+01.5	10+29.0	# 3206	# 258	1424	Woodland	8-20-41	10-16-37
13+0	118.60	109.71	7.89		+26.5	11+24						
					+52.5	+50	# 1971		1419	Woodland		11-13-39
					+83	+80.5	# 22		1418	Woodland	9-3-41	
14+0	117.22	109.81	7.41		+88	+85.5	# 616	# 1676	1425	Woodland	8-6-48	6-23-39
					+93	+90.5	# 252		1401	Woodland		10-23-35
14+42.4	117.43	109.86	7.57	12+01	12+24.5	12+22	# 1016		1402	Woodland	7-28-38	
					13+72.4	16+05 N.						
15+0	117.86	109.91	7.95	14+47.4	+31		# 1761		1345	Woodland	8-8-39	
					+57		# 532		1403	Woodland	6-2-28	
					15+78	+83						
16+0	118.46	110.01	8.45	17+08.5	17+24	5	# 567		911	Woodland	10-28-37	
					17+50	+34						
					17+63.5	17+61 C.						
17+0	117.27	110.11	7.16		+20.5	+28						
					18+16.5	18+14						
					18+34.5	+42.5	# 3497	# 538	1321	Woodland	5-14-45	6-18-49
18+0	117.85	110.21	7.64		+68	18+23.5						
18+34.5	117.47	110.24	7.23		+94	18+21.5	# 131		1313	Woodland	4-29-49	
					19+17.5	19+15						
19+0	117.00	110.31	6.69		19+51 N.	19+33.5 S.	# 1617		1020	Shadyway	11-12-29	
						+59						
						19+85	# 1823		928	Shady Way	4-8-39	
20+0	117.77	110.41	7.36			20+11						
						+36.5						
20+54.7	118.53	110.46	8.07	20+54.7		+49.5	# 84		1002	Shady Way	2-19-30	
0+0	117.47	110.24	7.23	0+0	0+15 N.	0+12.5 S.	# 610		1028	Shady Way	6-17-30	
					+41	+38.5						
1+0	117.07	110.35	6.72		+67	+64.5						
					+92.5	+90	# 276		919	Woodland	10-6-41	
2+0	116.61	110.45	6.16	1+988	1+18.5	1+16	# 277		923	Woodland	10-6-41	

Line between Woodland and Burns, South from 15th St.

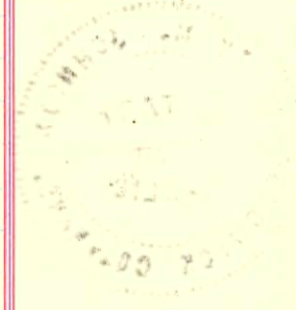

Continued top p. 185.

- #690 - 635 W. 13th - 6-28-30 - C.E. Hafford
- #1222 - 1348 Carlos - 12-29-38 John Gredel
- #1879 - 915 W. 13th - 10-6-39 - Ripstra
- #2421 - Top of 7+328 - 802 Shady Way - Callison - 6-17-40
- #601 - Top at 4+30.5 - 1517 Woodland - 11-15-41 - Kansas Pkg. Co.
- #2587 - Top - 1566 Burns - 2-11-46 - Wichita Pkg. Co.
- #3030 - Top - 919 W. 13th - 10-28-56 - Frederick Pkg. Co.
- #36 - Top - 916 W. 13th - 3-8-50 - Baker Pkg. Co.
- #73 - Used old connection - 316 - 18 Woodland - 38-50 - Scotty Clark
- Ops. #92 to 97 incl. - 635 W. 13th - 5-28-47 (Tourist Camp) - Callison Pkg. Co.
- #98 to 101 incl. - Private Line Connections - 635 W. 13th - Tourist Camp - Callison
- #396 to 401 incl. - 633 Parker (Tourist Camp) Callison - Private Line Connections
- #540 - Top - 1325 - Woodland - 6-18-49 - Scotty Clark Pkg. Co.
- 2001-00908 - #541 - Top - 1327 Woodland - 6-18-49 - Scotty Clark Pkg. Co. 4-17-01 - Roto Rooter - 4" sch 40 - (TWIN CO) 1V22
- #266215 - 719 W. 13th - Burns - 5-4-48 (12947)