D- 190 A

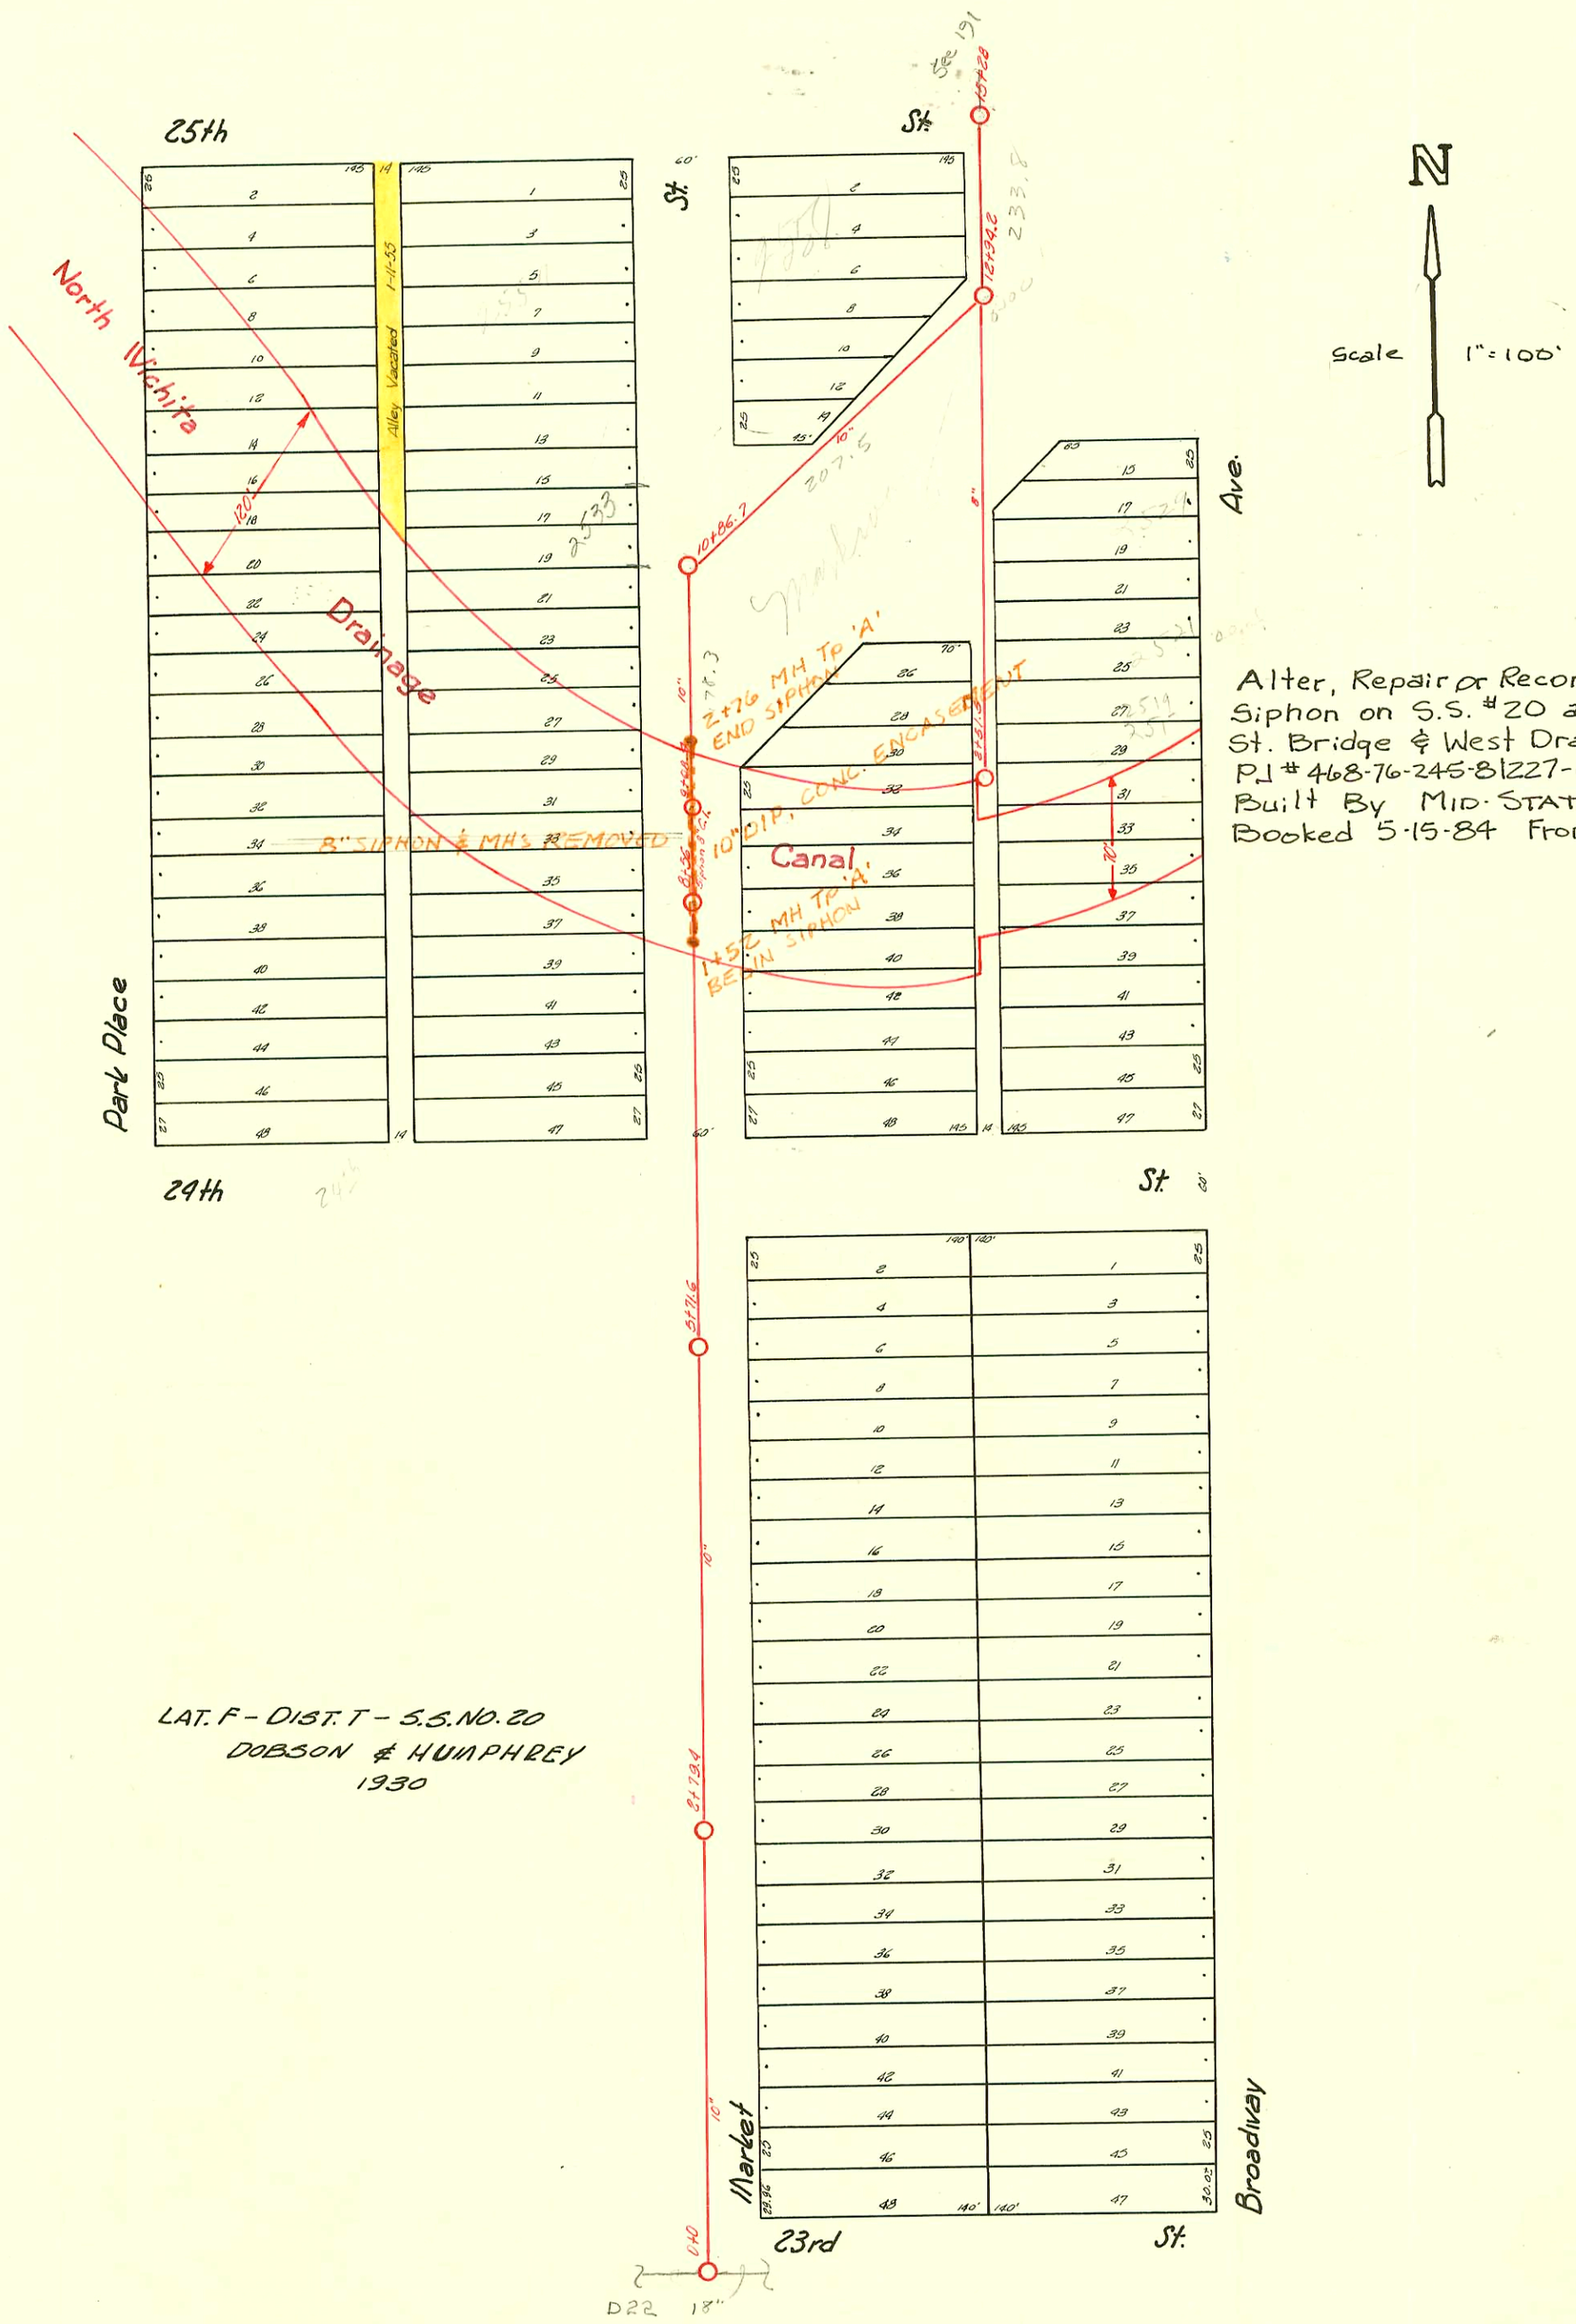

Alter, Repair or Reconstruct S.S. Siphon on S.S. #20 at the Market St. Bridge & West Drain Chisholm Creek
P.J. # 468-76-245-81227-000-000-001
Built By MID-STATES CONST.
Booked 5-15-84 From DRH-5

LAT. F - DIST. T - S.S. NO. 20
DOBSON & HUMPHREY
1930

D-190

Form 41-(54) 12-54

CONSTRUCTION RECORD / SERVICE RECORD

STATION	ELEVATION Ground	ELEVATION Grade	Depth	MANHOLE	4-INCH "Y" BRANCHES South East	4-INCH "Y" BRANCHES North West	No. of Permit North West	No. of Permit South East	House Number North West	House Number South East	DATE OF PERMITS North West	DATE OF PERMITS South East
0+0	123.30	114.10	9.20	0+0 in 23rd St.								
1+0	125.05	114.20	10.85									
2+0	124.70	114.30	10.40	2+79.4								
3+0	124.24	114.40	9.84									
4+0	123.91	114.50	9.41									
5+0	123.72	114.60	9.12	5+71.6								
6+0	124.24	114.70	9.54									
7+0	123.80	114.80	9.00									
8+0	124.33	114.90	9.43	8+56 elev. 114.96		Siphon 8" C.I. pipe						
9+0	122.84	115.40	7.44	9+08.4 elev. 115.40								
10+0	122.70	115.50	7.20									
11+0	123.04	115.60	7.44									
12+0	123.37	115.70	7.67									
13+0	123.14	115.80	7.34									
14+0	124.94	115.90	9.04									
15+0	125.00	116.00	9.00									
15+28	125.33	116.03	9.30									
9+0	122.84	115.40	7.44	9+08.4								
						9+69.9						
10+0	122.70	115.50	7.20			9+95.4						
						10+16.9						
						10+38.9						
						10+61.4						
				10+86.7	10+82.7 TAP	10+81.4	20325		8533 N Market		4-8-88	
11+0	123.04	115.60	7.44			11+42.7						
						11+67.1						
12+0	123.37	115.70	7.67			11+91.2						
						12+16.7						
						12+41.7						
				12+94.2		12+84.7						
13+0	123.14	115.80	7.34			13+09.7						
						13+34.7						
						13+57.7						
						13+82.9						
14+0	124.94	115.90	9.04			14+06.7						
						14+30.7	#1371		2558 N. Mkt.		10-28-43	
15+0	125.00	116.00	9.00	15+28		15+09.7						
					South East	North West						
0+0	123.14	115.95	7.19		0+22.6							
					0+47.0							
					0+72.0							
1+0	124.94	116.00	8.94		0+99.0							
					1+24.0							
					1+49.3			#4449	2531 N. B'way		3-14-53	
					1+75.0			#436	2521 N. B'way		4-30-30	
2+0	125.54	116.05	9.49		~~1+99.0~~ 2+04.5			#14248 435	2519 N. B'way		4-30-30	
					2+22.0							
				2+51.5	2+45.3							

Alter, Repair or Reconstruct S.S. Siphon on SS #20
at Market St. Bridge & West Drain Chisholm Creek

1+52	126.76	114.61	12.2	1+52
1+72		106.43		
2+55		106.43		
2+76	127.36	115.11	12.3	2+76

#2656 - Tap - 2505 N. Market - 9-8-42 - LaFay - Lerl Pltg. #B5004 - 1/28/66 - LaJoy Pltg. (6+50.6)
2990 - Tap - 2457 N. Market - 11-7-56 - Arlice Fay
8833 Tap 2554 N. Market Joe McDonald 10-17-58 13+51.2
#8699 Tap 2521 N. Broadway - George's Plbg. Service 1-20-64 (1+55.5)