LAT. F - DIST. T - S.S. NO. 20
DOBSON & HUMPHREY
1930

Sanitary sewer Easements
Recorded 11/20/01
20' x 103.8' (old vac Alley)
See also Book
I-122

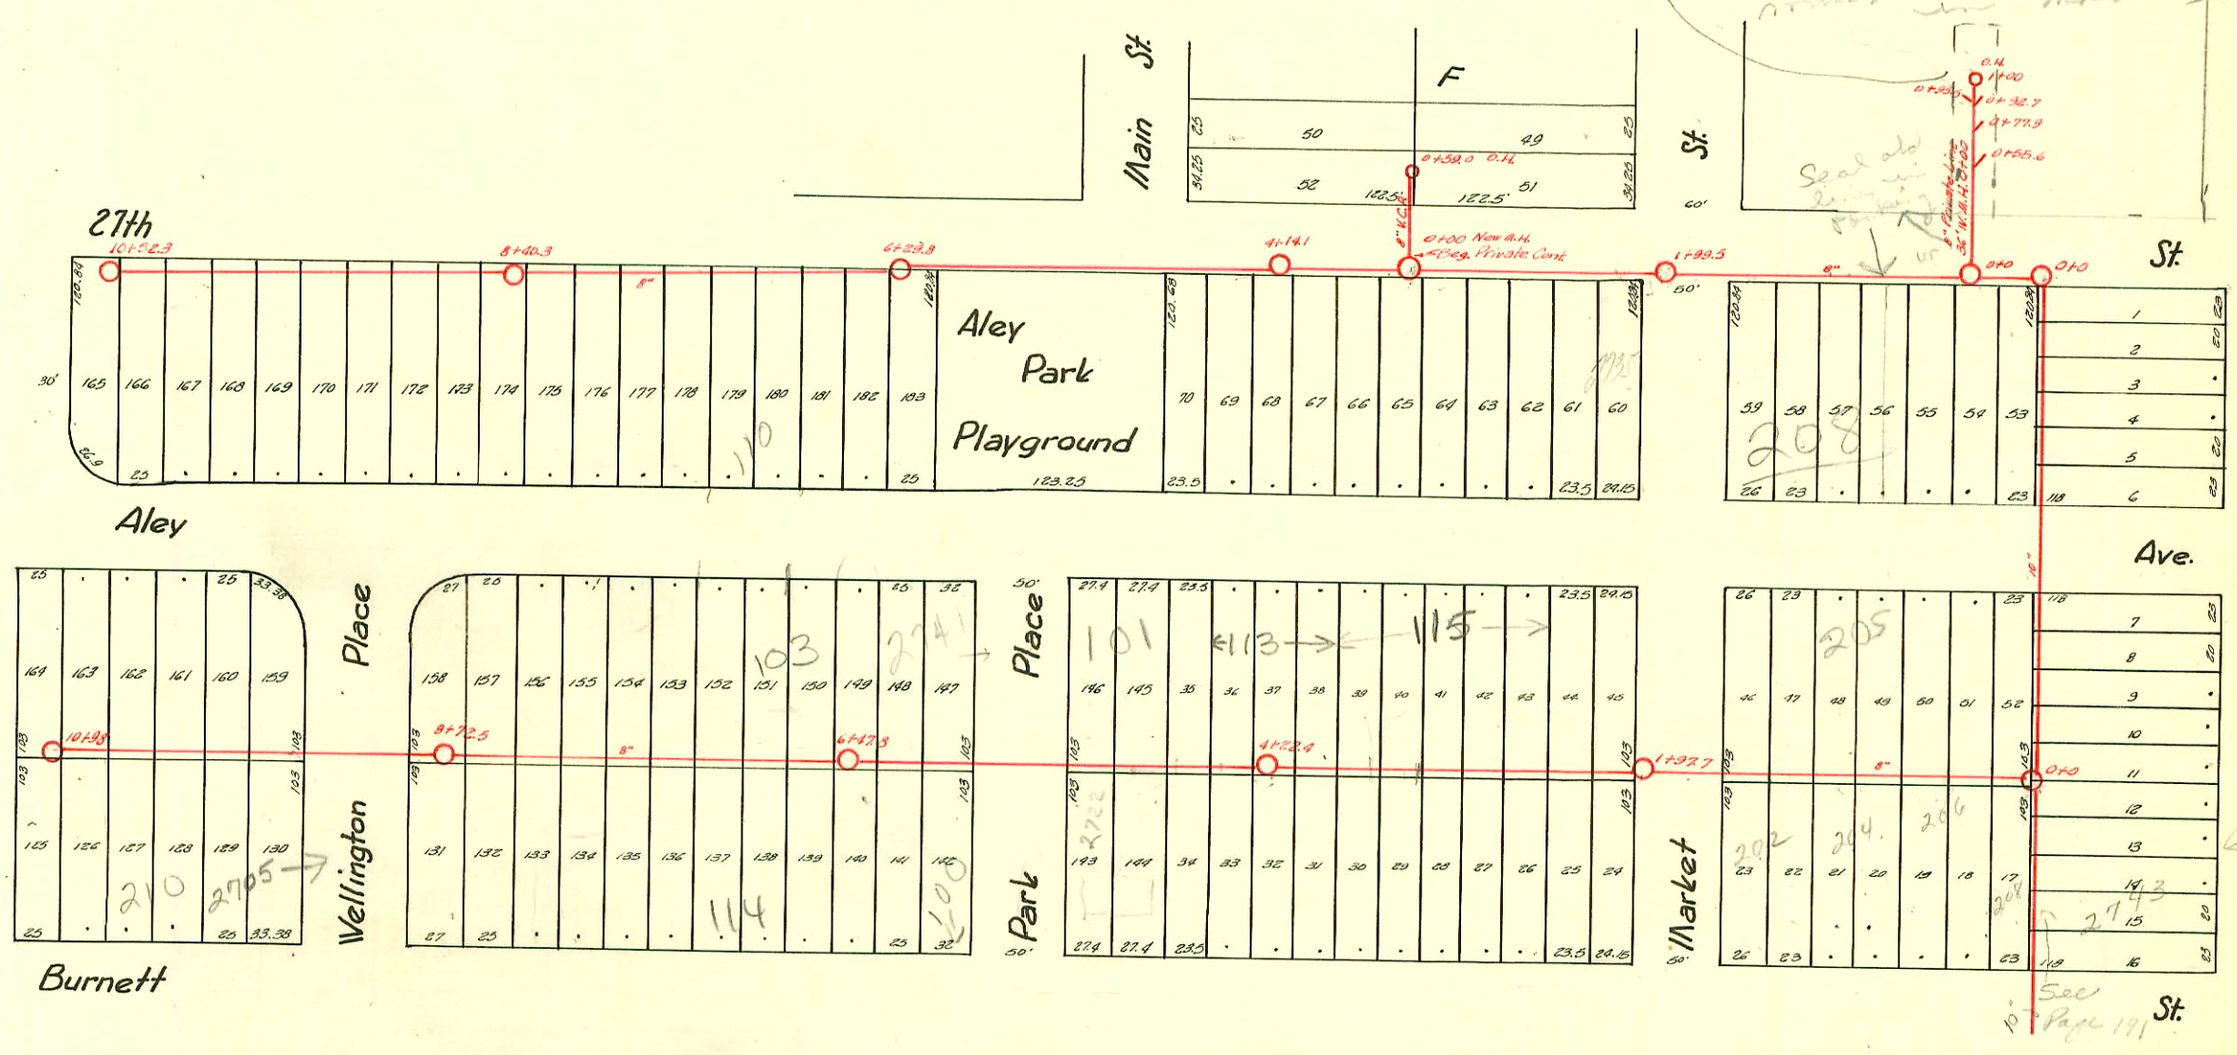

SCUR 2004-01824 6/30/04 114 W Burnett A E Henning

2959 - Tap - 2701 N. Market - Al Henning - 3-13-57
#15268 - tap - 2931 Park Place - 3-8-62 - Al Henning (6+06.8)
15424 - tap - 2935 Wellington Pl - 4-4-62 Bowers Bldg. (9+93.5)
#16161 - tap - 110 W. Aley - 10-23-62 - La Joy Bldg. Co. (6+82.8)
#16669 - tap - Trailer - 100 W. Aley - 2-18-63 Maxwell Williams (7+97.3)
#17372 - tap Trailer 109 W Aley 8-9-63 Phillipps (5+86.8)
#B5625 - tap - 107 W. Aley - 5-12-66 Ben Lee (7+50.8)
3229 R 100 W Aley 5-1-81 Sewer 6+29.8 E (wye R 46.0 E - 5+83.8)
#18896 R 8/18/87 - 102 W. Aley - (Tied into existing 4" cast iron trap - New Mobile Home)
#91-32527-7 9/16/91 - 100 W. Burnett - Henning - S10 46' W of MH and 2' off Main)
#93-8437-7 4/7/93 - 209 E. Aley - S/O 4" Clay 61' W of MH
1999-00852 - 10/25/99 - 113 Aley - McClungs - 4" SCH40 Tied back to wye for 2nd KICK - 2 KICK OUTS

D-192

Form 41-(54) 12-54

CONSTRUCTION RECORD / SERVICE RECORD

STATION	ELEVATION Ground	ELEVATION Grade	Depth	MANHOLE	4-INCH "Y" BRANCHES North West	4-INCH "Y" BRANCHES South East	No. of Permit North West	No. of Permit South East	House Number North West	House Number South East	DATE OF PERMITS North West	DATE OF PERMITS South East
0+0	128.07	117.45	10.62	0+0		0+81						
						0+38.6						
						0+63.7						
						0+88.5		#2570		204 E. Aley		1-9-46
1+0	127.69	117.55	10.14			1+11.1						
						1+36.1						
						1+61.1						
2+0	126.72	117.65	9.07	1+99.5		2+28.6		3959		2701 Market		3-8-57
						2+54.1 ✓		10962		2735 Market		7-20-59
						2+78.1						
3+0	127.50	117.75	9.75			3+03.5						
						3+28.7						
						3+51.3		#176		116 E. Aley		2-23-52
						3+75.5						
4+0	126.54	117.85	8.69			4+00.3						
				4+14.1		4+25.6						
						4+50.1		#2272		106 E. Aley		10-31-49
						4+75.2						
5+0	125.56	117.95	7.61			5+00.1						
						5+24.9		#3758		102 E. Aley		1-13-53
						5+50.1						
						5+75.1		#5100		100 E. Aley		6-6-55
6+0	125.46	118.05	7.41			5+99.8		#7082		102 E. Aley		12-1-53
				6+29.8		6+26.1						
						6+48.1						
						6+73.7						
7+0	125.01	118.15	6.86			6+98.8						
						7+23.1						
						7+48.9						
						7+73.2						
8+0	124.44	118.25	6.19			7+98.4						
						8+23.5						
				8+40.3		8+47.1		C2239		126 W. Aley		3-15-67
						8+74.6						
9+0	122.05	118.35	3.70			8+99.6						
						9+23.5						
						9+49.6						
						9+75.1		#2398 #1868		218 W. Aley		9-16-50 4-23-47
10+0	122.22	118.45	3.77			9+98.6						
						10+23.1						
10+52.3	127.02	118.51	8.51	10+52.3		10+46.1		#2191		222 W. Aley		3-15-49
0+0	125.74	117.20	8.79	0+0	0+20	0+17.5	#745	#2569	208 W. Aley	208 E. Baylees BURNETT	7-1-49	1-9-46
					0+48.7	0+46.2						
					0+72.5	0+70						
1+0	125.56	117.30	8.51		0+98	1+04.0 ~~0+95.5~~	S0	C4036		214 E. Burnett		8-1-73
					1+00 ~~1+23.1~~	1+20.6	30539-7 5940		205 E. Aley		7-21-92 8-8-55	
				1+97.7	1+48.1	1+45.6		#746		206 E. Burnett		7-1-49
2+0	125.07	117.40	7.92		2+28	2+25.5						
					2+50.8	2+48.3						
					2+76.5	2+74						
3+0	125.87	117.50	8.62		3+21.2	4"SCH40 saddle 3+48.7	2001-00169		115 E ALEY NE	Main rep by city	1-24-01	
					3+48 ✓	3+45.5	98 SM-7 6835		115 E. Aley		5-7-58	
					3+71.5	3+69.0						
4+0	123.97	117.60	6.62		3+92.8	3+91.3						
				4+22.4	4"SCH40 4+19.3	4+16.8	1999-00852 #2142		113 R E. Aley	see next pg	10-25-99 7-7-45	
					4+43.5	4+41						
					4+68.9	4+66.4	#4929		101 E. Aley		4-23-53	
5+0	123.62	117.70	6.17		4+94.3	4+91.8		#6674		2722 Park Place		10-12-53
					5+19.5	5+17						
6+0	124.02	117.80	6.57		5+92.5	5+90	Sold B5633		101 N. Aley		5-13-6	
					6+17	6+14.5	#1784		2741 Park Place		8-21-39	
				6+47.8	6+41.5	6+39						
					6+64.5	6+62.0 63.6		C38093 #4543		106 W. Burnett		4-5-73 3-20-53
7+0	124.35	117.90	6.70		6+96.8	6+94.3						
					7+21.9	7+19.4						
					7+46	7+43.5						
					7+71.2	7+68.7						
8+0	125.31	118.00	6.56		7+95.5	7+93.0						
					8+21.1	8+18.6						
				8+72.5	8+40.5	8+38	#5531		~~119~~ 127 W. Aley		6-17-53	
					8+66.1	8+63.6	#547		2726 Wellington		6-20-49	
9+0	124.76	118.10	6.66		8+91.5	8+89						
					9+58.5	9+56		#53		2728 Wellington Pl		2-10-54
					9+83	9+81.5						
10+0	125.02	118.20	6.82		10+09.5	10+07		2400		210 W. Burnett		1-15-81
					10+33	10+31.5						
					10+64.9	10+62.4						
11+0	124.09	118.30	5.79	10+98	10+89.9	10+87.4						
0+0	126.5	117.88	8.60	0+00 New M.H.	0+52.0 (6" Y's)	0+49 (6" Y's)						
	127.2	118.00	9.20	0+59=O.H.		0+55.0 (6" Y's)						

#5940-Tap-203 E. Aley-Goulding Plbg.-8-8-55
#1826-Tap-124 W. Aley-8-25-54-LaFay
#1317-Tap-216 W. Burnett-6-23-54-Reynolds
#1318-Tap-210 W. Burnett-6-25-54-Reynolds
#1962-Tap-120 W. Burnett-9-13-54-Art Prosser
#7295-Tap-203 W. Aley-12-31-53-La Fay

#6388-Tap-101 E. 27th St.-9-9-53-Layton
#5347-Tap-201 E. Aley-5-25-53-Farrell
#3557-Tap-2740 Park Place-12-18-52-Layton
#4592-Tap-206 E. Burnett-5-8-51-Dunaway
#1623-Tap-2753 N. Broadway-6-5-39-McLaughlin
#861-Tap-2803 N. Broadway-1-13-42-Hendricks-Special Fee $25.00
9/7/77 Sold off C62908-Tunley

#546-Tap-2736 Wellington Place-6-20-49-J.V. McLee
#3402-Tap-206 E. Aley-2-21-50-LaFay
#3631-Tap-202 E. Burnett-1-11-51-Kendall
#6367-Tap-209 W. Aley-11-7-55-Joe McDonald
#6260-204 E. Burnett-Coleman-9-6-55
#3480-Tap-2735 Wellington-1-7-57-Reynolds