D 213 A

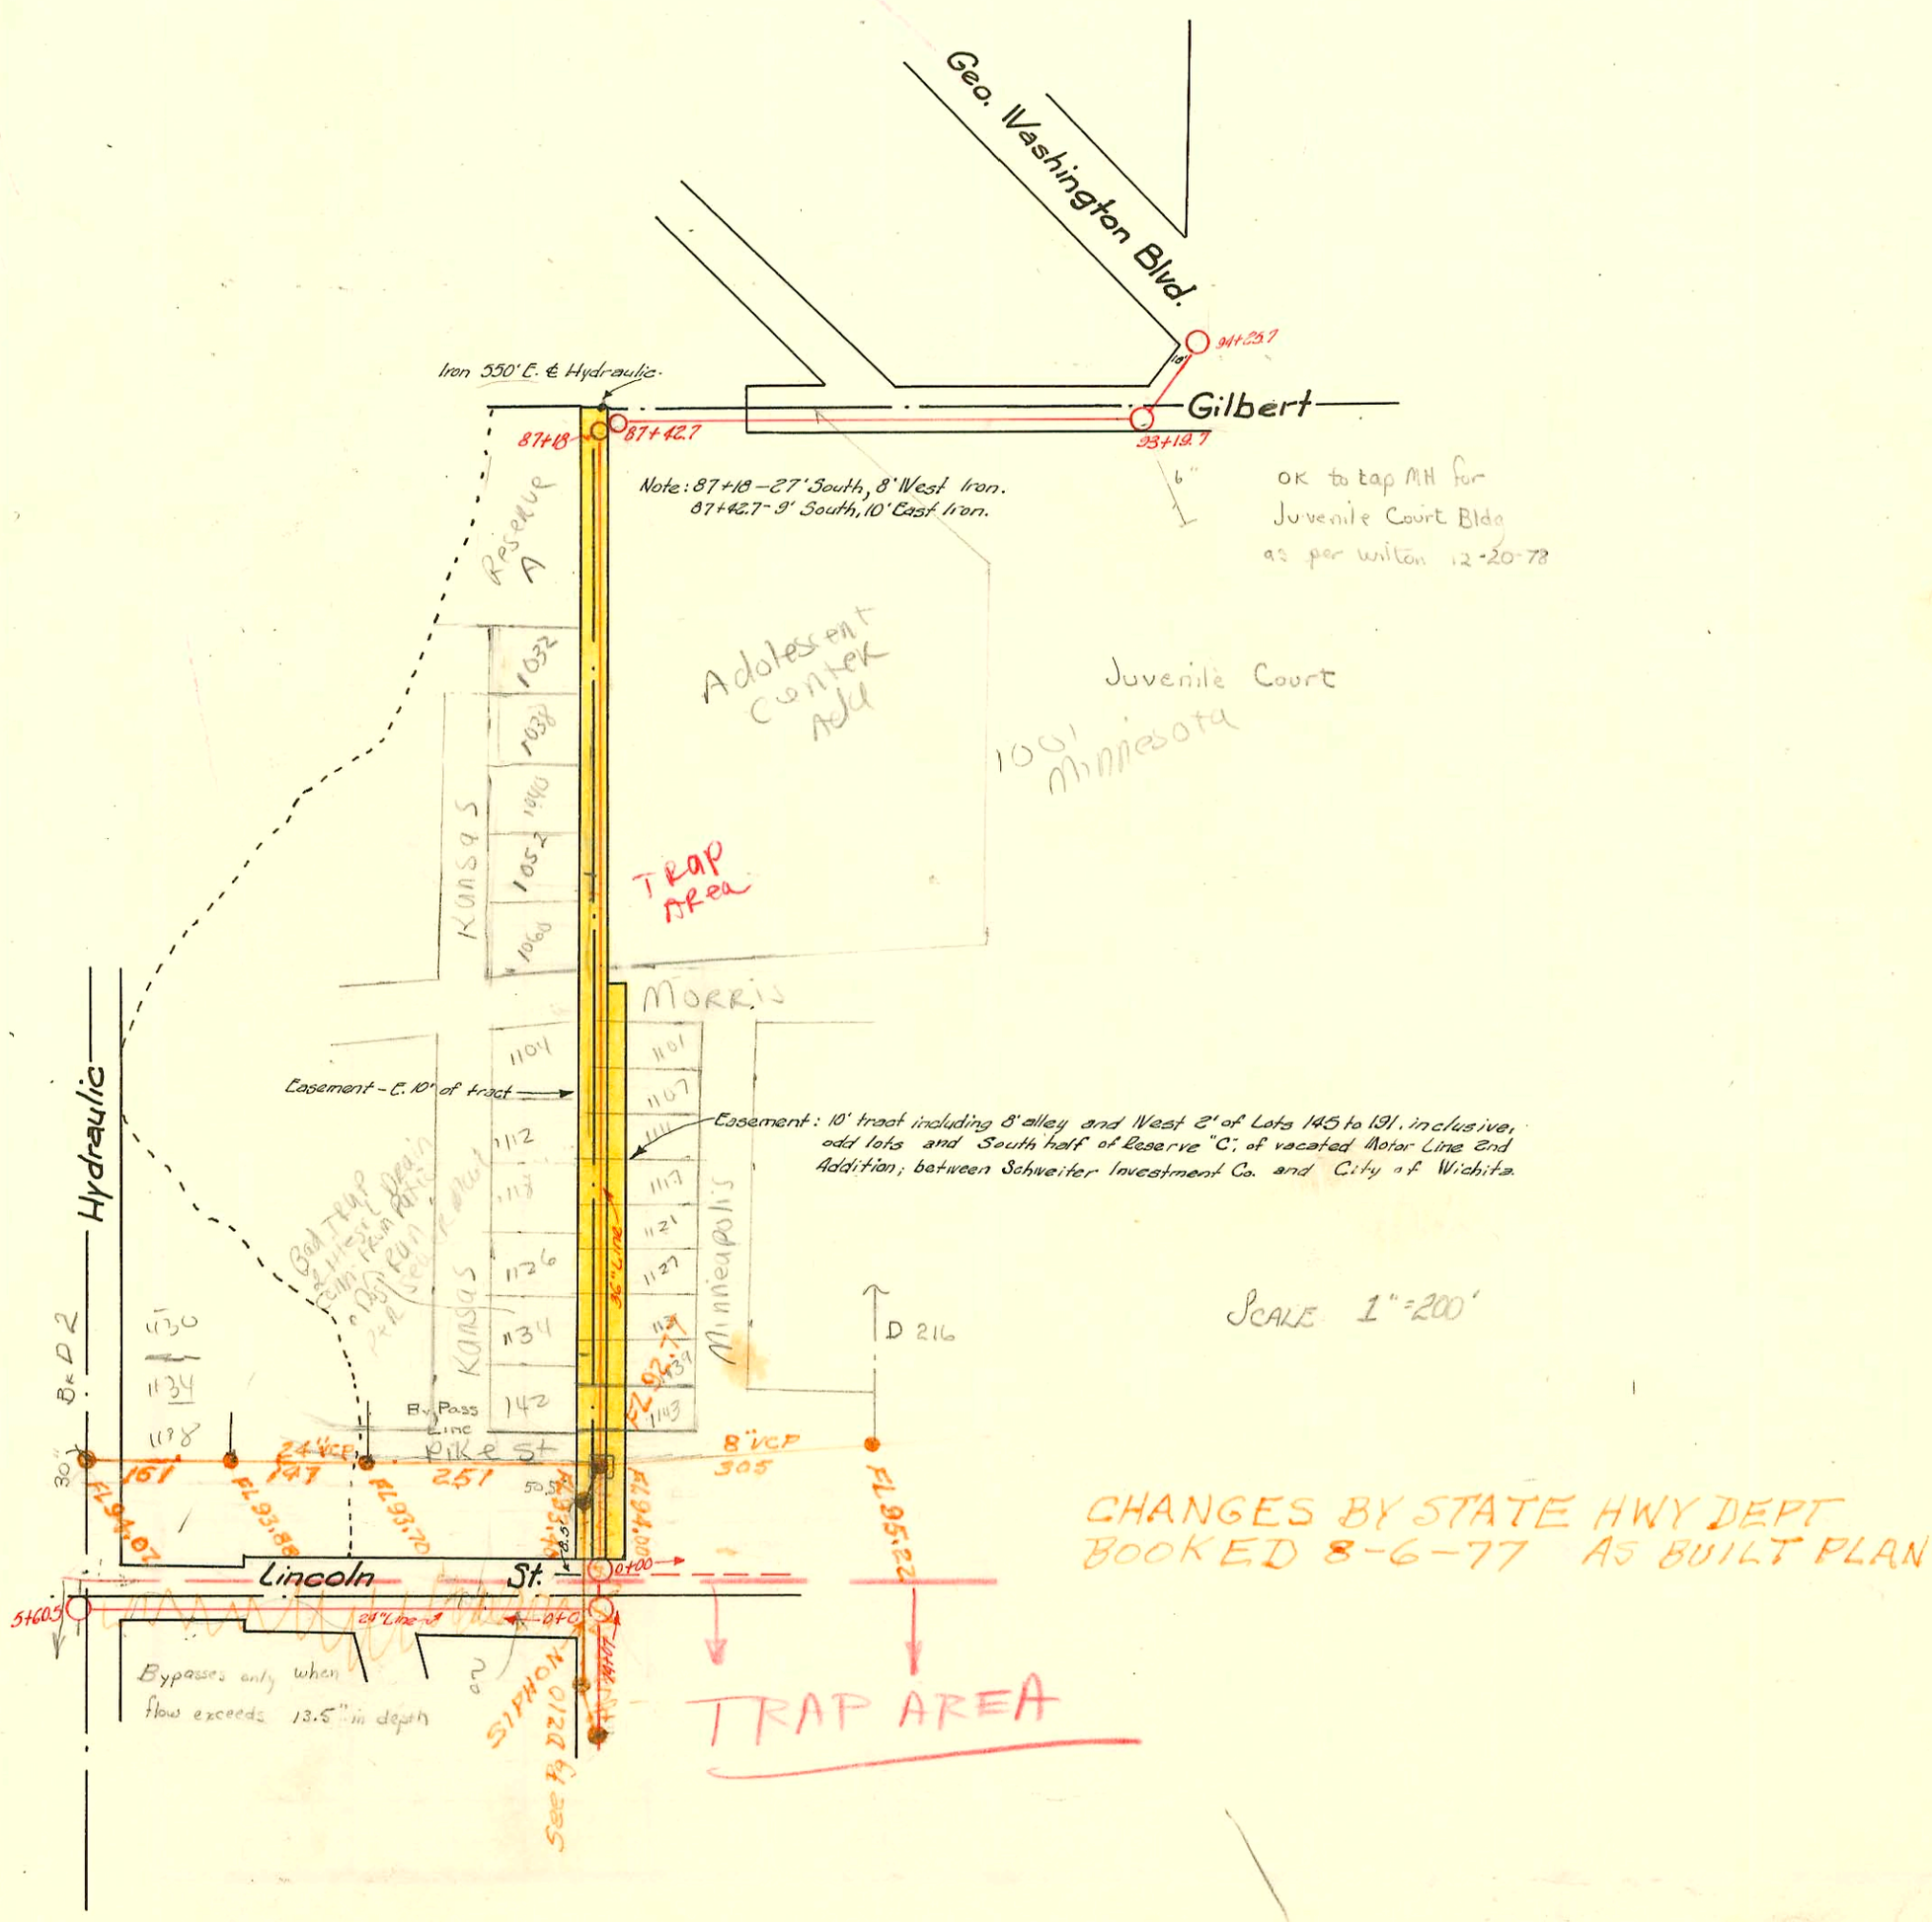

CHANGES BY STATE HWY DEPT
BOOKED 8-6-77 AS BUILT PLAN

D-213

Form 41-(54) 12-54

CONSTRUCTION RECORD							SERVICE RECORD					
STATION	ELEVATION		Depth	MANHOLE	4-INCH "Y" BRANCHES		No. of Permit		House Number		DATE OF PERMITS	
	Ground	Grade			North West	South East	North West	South East	North West	South East	North West	South East
24" cross connection from Hydraulic East to 36" Line.												
0+0		92.25		0+0 (74+07)								
1+0		92.53										
2+0		92.79										
3+0		93.05										
4+0		93.32										
5+0		93.59										
5+60.5		93.75		5+60.5								
36" V.C.P. Line from Lincoln North												
74+07.0				74+07.0		(74+47.0)						
					74+65.5	74+68.5						
					74+90.5	74+~~93.5~~ 82.0	# 1582	#217825 3204	1156 S. Kansas	1157 S. Minneapolis	3-10-47	2-2-70 3-20-41
					75+15.5	75+18.5		#223157 480	1153 1159 S.	Minneapolis		3-8-71 10-25-41
75+0	102.86	92.36	10.50		75+~~40.5~~ 24.0	75+43.5	# 34682 1583		1148 S. 5.0 Kansas		5-9-5-22 3-10-47	
					75+65.5	75+68.5						
					75+90.5	75+93.5						
76+0	105.06	92.44	12.62		76+15.5	76+18.5	# 1028		1142 S. Kansas		12-3-46	
					76+40.5	76+43.5						
					76+65.5	76+68.5		# 3365		1137 S. Minneapolis		4-23-41
					76+90.5	76+93.5	#98 10477 1043		1134 R S. Kansas	1131 S. Minneapolis	1-26-41 12-4-46	
77+0	105.26	92.52	12.74		77+15.5	77+18.5		# 239				9-29-41
					77+40.5	77+43.5						
					77+65.5	77+68.5		# 3345		1121 S. Minneapolis		4-18-41
					77+90.5	77+93.5	# 1821	# 3570	1126 S. Kansas	1127 S. Minneapolis	4-15-47	6-4-41
78+0	105.06	92.60	12.46		78+15.5	78+18.5						
					78+40.5	78+43.5						
					78+65.5	78+68.5	# 1750	# 3975	1118 S. Kansas	1117 S. Minneapolis	4-7-47	8-7-41
					78+90.5	78+93.5						
79+0	105.46	92.68	12.78		79+15.5	79+18.5		96-5567		1111 S Minneapolis		7-17-96
					79+40.5	79+43.5	#30 1192 1749	# 245	1112 S.R Kansas	1109 S. Minneapolis	9-5-80 4-7-47	9-30-41
					79+65.5	79+68.5						
					See Below 79+90.5	79+93.5	#96-19147 1630	# 237	1104 S.R Kansas	1107 S. Minneapolis	2-22-96 3-18-47	9-27-41
80+0	105.46	92.76	12.70		80+15.5	80+18.5						
					80+40.5	80+43.5		# 244		1103 S. Minneapolis		9-30-41
81+0	103.66	92.91	10.75		81+25.0							
					81+50.0							
					81+75.0							
82+0	103.03	92.99	10.04		82+00.0		#1445 305		1052 S. Kansas		8-8-85 6-27-47	
					82+25.0		# 1629		1060 S. Kansas		3-18-47	
					82+50.0							
					82+75.0		# 304		1046 S.R Kansas		6-27-47	
83+00	102.83	93.07	9.76		83+00.0							
					83+25.0							
					83+50.0							
					83+75.0		# 29		1038 S. Kansas		5-14-77	
84+00	102.83	93.15	9.68		84+00.0							
					84+25.0							
					84+50.0							
					84+75.0							
85+0	103.53	93.23	10.30		85+25.0							
					85+50.0							
					85+75.0							
86+0	103.53	93.31	10.22		86+00.0							
					86+25.0							
					86+50.0							
					86+75.0							
87+0	102.93	93.39			87+00.0							
	103.00	93.40		87+18.0								
	104.50	93.43		87+42.7								
88+0	103.83	93.47										
89+0	103.80	93.55										
90+0	104.20	93.63			6" Y 90+52	6" ABS tap			connection to County Home.			
91+0	104.60	93.71				91+47.1		C 69935		1001 S See Below Minnesota		12-21-78
92+0	105.50	93.79										
93+0	105.25	93.87										
		93.88		93+19.7		MH tap was 510 + Refuted Refer to Ref MH C 69935 above		?		1001 S. Minnesota		?

Sheet 4
C-36466 - 11475. Minneapolis - Al Hennen - 12-27-72 105+57

#3170 - Tap - 11475. Minneapolis - 3-5-41 - Harley Riggs
#2625 - Tap - 1902 C. Gilbert - 9-21-42 - Wichita Plbg. Co.
#628 - Tap - 1001-3 } - 10-9-73 - Rutledge
#629 - Tap - 1007-9 } S. Minneapolis - 8-20-47 - Frederick Plbg. Co. - 8-16-73 - C.L. Rutledge
#630 - Tap - 1013-15 } - 7-6-73 Henning
#631 - Tap - 1019-21 } - 7-6-73 Henning

C41583
C40476
C39905
C39906

97-14983 B 9-29
96-19197 2-22-96 1104 S. Kansas - wye 420' N of a MH - 4" SDR35 last 10' is 4" Sch 40
1-4" tap installed

97-10457-7 7-2-97 1104 S. Kansas - Boardman -

93-27493-7 10-25-93 R 1001 S. Minnesota - Bldg Addt
4" PVC 40 tied to exist 6" ABS Bldg sewer
12' N of new addition and 245' ± of a MH.