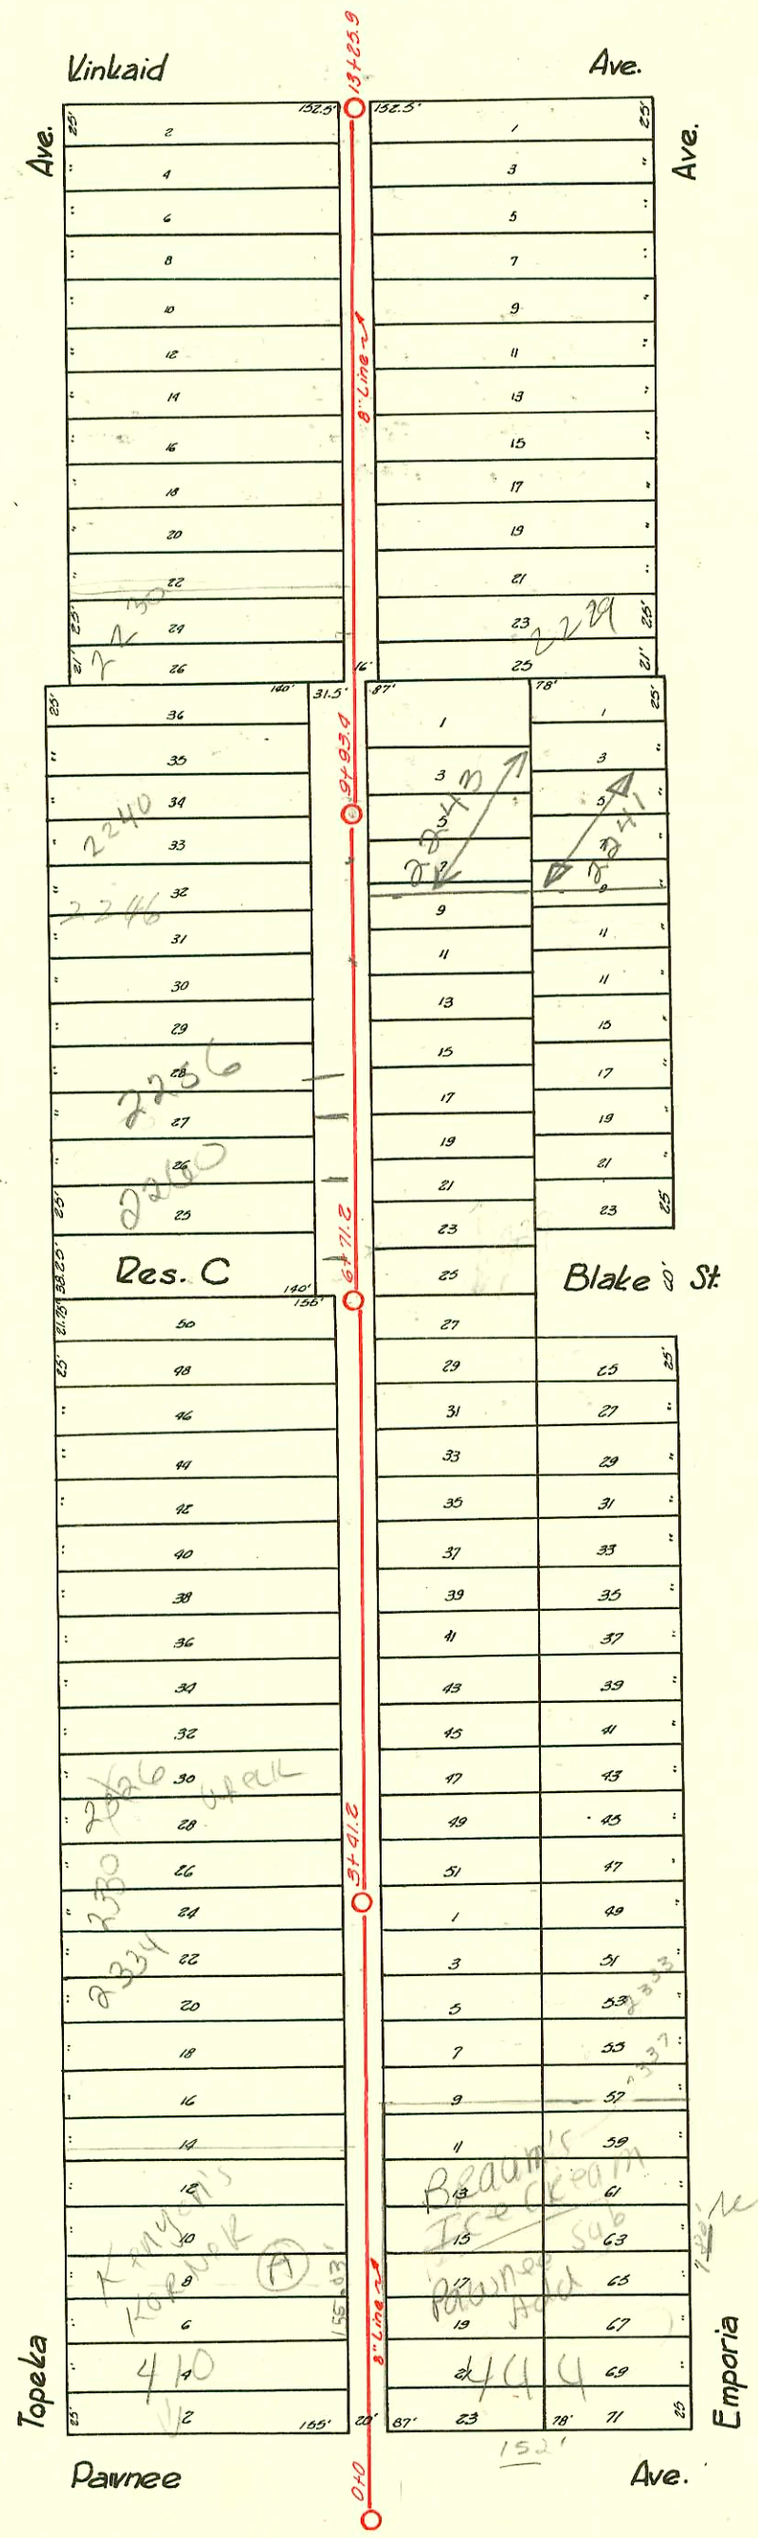

LAT. N- DIST. B- S.S. # 20
W. B. CARTER-1942

D239

Form 41-(54) 12-54

CONSTRUCTION RECORD / SERVICE RECORD

STATION	ELEVATION Ground	ELEVATION Grade	Depth	MANHOLE	4-INCH "Y" BRANCHES North West	4-INCH "Y" BRANCHES South East	No. of Permit North West	No. of Permit South East	House Number North West	House Number South East	DATE OF PERMITS North West	DATE OF PERMITS South East
0+0	98.2	88.8	9.4	0+0	0+28.5 TAP		20559		410 E. Pawnee		4/07/88	
					0+61.4	0+58.4						
					0+87.2	0+84.2						
1+0	98.6	88.9	9.7		1+11.4	1+08.4						
					1+35.9	1+32.9	#20393 2945		2346 S. Topeka	see below	4-4-88 4-1646	
					1+60.0	1+57.0						
					1+86.0	~~1+83.0~~ 1+81.0 TAP		20379		444 E. Pawnee Beaumont Ice Cream		3-31-88
2+0	98.3	89.0	9.3		2+10.7	2+07.7						
					2+35.6	2+32.6	#341		2342 S. Topeka		7-1-46	
					2+60.4	2+57.4		#541		2333 S. Emporia		4-7-54
					2+85.9	2+82.9		#457		2339 S. Emporia		6-8-49
3+0	98.5	89.1	9.4		3+00.5	3+03.5	#1540					
					3+35.9	3+32.9	#699	#2603	2330 S. Topeka	2332 S. Emporia	9-23-46	11-29-49
				3+41.2								
					3+56.1	3+53.1		#54.54		2307 S. Emporia		8-6-51
					3+84.3	3+81.3	#2602		2306 S. Topeka		1-22-46	
4+0	98.5	89.2	9.3		4+09.7	4+06.7						
					4+35.8	4+32.8		#1664		2323 S. Emporia		7-17-50
					4+61.0	4+58.0	#1951		2322 S. Topeka		5-5-47	
					4+86.8	4+83.8	#1348	#346	2318 S. Topeka	2317 S. Emporia	10-25-48	7-1-46
5+0	98.4	89.3	9.1		5+10.3	5+07.3						
					5+35.3	5+32.3	#1347	#2306	2312 S. Topeka	2311 S. Emporia	10-25-48	3-18-49
					5+58.9	5+55.9		#1833		2307 S. Emporia		4-17-47
					5+86.5	5+83.5	#1346		2306 S. Topeka		10-25-48	
6+0	98.8	89.4	9.4		6+11.8	6+08.8						
					6+43.7	6+40.7		#2305		2303 S. Emporia		3-18-49
					6+66.4	6+63.4	#1259		2300 S. Topeka		1-14-47	
				6+71.2								
					6+93.1	6+90.1	#171		2254 S. Topeka		1-13-43	
7+0	98.6	89.5	9.1		7+19.2	7+16.2						
					7+37.5	7+40.5	#2062	#1192	2250 S. Topeka	2259 S. R	6-12-42	11-24-47
					7+68.3 4" Bve CO	7+65.3	#2473		2256 S. Topeka R		10-16-02 8-5-42	
					7+93.2	7+90.2	#2474	#1193	2250 S. Topeka	2253 S. Emporia	8-5-42	11-24-47
8+0	99.2	89.6	9.6		8+17.4	8+14.4						
					8+43.3	8+41.3	#2475		2246 S. Topeka		8-5-42	
					8+68.0	8+65.0		#1145		2247 S. Emporia		11-19-47
					8+94.0	8+91.0						
9+0	99.5	89.7	9.8		9+18.9	9+15.9	#2141	2000-02753 #1427	~~2240~~ S. Topeka	2241 S. R	6-24-42	12-19-00 1-12-48
					9+44.8	9+41.8						
					9+69.5	9+66.5	#10359 1616		2234 S. Topeka R		4-29-42	
					9+88.9	9+85.9						
				9+93.4								
10+0	99.2	89.8	9.4		10+19.9	10+16.9	#1023	96-58567 #2193	2230 S. Topeka	2229 S. Emporia	7-26-49	4-27-96 7-31-43
					10+45.7	10+42.7						
					10+65.9	10+62.9						
					10+91.4	10+88.4	#2471	#2054	2222 S. Topeka	2225 S. Emporia	8-5-42	5-14-45
11+0	99.5	89.90	9.6		11+15.6	11+12.6						
					11+39.7	11+36.7		#2481		2215 S. Emporia		11-15-49
					11+66.1	11+63.1	#2514		2212 S. Topeka		8-14-42	
					11+87.6	11+84.6	#1536	#4339	2210 S. Topeka	2211 S. Emporia	5-13-44	3-2-53
12+0	99.8	90.0	9.8		12+11.0	12+08.0		#1630		2207 S. Emporia		6-29-44
					12+34.5	12+37.5		#2079		2205 S. Emporia		5-31-45
					12+63.9	12+60.9	#1617		2208 S. Topeka		4-29-42	
					12+88.0	12+85.0	#702	#3687	2202 S. Topeka	425 E. Kinkaid	6-10-43	7-1-53
13+0	100.0	90.1	9.9		13+12.9	13+09.9						
	99.9	90.13	9.77	13+25.9								

Sur 2001-01681 7-10-01 2240 S. Topeka Leon Shallup - No Msmt - 4" SCH40 - 1 1-way CO, 1 TWIN CO, 2 Ferrco / Replaced pipe to 35' from main

2000-02752 - 2243 S Emporia - 12/19/00 - Roto Rootr

#1611-Private Line-2234½ S. Topeka-3-17-47-Cherry Plbg. Co.
#2707-Tap-2233 S. Emporia-9-27-52-Joe McDonald
#3098-Tap-2312 S. Topeka-S & B Plbg.-1-6-54

41 20393 - 2346 S Topeka Sealed off from Main 183', N of MH and 8' from cyc