D272 A

LATERAL 64 WESTLINK SEWER
BUILT BY: UTILITY CONTR. INC
PROJ. Nº 468-76-245-80650-000-000-001
BOOKED 9-7-79 FROM 264Y

on mop

Hold for TV

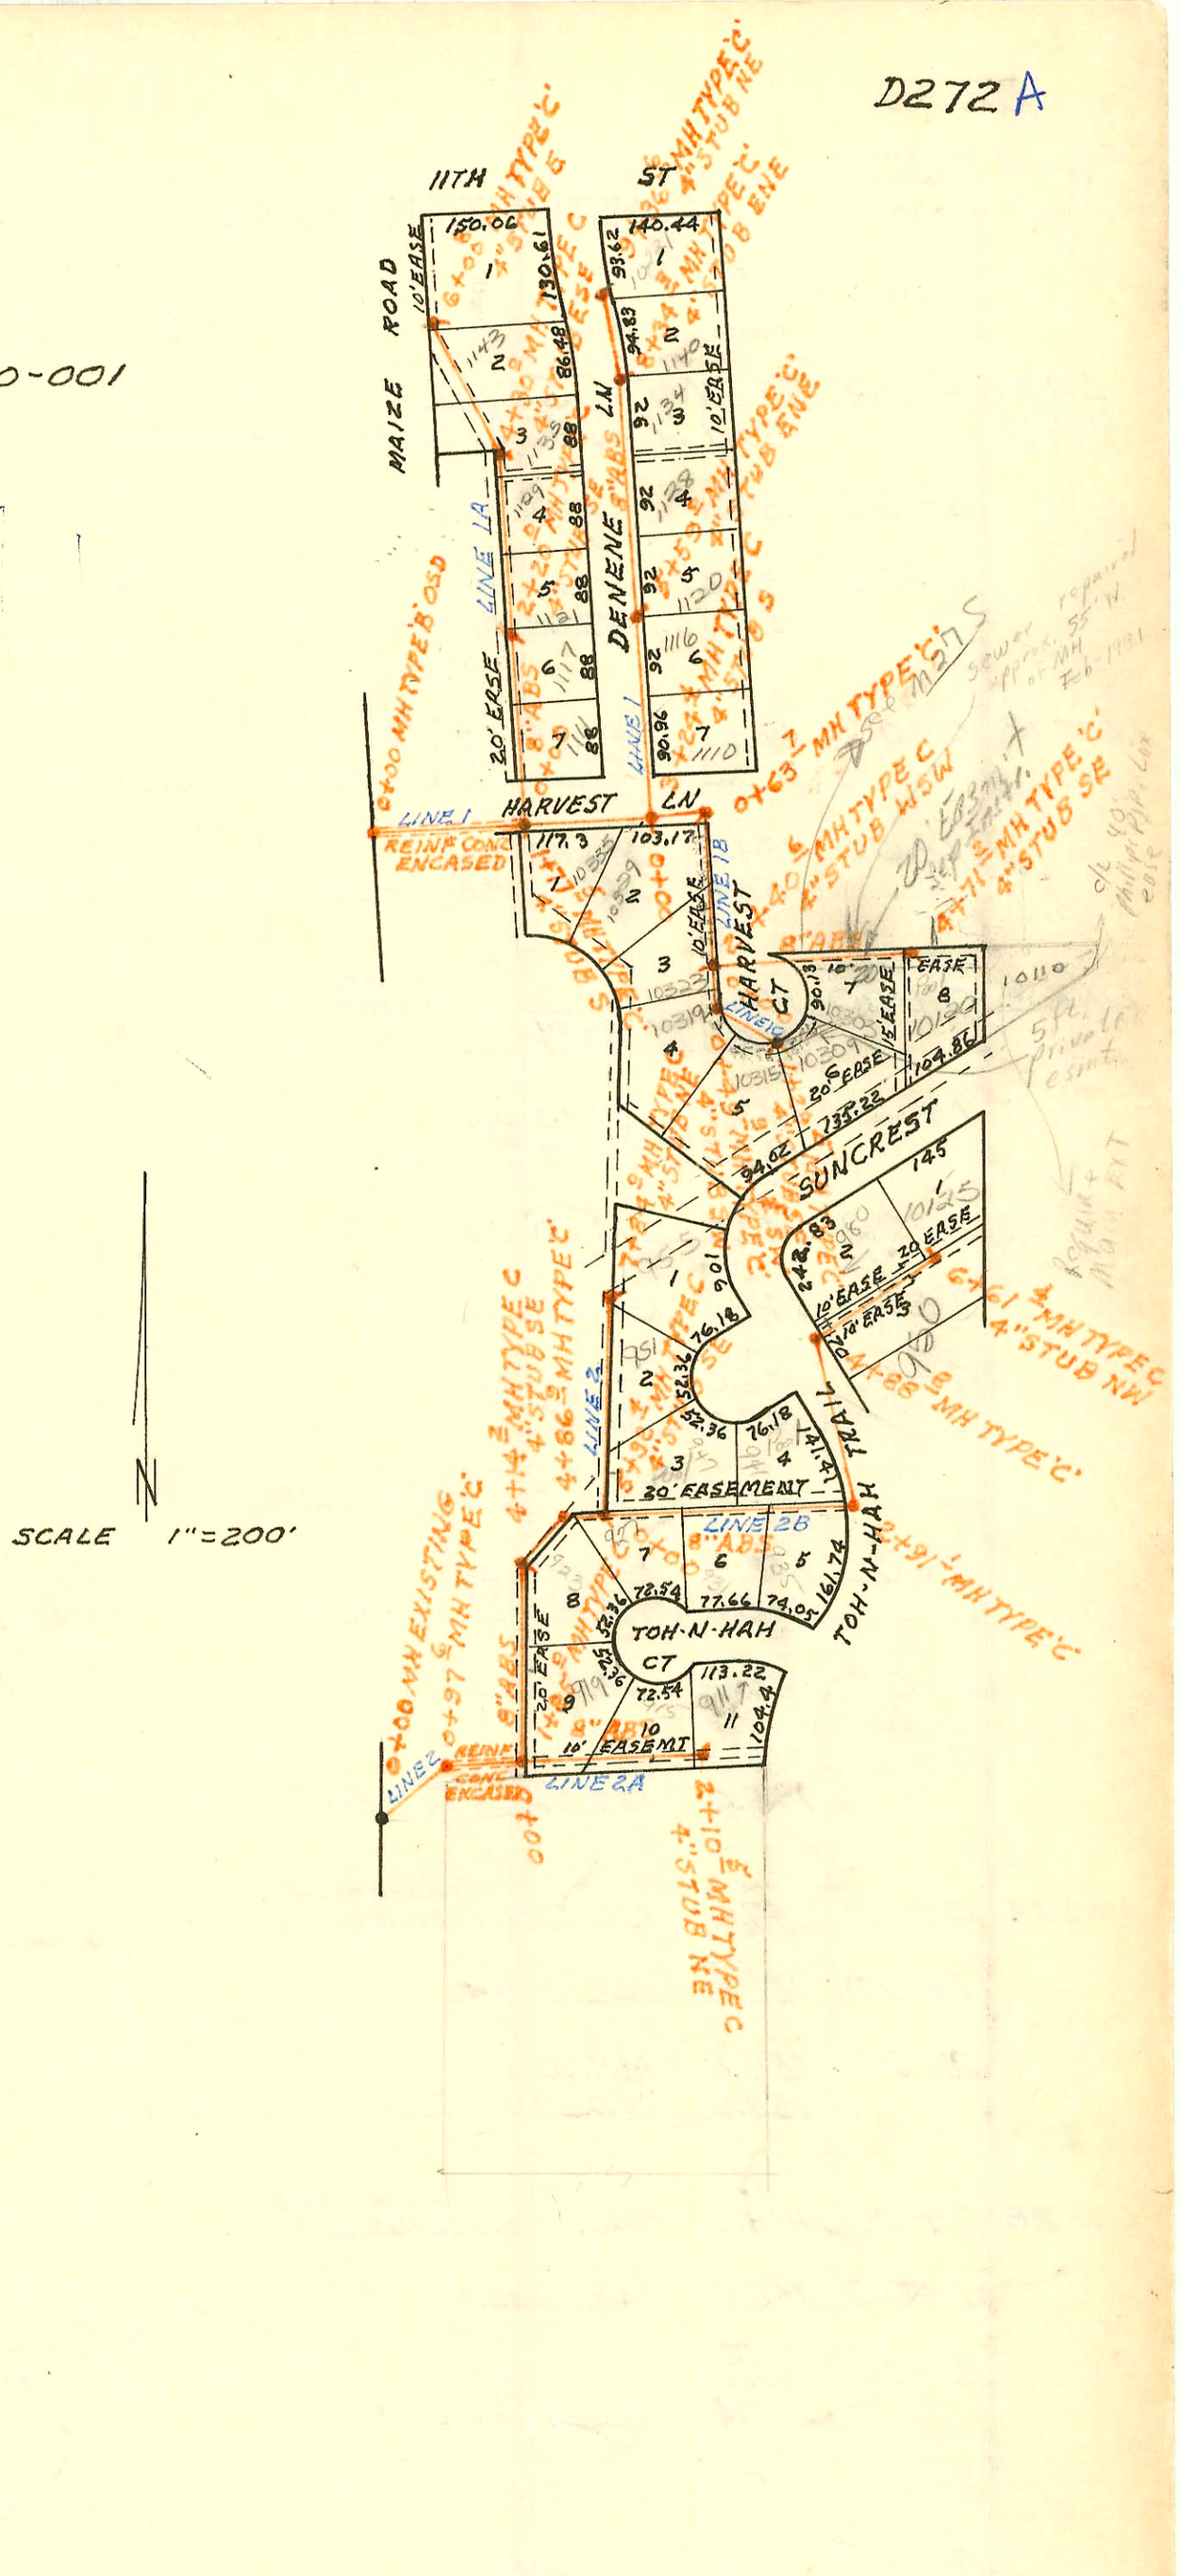

SCALE 1"=200'

D272

Form 42-020

CONSTRUCTION RECORD

SERVICE RECORD

	STATION	ELEVATION Ground	ELEVATION Grade	Depth	MANHOLE	4-INCH "Y" BRANCHES North West	4-INCH "Y" BRANCHES South East	No. of Permit North West	No. of Permit South East	House Number North West	House Number South East	DATE OF PERMITS North West	DATE OF PERMITS South East
LAT 107 SWI CONT'D													
	7+00	155.2	149.0	6.2									
		155.2	149.05	6.1									
		155.2	149.15	6.1	7+02.7								
	8+00	155.7	149.54	6.2									
	9+00	156.6	149.94	6.7									
	10+00	158.0	150.34	7.7		4" SDR 35 9+36.7	9+40.6 tap	96-6961-7	#790	11021 Westport	11804 Parkdale	5-8-96	7-18-80
		158.2	150.40	7.8	10+17.6		10+33.6 tap	96-8495-7	#00 789	11017 Westport 11013 Westport	11108 W. 17th	6-26-96 1-697	7-18-80
	11+00	159.4	151.68	7.7		4" SDR 35 11+22.6 4" S.D.R 35 11+73.2	11+15.1 tap	97-1105-7 95-1877-7	336	11809 Westport 11805 Westport	11102 W 17th 11028 W 17th	11-1-95 7-2494	5-19-80 5-19-80
							11+71.4 tap	94-12587	335				
	12+00	161.2	153.18	8.0			12+65.8 tap	95-1870-7	#334	11001 Westport	11024 W 17th	11-1-95	5-19-80
	13+00	163.7	154.68	9.0									
		164.4	154.97	9.4	13+19.4	4" SDR 35 13+09.4	4" STUB SE	96-6911-7	#00333	10921 Westport	11016 W 17th	5-8-96	5-19-80
LATERAL 64 WESTLINK SEWER													
LINE 1	0+00	153.0	140.94	12.1	0+00								
	1+00	151.8	141.34	10.5									
		153.0	OUT 141.65 IN 141.75	11.4 11.3	1+77.5		4" STUB S						
	2+00	147.7	141.84	5.9			2125.5 TAP		17943		10335 Hawks Ln		3-16-87
	3+00	149.3	142.24	7.1									
		153.5	OUT 142.34 IN 142.44	11.2 11.1	3+24.4		4" STUB S						
	4+00	150.1	142.74	7.4			446.1 Tap		967		1110 Denene		8-12-80
	5+00	150.1	143.14	7.0			4773.4 Tap		13495		1116 Denene		4-17-85
		152.7	143.38	9.3	5+59.0		4" STUB ENE						
							5+96.0 Tap		19262		1120 Denene		10-7-89
	6+00	149.7	143.54	6.2			4" SDR 35 6+80.0 tap		94-5051-7		1128 Denene		4-8-94
	7+00	150.3	143.94	6.4									
	8+00	152.2	144.34	7.9			7+71.6 Tap		26030		1134 Denene		8-29-90
		152.8	OUT 144.48 IN 144.58	8.3 8.2	8+34.3		4" STUB ENE						
							8+94.1 Tap		20118		1140 Denene		2-17-88
	9+00	152.8	144.84	8.0									
		153.2	145.00	8.2	9+36.6	4" STUB NE	9+32.1 tap		14601	10221 W. 11th		8-29-85	
LINE 1A	0+00	153.0	142.27	10.7	0+00=1+77.5 LINE 1		4" SDR 35 1+30.0 tap n/c		93-23880-7		1111 N Denene		9-2-93
	1+00	149.3	142.67	6.6									
	2+00	149.2	143.07	6.1									
		150.8	143.15	7.7	2+20.0		4" STUB SE						
	3+00	147.4	143.47	3.9			4" SDR 35 3+68 TAP		92-15331-7		1129 Denone		7-23-92
	4+00	149.7	143.87	5.8									
		150.4	OUT 143.99 IN 144.09	6.4 6.3	4+30.0		4" STUB ESE OK		25547		1135 N. Denene		6-14-90
	5+00	151.7	144.37	7.3			4" SCH 40 5+14.8 Predco		20200184		1143 Denene		1-26-01
	6+00	153.6	144.77	8.8	6+00.8		4" STUB E						
LINE 1B	0+00	153.5	143.32	10.2	0+00=3+24.4 LINE 1								
		153.4	OUT 143.57 IN 143.67	9.8 9.7	0+63.7								
	1+00	151.5	143.82	7.7									
	2+00	152.2	144.22	8.0									

CONT'D NEXT PAGE

3481 Newcomb #0303 Harvest Ct Dellert Haney 6-12-81