E-7A

RECONNECTIONS

STA.	ADDRESS	DIRECTION
8+86	418 & 420 N. Oliver	WEST
9+10	424 N. Oliver, #1, 2 & 3	WEST
9+56.4	421, 423, 425 & 427 N. Bleckley	EAST
9+82.7	428 N. Oliver, #1, 2 & 3	WEST

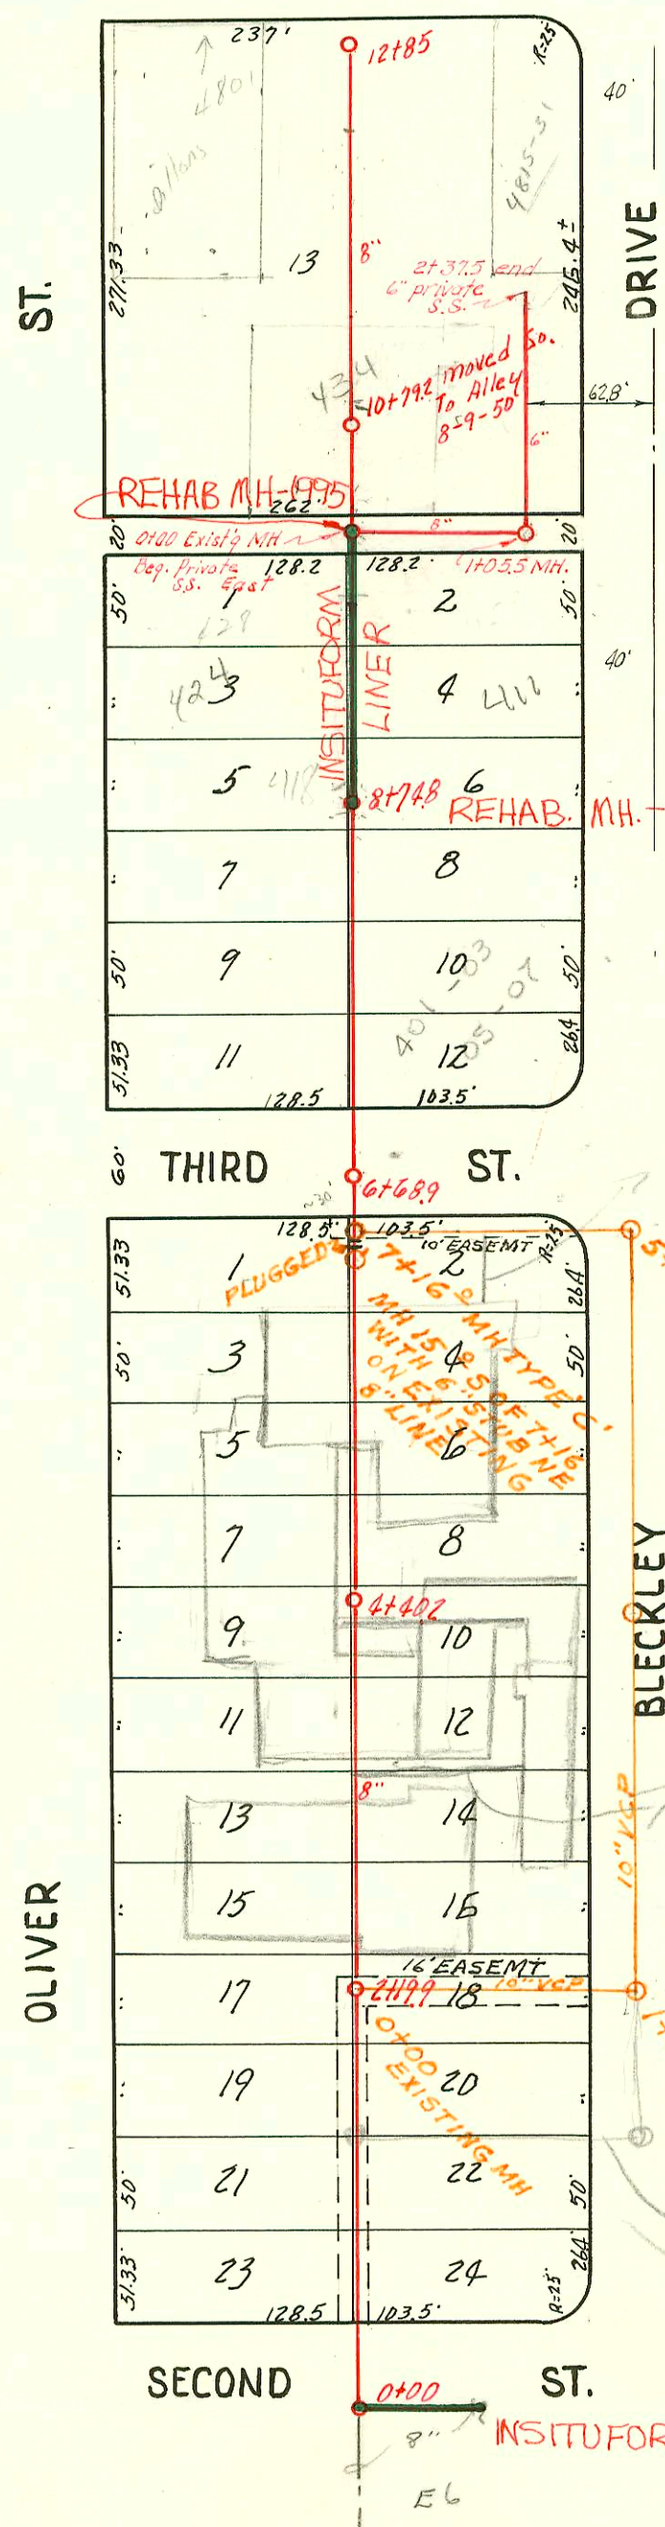

RELOCATION OF PART OF LAT J
DIST. 6 SAN SEWER Nº 12
BUILT BY: W.B. CARTER CONST. CO. INC.
PROJ. Nº DBKW 705009
BOOKED 8-25-75 FROM PLAN

SANITARY SEWER RESPONSE PLAN
PHASE IA
PROJ. NO. 468-82420 (673124)
BUILT BY INSITUFORM PLAINS, INC.
BOOKED 3-1-96 FROM AS BUILTS

2003-01328-5/6/03- 328 N Oliver- McCullough - (NE Corner of exist bldg) City Tap 68' W of MH 5+65 (6+33) 1V45 4" Predco by City
2003-01329-5/16/03- 328 N Oliver- McCullough- 4" PVC, 2W45, 1V45, 1 TWIN CO-Cast Iron - tied to private main between Bldgs

PART OF **LAT. J, DIST. 6, S. S. 12**
DOBSON-HUMPHREY-1930

C 51818 - 328 N. Oliver 10-10-95 - Tap
C 50499 - 328 N. Oliver - N.C. for Robinson Jr. High - Jack Stamps - 7-23-75
#4313 - #4314 & 4315 - Storm Water Sewer Taps Robinson School - 4-9-51 - Moore - Robertson

7

Form 41-(54) 3-51

CONSTRUCTION RECORD

STATION	ELEVATION		Depth	MANHOLE	4-INCH "Y" BRANCHES	
	Ground	Grade			North West	South East
0+0	169.06	160.25	8.8	0+0	0+46	0+43
					0+70.3	0+67.3
					0+94	0+91.0
1+0	169.46	160.65	9.01		1+21	1+18
					1+48.1	1+45.1
					1+72	1+69
2+0	171.56	160.65	10.9		1+99	1+96
				2+19.9	2+26	2+23
					2+50	2+47
					2+71.7	2+68.7
3+0	173.26	160.85	12.4		3+00.6	2+97.6
					3+25	3+22
					3+49	3+46
					3+75.9	3+72.9
4+0	174.16	161.05	13.1		3+99.2	3+96.2
					4+23.6	4+20.6
				4+40.2	4+50.2	4+47.2
					4+74.2	4+71.2
5+0	173.86	161.25	12.6		4+98.2	4+95.2
					5+25.7	5+22.7
					5+50	5+47
					5+74	5+71
6+0	174.06	161.45	12.6		6+00.5	5+97.5
				6+68.9	6+27	6+24
7+0	173.90	161.65	12.2		7+11.8	7+08.8
					7+35.8	7+32.8
					7+60	7+57
					7+86.3	7+83.3
8+0	174.30	161.85	12.4		8+10.2	8+07.2
					8+34	8+31
				8+74.5	8+60.8	8+57.8
					8+84.5	8+81.5
9+0	174.70	162.05	12.6		9+08.7	9+05.7
					9+35	9+32
					9+59.1	9+56.1
					9+83	9+80
10+0	175.00	162.25	12.7		10+10	10+07
					10+33.8	10+30.8
				10+79.2	10+57.6	10+54.6
					10+87.5	10+84.5
11+0	174.0	162.45	11.5		11+11.1	11+08.1
					11+34.9	11+31.9
					11+62	11+59
					11+85.5	11+82.5
12+0	173.90	162.65	11.2		12+09.8	12+06.8
					12+36.4	12+33.4
12+85	175.20	162.81	12.4	12+85	12+63	12+60

PRIVATE SANITARY SEWER — Bk. M. 66 — July 30, 1953

0+0	174.2	169.40	4.8	0+00 Exist'g MH.	
1+0					
	172.6	out 169.80 in 169.90	2.8 2.7	1+05.5	
2+0	173.5	170.30	3.2		
	173.5	170.46	3.0	2+37.5	

RELOCATION of PART of LAT J DIST 6 SAN SEWER Nº 12

0+00	172.5	161.32 OUT 161.37 IN	11.2 11.1	0+00 = 2+19.9 ON EXISTING LINE	
1+00	171.6	161.48	10.1		
	170.6	161.53 OUT 161.58 IN	9.1 9.0	1+50.4	
2+00	168.5	161.63	6.9		
3+00	168.0	161.74	6.3		
3+55.9	168.2	161.80	6.4	3+55.9	
4+00	168.2	161.85	6.4		
5+00	168.7	161.95	6.8		
	168.9	162.02 OUT 162.07 IN	6.9	5+65.9	
6+00	170.8	162.11	8.7		
7+00	174.5	162.21	12.3		
	175.5	162.23 OUT 162.28 IN	13.3 13.2	7+16.0 ℄ 15' SOUTH	

SERVICE RECORD

No. of Permit		House Number		DATE OF PERMITS	
North West	South East	North West	South East	North West	South East
	SO C51817 #2834		Robinson School 328 N. Oliver		10-10-75 10-23-50
		328 Chas Robinson School	R see next pg	5-16-03	11-18-31
#339		Chas. Robinson School		11-18-31	
	#2833		Robinson School 328 N. Oliver		10-23-50
#750		409 N. Oliver		12-8-41	
	2385 #2971 #863		401 N Blecklex (401 N. Bleckley Dr.)		1-14-81 12-11-80 1-14-42
#751		408 N. Oliver		12-8-41	
#209		414-416 (412-414) N. Oliver		9-24-41	
	#862		415 N. Bleckley Dr.		1-13-42
#40		418-420 N. Oliver		9-8-41	
#1733		424 N. Oliver		7-24-39	
	#694		421 N. Bleckley Dr.		12-2-41
#1410		428 N. Oliver		3-24-39	
	98-21594-1 #1879		434 N. Oliver R		11-10-98 8-7-50
#1477		801 E. Central		4-21-39	
	C51818	328 N. Oliver		10-12-75	
	3069		328 N. Oliver		4-8-81

#8 - Tap - Charles Robinson School 1-13-32 - Johnson plbg. Co.
#25 - Tap " " " 2-10-32 " " "
#74 Tap - 801 E Central - 6-25-49 - Moore Robertson plbg. Co.
Tap C52070 - 328 N. Oliver - 10/23/75 - Robinson School (0+57)