E 23 A

TRAP AREA

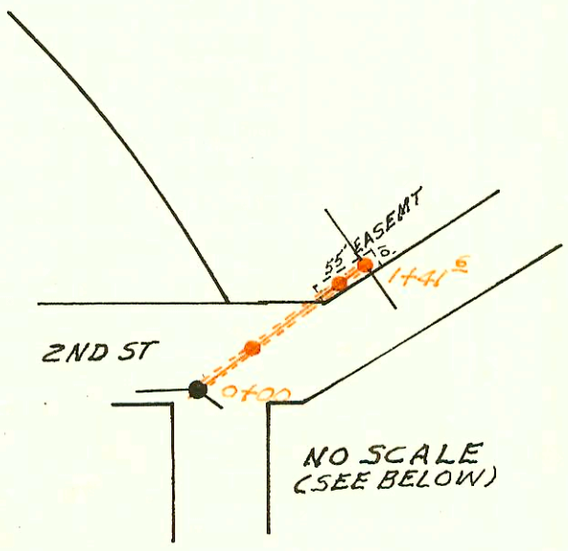

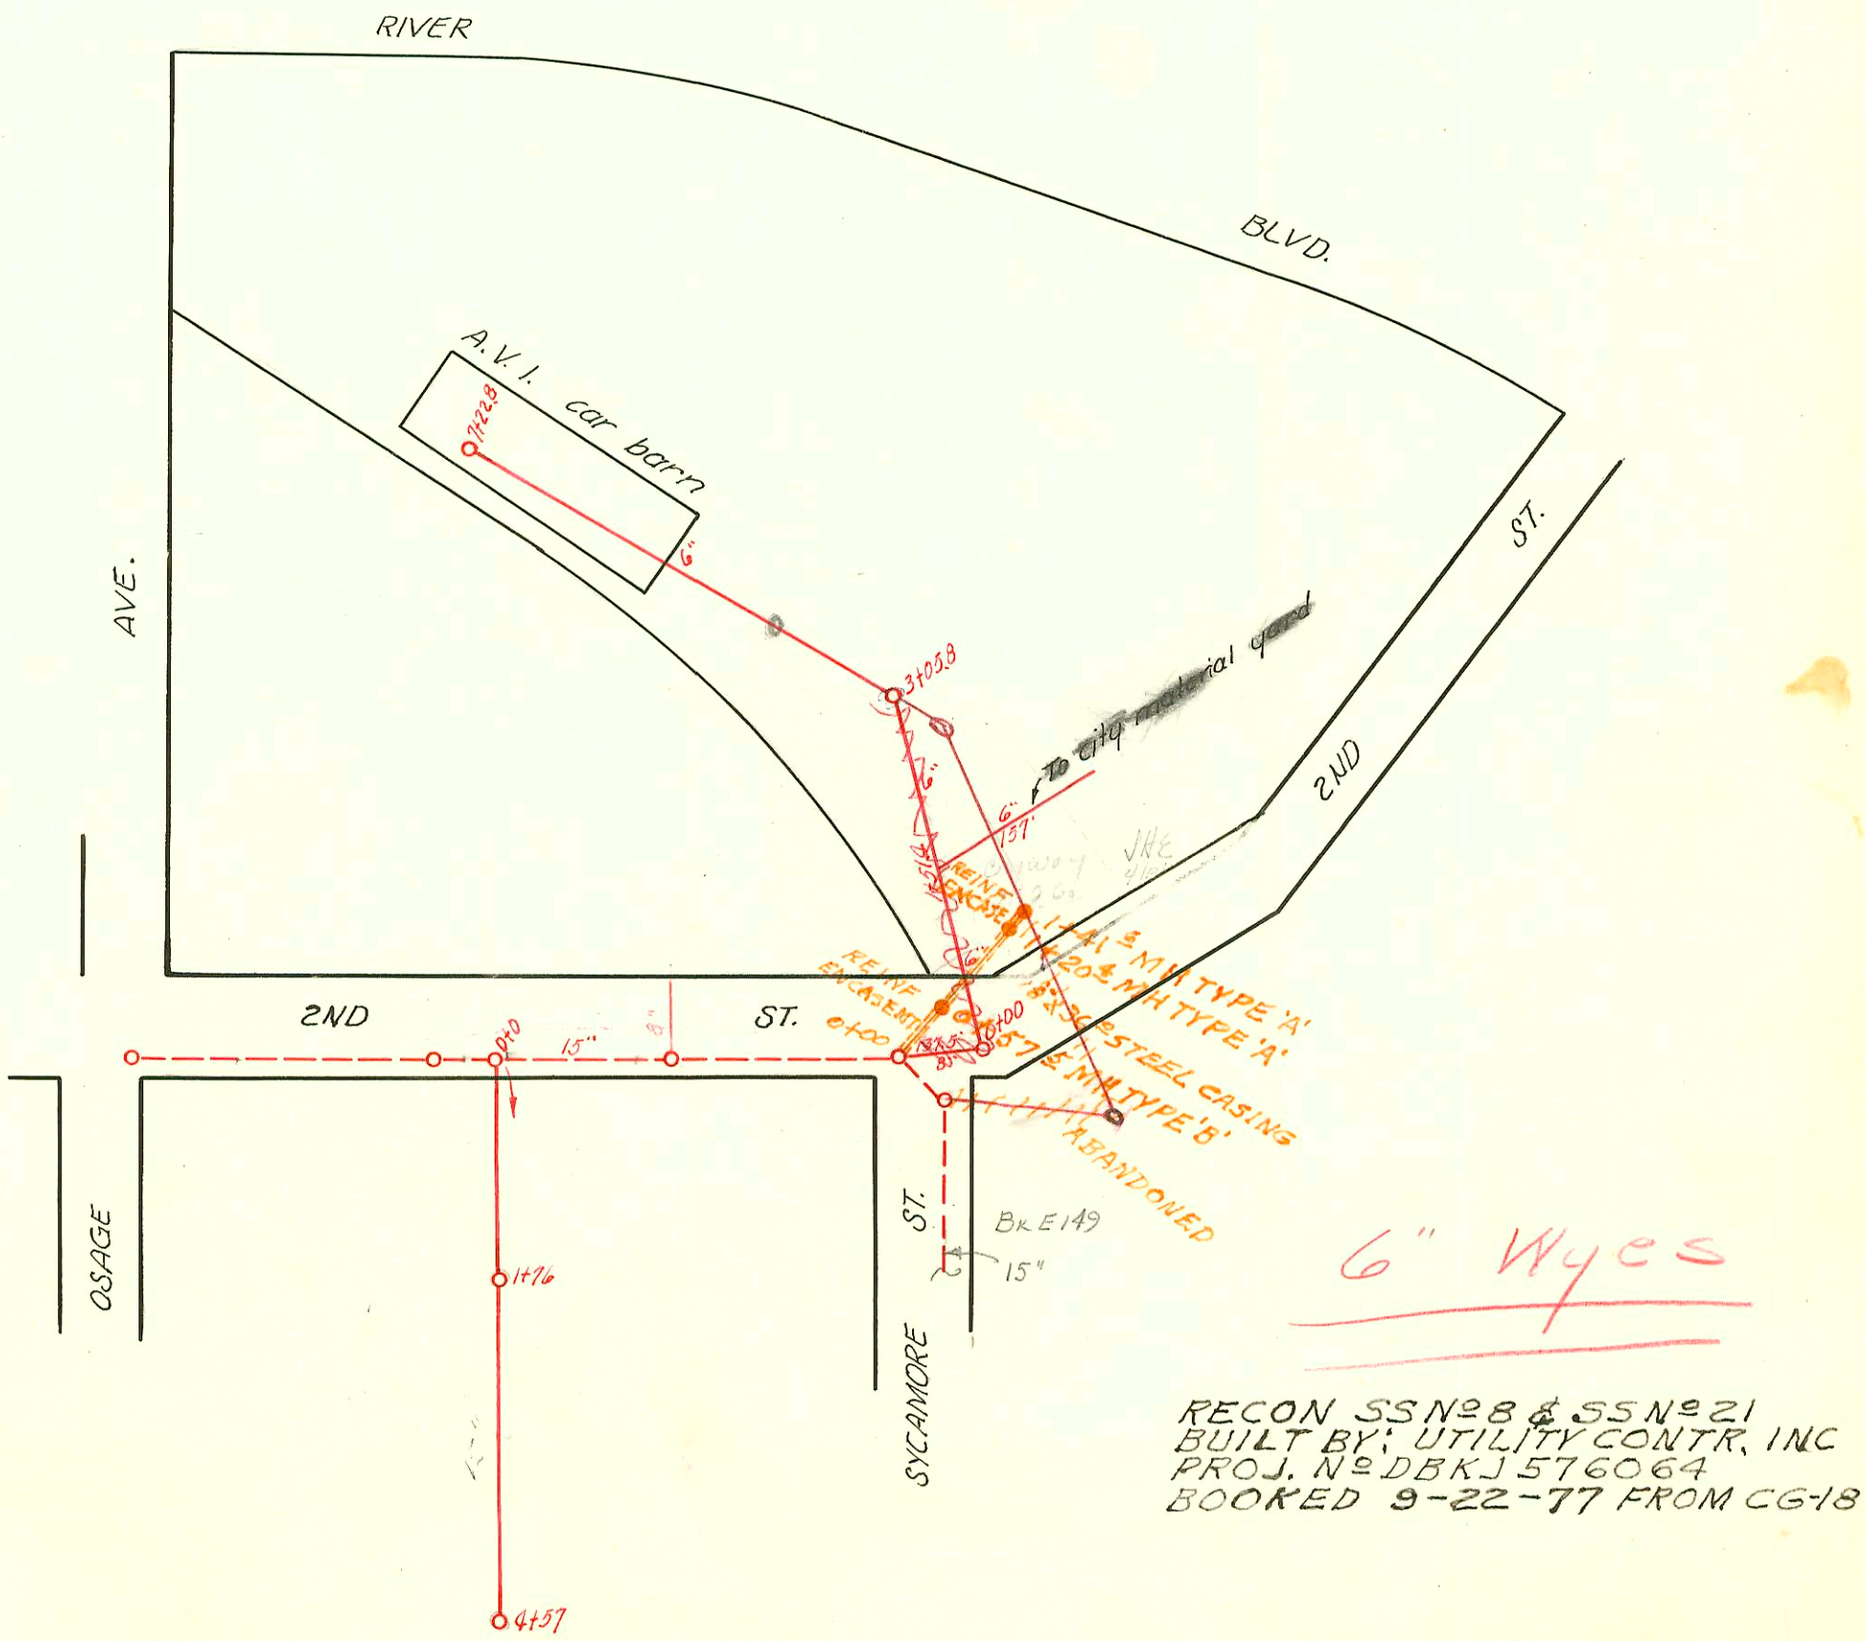

6" Wyes

RECON SS № 8 & SS № 21
BUILT BY: UTILITY CONTR. INC
PROJ. № DBKJ 576064
BOOKED 9-22-77 FROM CG-18

Form 41-(54) 3-51

CONSTRUCTION RECORD							SERVICE RECORD					
STATION	ELEVATION		Depth	MANHOLE	4-INCH "Y" BRANCHES		No. of Permit		House Number		DATE OF PERMITS	
	Ground	Grade			North West	South East	North West	South East	North West	South East	North West	South East
0-137.5	114.29	102.79	11.50									
0+0	114.00	103.20	10.80									
3+05.8	112.61	106.21	6.40									
					6" Y's	6" Y's						
0+0				0+0								
1+0												
				1+76	1+76 Stub							
2+0												
3+0					3+04							
4+0												
4+57				4+57		4+57 Stub						
RECON SS Nº8 & SS Nº21												
0+00	115.1	103.34	11.8	0+00 EXISTING								
				0+57.5								
1+00												
				1+20.4								
	113.6	104.05	9.6	1+41.6								

#2713 – Trapped into MH. 3+05.8 – 604 W. 2nd – 12-2-40,

F. Tap – C 44111 – 301 N. McLean. Rec'd MH tap 3+05.8 – 3-25-74

S/P Tap – C 52047 – 630 W. 2nd 10-22-75 (2+90.8) R Fleming 4-21-82 S/P