44 A

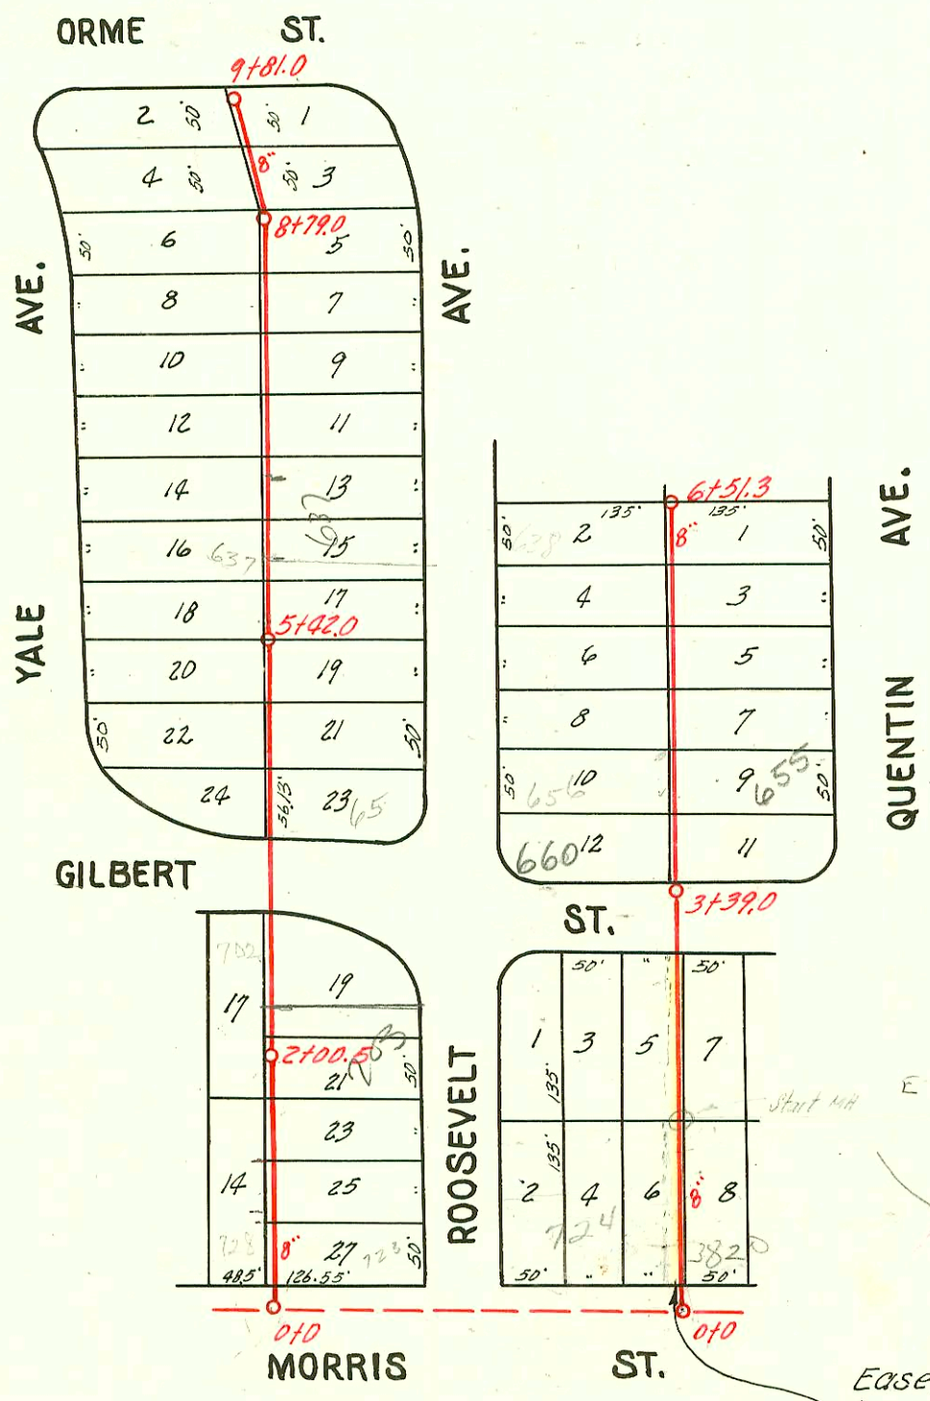

LAT. V, DIST. 6, S. S. 12

W. B. CARTER 1940

Form 41-(54) 3-51

CONSTRUCTION RECORD

STATION	ELEVATION Ground	ELEVATION Grade	Depth	MANHOLE	4-INCH "Y" BRANCHES North West	4-INCH "Y" BRANCHES South East
					0+26 6"sch40 PVC	
0+0	166.90	153.95	12.95	0+0	0+50	
					0+65	
1+0	167.80	155.15	12.65			
					1+16	
					1+56.7	
2+0	169.10	156.35	12.75			
					2+06.4	
					2+45.8	
					2+85.2	
3+00	171.60	157.55	14.05		3+57 4" PE SDR 17	
				3+39.0	3+81.3 4"4.0PVC LO	3+78.3 4"sch40 CO
4+0	171.50	158.75	12.75		4+10.0	4+07
					4+33.2	4+30.2
					4+57.0	4+54.0
					4+84.0	4+81.0
5+0	171.00	159.95	11.05		5+08.5	5+05.5
					5+32.2	5+29.2
					5+60.4	5+57.4
					5+74.0	
					5+84.7	5+81.7
6+0	171.20	161.15	10.05		6+03.0	6+06.0
					6+33.0	6+30.0
	173.20	161.75	11.45	6+51.3		
0+0	161.40	150.00	11.40	0+0		
					0+32.0	0+29.0
					0+55.0	0+52.0
					0+82.4	0+79.4
1+0	162.50	150.30	12.20		1+07.0	1+04.0
					1+30.2	1+27.2
					1+55.0	1+52.0
					1+83.0	1+80.0
2+0	163.10	150.60	12.50	2+00.5	2+11.0	2+08.0
					2+30.5	2+27.5
					2+55.0	2+52.0
					2+83.0	2+80.0
3+0	162.70	150.90	11.80		3+09.5	3+06.5
					3+36.5	3+33.5
4+0	162.70	151.20	11.50		4+21.0	4+18.0
					4+43.0	4+40.0
					4+71.0	4+68.0
					4+98.0	4+95.0
					5+23.0	5+20.0
				5+42.0		
					5+48.0	5+45.0
					5+73.0	5+70.0
					5+98.0	5+95.0
6+0	164.50	151.80	12.70		6+25.0	6+22.0
					6+50.0	6+47.0
					6+74.3 4"PVC CO	6+71.3
7+0	165.90	152.10	13.80		7+01.0	6+98.0
					7+25.0	7+22.0
					7+49.5	7+46.5
					7+77.0	7+74.0
8+0	166.70	152.40	14.30		8+02.0	7+99.0
					8+25.5	8+22.5
					8+54.0	8+51.0
						8+74.5
				8+79.0		
					8+82.0	
9+0	165.40	152.70	12.70		9+00.0	8+97.0
					9+25.0	9+22.0
					9+29.5	9+46.5
					9+73.5	9+70.5
	163.60	152.94	10.66	9+82.0		

SERVICE RECORD

No. of Permit North West	No. of Permit South East	House Number North West	House Number South East	DATE OF PERMITS North West	DATE OF PERMITS South East
		724 S.			
96-71737		Roosevelt		5-15-96	
#114		710 S. Roosevelt		9-18-41	
#3042		702 S. Roosevelt		1-7-41	
#2901	2002-00195	660 S. Roosevelt	See Below	10-23-40	1-22-02
	#749		659 S. Quentin		
#2157	2002-00498	658 S. Roosevelt	655 R S. Quentin	10-16-41	12-8-41 2-25-02
#2833	#2301			11-1-40	7-13-42
			See Top		
#2619	#2302	652 S. Roosevelt	651 S. Quentin	8-29-40	7-13-42
#3707	#1815	648 S. Roosevelt	645 S. Quentin	6-20-41	5-12-42
#2144		642 S. Roosevelt		3-19-40	
	#1167		641 S. Quentin		3-12-42
#2168	#740	638 S. Roosevelt	635 S. Quentin	3-25-40	12-5-41
#69	#464	728 S. Yale	723 S. Roosevelt	5+26-48	7-28-48
#70	#465	722 S. Yale	719 S. Roosevelt	5-26-48	7-28-48
#71	#466	716 S. Yale	713 S. Roosevelt	5-26-48	7-28-48
#72		712 S. Yale		5-26-48	
#1364	3122	708 S. Yale	703 S. Roosevelt	9-2-41 10-27-48	2-13-41
	#3982		701 S. Roosevelt		7-19-41
#1363		702 S. Yale		10-27-48	
	#2863		*See below 659 S. Roosevelt	6-7	11-13-40
#1025	#2862	648 S. Yale	635 S. Roosevelt	12-3-46	11-13-40
	#2628		647 S. Roosevelt		9-3-40
#1024	#2627	642 S Yale	641 S. Roosevelt	12-3-46	9-3-40
#279		638 S. Yale		3-12-43	
	#2626		637 S. Roosevelt		9-3-40
#230		632 S. Yale		2-18-43	
	93 20879		631 S.R Roosevelt		8-993 3-23-41
#196		628 S. Yale		2-4-43	
	#3168		625 S. Roosevelt		3-5-41
#2558		622 S. Yale		8-20-42	
	#3550		621 S. Roosevelt		5-17-41
#3507		616 S. Yale		5-20-41	
#2557	#3091	612 S. Yale	613 S. Roosevelt	8-20-42	2-4-41
#2955	#3072	606 S. Yale	607 S. Roosevelt	12-21-40	1-23-41
#241	#2554	602 S. Yale	601 S. Roosevelt	6-21-48	8-5-40

2002-00195 - 122102 - 660 S Roosevelt - Dales Plbg - Pipe Burst Repl - 4" PES DR17 19'N of MH 3+99 (3+58) Predco Saddle - 1V22, 1V45

96-71737 R 5-15-96

#2825 - Tap - 722 S. Roosevelt - 10-29-40 - Cherry Plbg. Co.

#856 - Tap - 714 S. Roosevelt - 1-2-42 - Chester Davidson.

#1026 - Tap - 654 S. Yale 12-3-46 Frederick Plbg. Co.

#B2156 - TAP - 656 S. Roosevelt - 10-16-64 Phil's Sewer Service (4+02)

* # C14305 - 657 S. Roosevelt (Repair - 3+75.4) 6-3-69 - Herb Hoover

C66064 - (656 S. Yale 5.0) 4-25-78 Sewer (4+09.0)