E 48 A

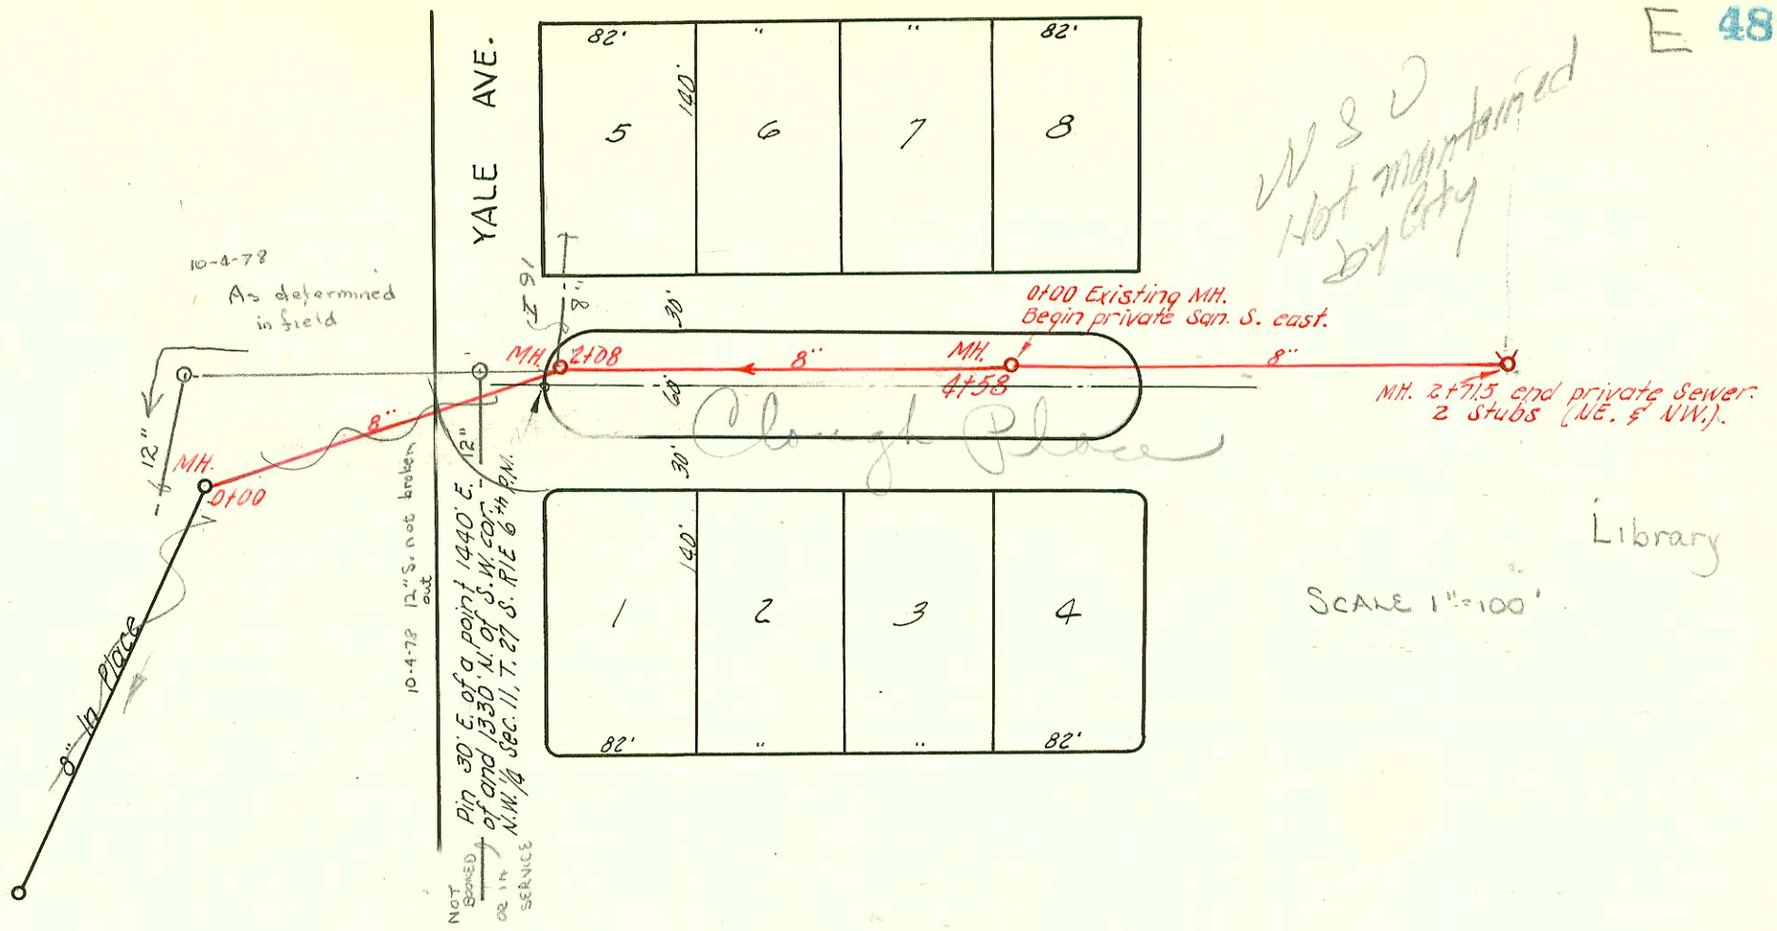

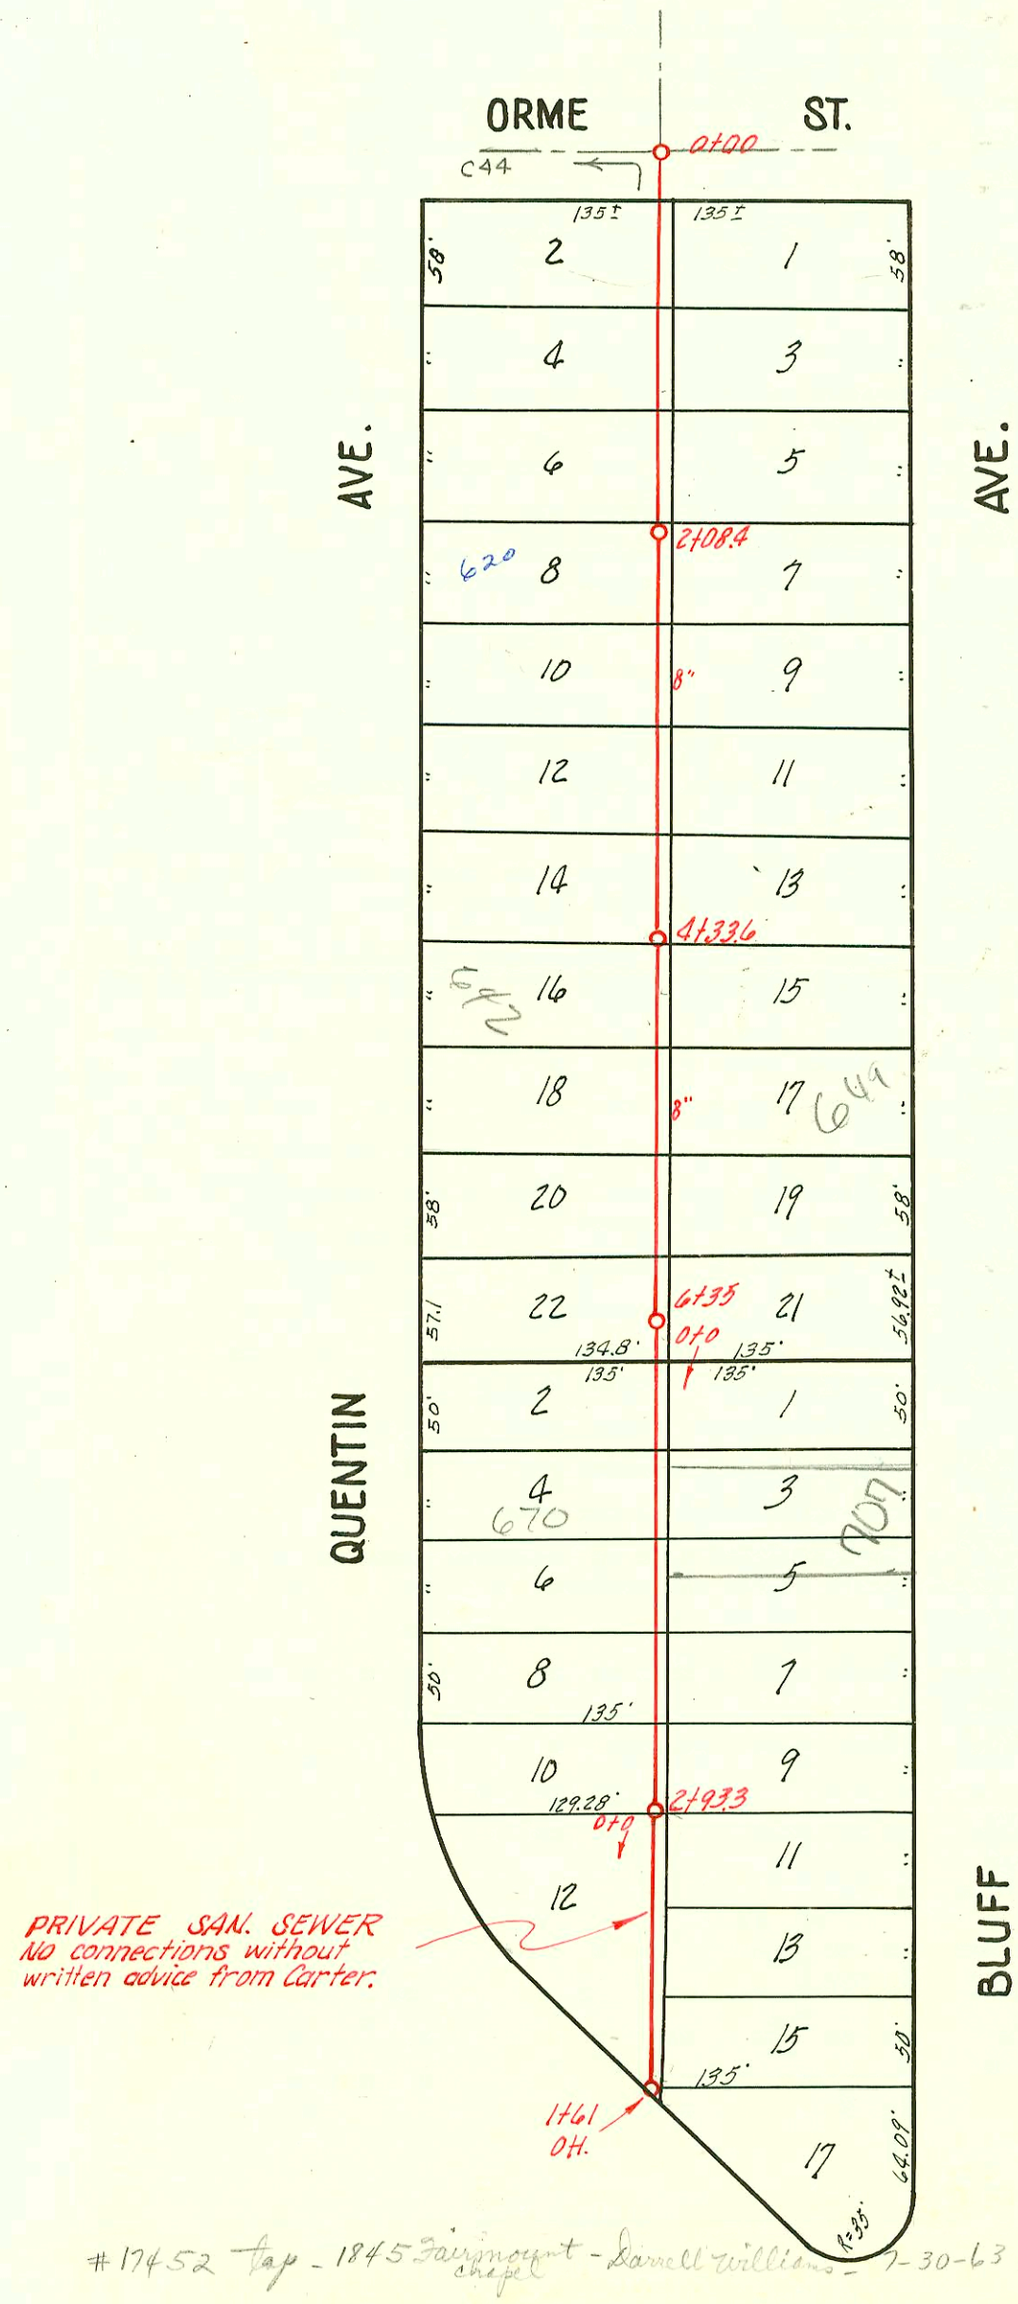

LAT. 1, DIST. 6, S. S. #12
W. B. CARTER
1941

LAT. 4, DIST. 6, S. S. #12
W. B. CARTER
1942

#17452 tap - 1845 Fairmount chapel - Darrell Williams - 7-30-63 (tap MH. 0+00)

E48

Form 41-(54) 3-51

CONSTRUCTION RECORD							SERVICE RECORD					
STATION	ELEVATION		Depth	MANHOLE	4-INCH "Y" BRANCHES		No. of Permit		House Number		DATE OF PERMITS	
	Ground	Grade			North West	South East	North West	South East	North West	South East	North West	South East
0+0	210.33	202.53	7.80	0+0								
1+0	209.25	202.73	6.52									
2+0	209.25	202.93	6.32									
	209.32	202.95	6.37	2+08								
					2+39	2+39	#2431		2010 N. Yale		6-18-40	
3+0	210.00	203.13	6.87									
					3+21	3+21	#2731	#3217	Lot 6 19th St.	3609 Clough	10-4-40	1-17-51
4+0	210.65	203.33	7.32		4+03	4+03	#1040		3622 Clough		7-30-49	
	210.40	203.45	6.95	4+58	4+52.0		#6041		3624 Clough		9-12-51	
0+0	172.18	159.00	13.18	0+0								
					0+46.5	0+43.5		#1074		601 S. Bluff		11-5-47
					0+75.2	0+72.2						
1+0	172.10	159.10	13.00		1+05.0	1+02.0						
					1+34.5	1+31.5	#3377	#3376	608 S. Quentin	609 S. Bluff	4-25-41	4-25-41
					1+62.8	1+59.8						
2+0	172.00	159.20	13.00		1+93.0	1+90.0	#1290		616 S. Quentin		12-15-47	
				2+08.4								
					2+20.0	2+17.0						
					2+50.3	2+47.3						
					2+77.0	2+74.0	#1963		620 S. Quentin		5-29-42	
3+0	173.30	159.30	14.00		3+07.5	3+04.5		#437		625 S. Bluff		10-17-41
					3+37.9	3+34.9	#1964		626 S. Quentin		5-29-42	
					3+67.5	3+64.5		#387		631 S. Bluff		7-12-48
					3+95.5	3+92.5	#711		636 S. Quentin		6-29-49	
4+0	173.40	159.40	14.00		4+26.0	4+23.0		#1825		637 S. Bluff		3-27-48
				4+33.6								
					4+52.8	4+49.8						
					4+83.0	4+80.0	#1950	#1226	642 S. Quentin	643 S. Bluff	5-5-47	12-3-47
5+0	173.50	159.50	14.00		5+09.2	5+06.2	#1420		646 S. Quentin		1-10-48	
					5+39.6	5+36.6		#915		645 S. Bluff		10-14-47
					5+67.6	5+64.6						
					5+96.9	5+93.9	#1949	#2315	654 S. Quentin	655 S. Bluff	5-5-47	4-30-47
6+0	173.60	159.60	14.00		6+27.9	6+24.9						
	173.60	159.64	13.96	6+35.0								
0+0	173.60	159.64	13.96	0+0								
					0+06.1	0+03.1						
					0+32.1	0+29.6	#439	#2314	660 S. Quentin	661 S.	7-19-47	4-30-48
					0+57.0	0+54.0						
					0+84.4	0+81.4	#1641	#1845	666 So. Quentin	4-21-47 701 S. Bluff	4-30-42	
1+0	170.30	159.74	10.56		1+09.7	1+06.7	#1642		670 So. Quentin		4-30-42	
					1+34.3	1+31.3		91-01375				12-1-49
					1+60.2	1+57.2		#1346		707 S. Bluff	R	4-2+4 n
					1+84.8	1+81.8	#2303		674 S. Quentin		7-13-42	
2+0	169.60	159.84	9.76		2+13.0	2+10.0		#1847		4-21-47 715 S. Bluff		
					2+37.0	2+34.0	#2809		680 S. Quentin		10-7-42	
					2+60.5	2+57.5	#2810	#1848	688 S. Quentin	4-21-47 723 S. Bluff	10-7-42	
					2+85.4	2+82.4		#1849		4-21-47 729 S. Bluff		
	169.20	159.93	9.27	2+93.3								
	Private Line				Y's West	Y's East						
0+0	169.20	160.10	9.37	0+0 old MH. (2+93.3)	Tap 0+26		(addn') #C3802		690 S. Quentin		7-3-67	
					0+55.2	0+58.2	#1747	#2728	698 S. Quentin	733 S. Bluff	3-12-48	12-6-49
1+0	168.50	160.30	8.57									
						1+12.9		#2731		737 S. Bluff		12-7-49
						1+58.0		#3071		720 S. Quentin		1-17-50
1+61	168.0	160.42	8.10	1+61 OH.								
PRIVATE SAN. S. UTILITY CONT. INC. OCT. 13, 1952 BK. M-9												
0+0	209.9	202.45	7.5	0+0 Existing MH.								
1+0	210.4	202.65	7.8									
2+0	211.6	202.85	8.8									
	212.8	202.99	9.8	2+71.9	2 (Stubs NE. & NW)							

W & V. 1 No tag mains

#C66756 - (3620 Clough So.) - 6-8-78 - Al Henning (4+12)
#C66684 (3614 Clough Pl. S.O.) 6-5-78 al Henning (2+89)
#C66683 - (3600 Clough Pl. S.O.) - 6-5-78 al Henning

#3741 - Tap at 2+13 - 3601 E. 19th - 6-26-41 - A. E. Lansdowne
#2328 - Tap - 2000 Gentry - Police Radio Station - 3-24-49 - W. B. Carter
#7180 - Private Line 1950 Gentry - 12-8-53 Pray Bros. - Testing Bldg.
#3700 - Private Line - 2000 Harvard - Woman's Residence Hall - 1-6-53 - Pray Bros.
#3701 " " " " " " 1-7-53 - " "
#8881 - tap MH. 1925 N. Yale - Repetra - Turner Bldg. (Student Union Bldg) 12-22-58 S. side of 2nd MH N. of 18th
#14847 - (tap MH 2+71.9) 1945 Fairmount - Pray Bros 10-17-61
B1413 - Science Bldg - 21 Hours - Dr. Griffin - 4-2-64 - tap 21' N. of MH 4+58