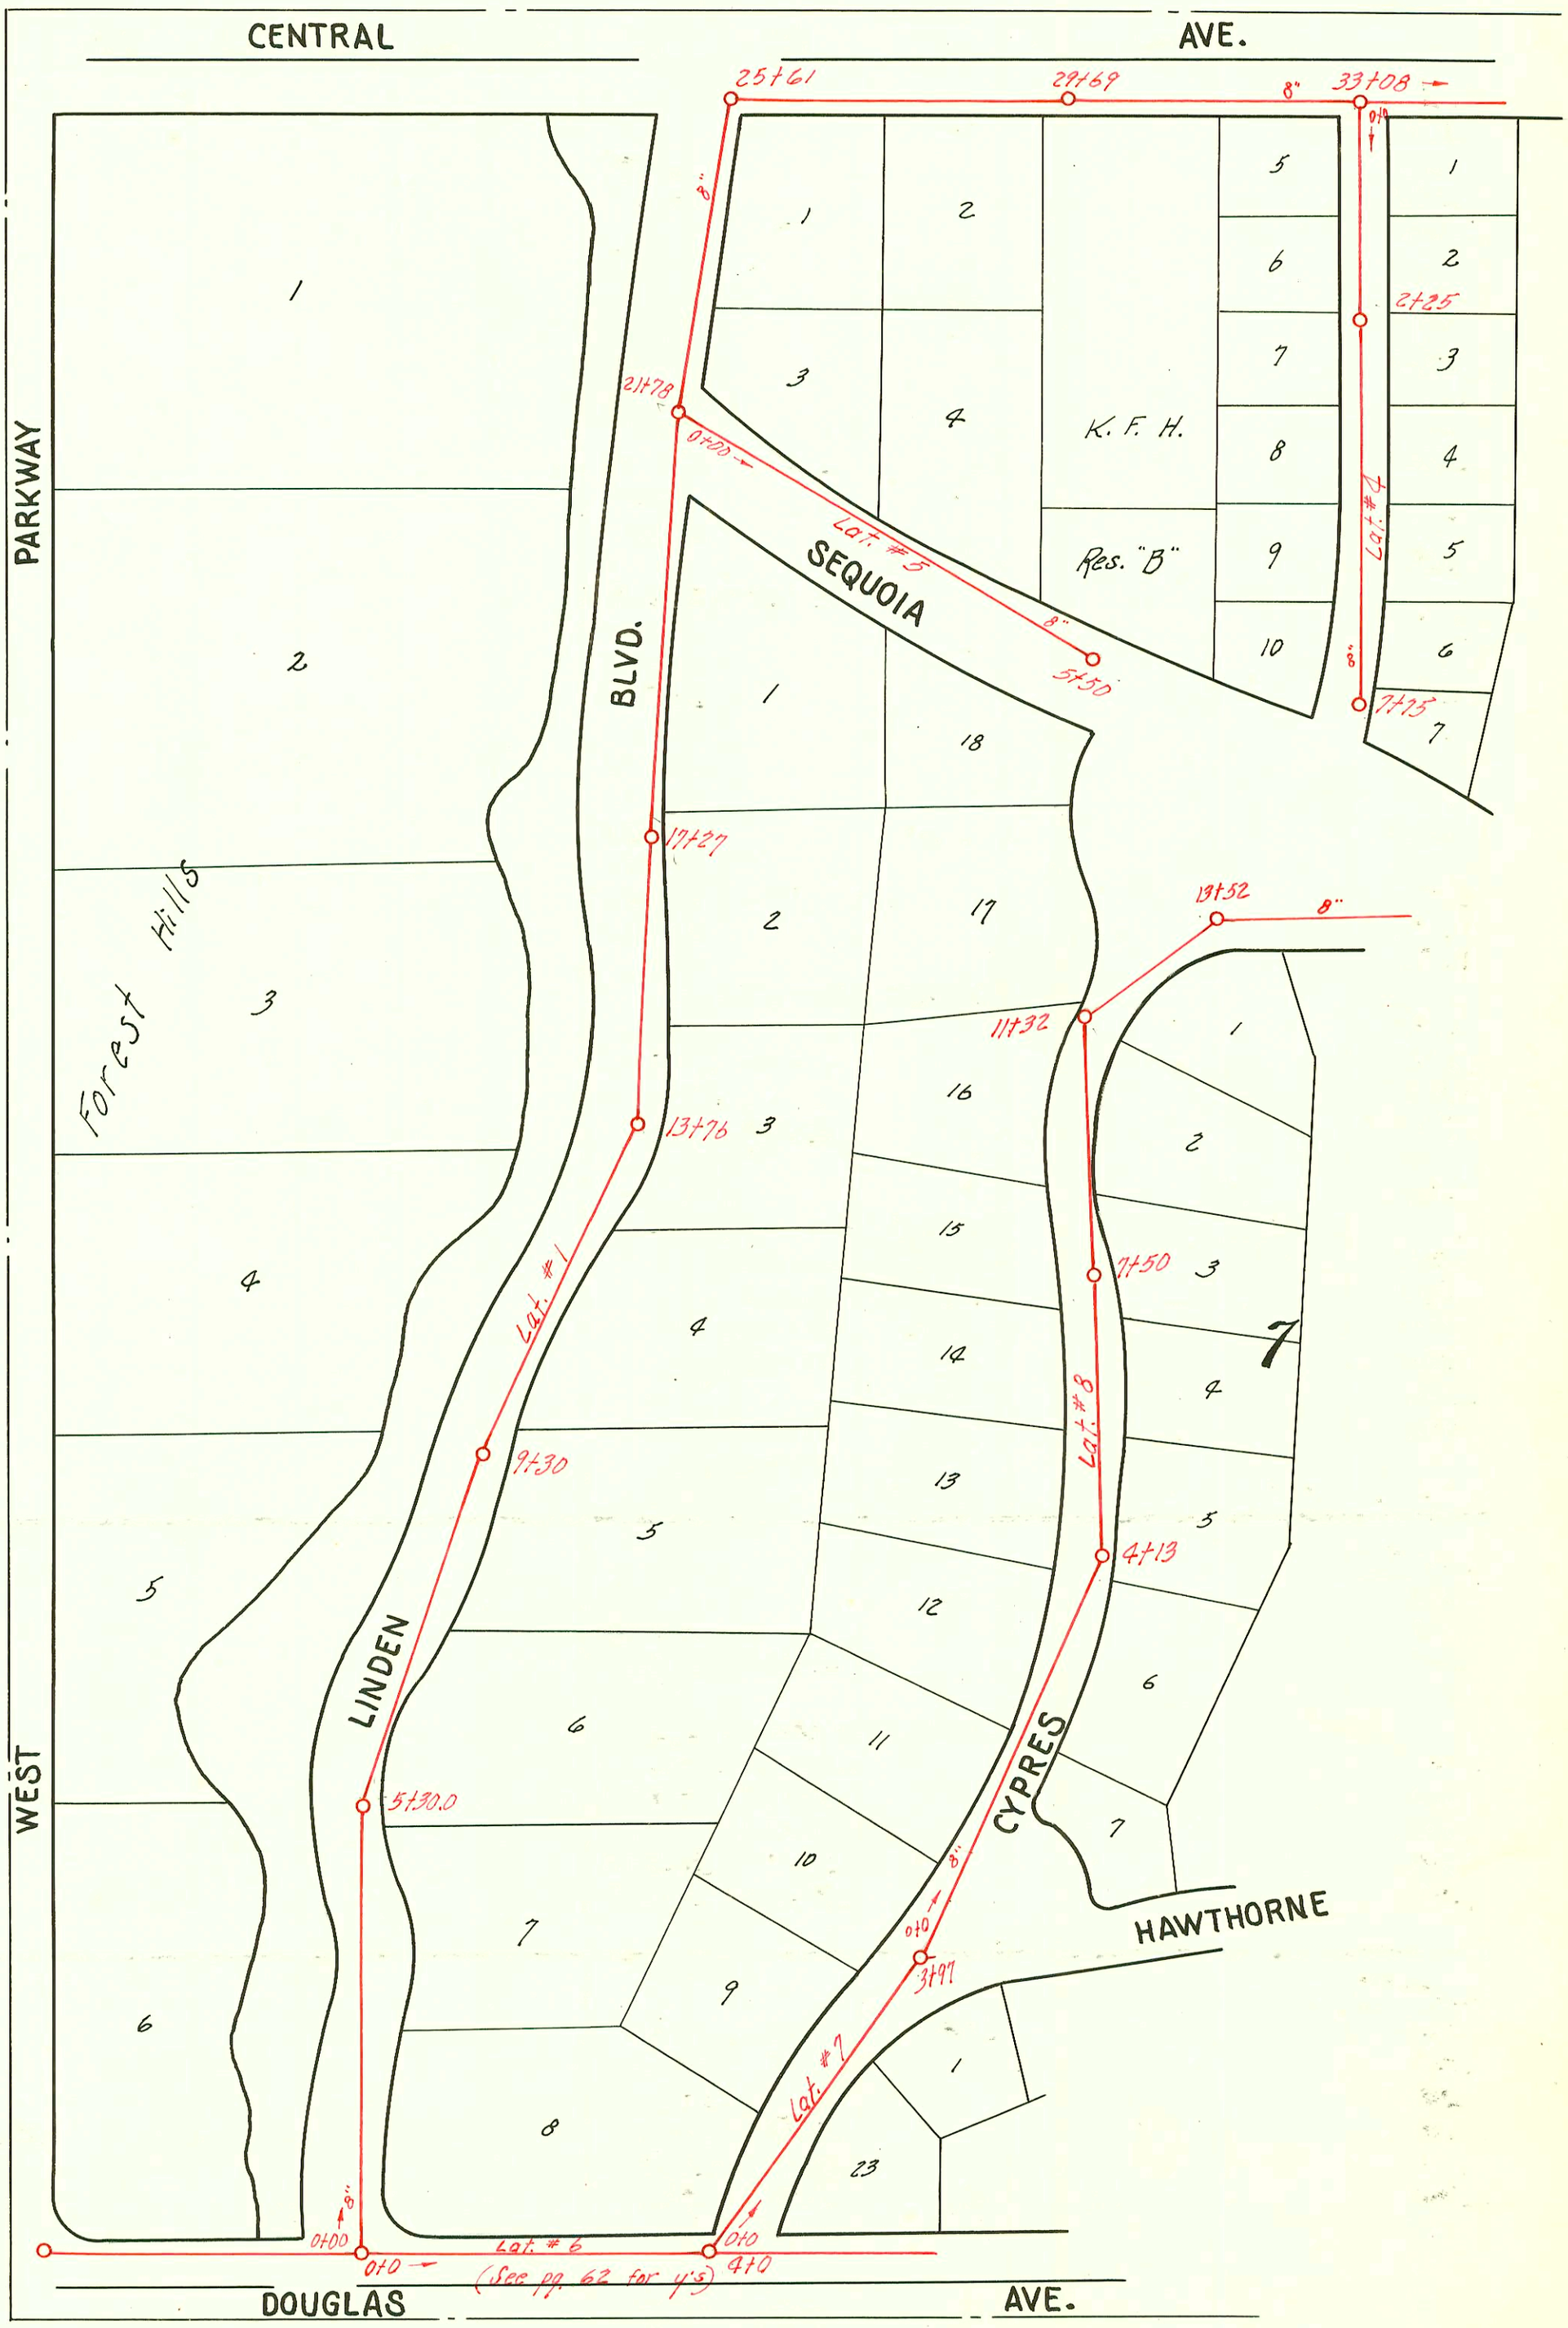
CENTRAL
AVE.
PARKWAY
WEST
DOUGLAS
AVE.
SEQUOIA
BLVD.
LINDEN
CYPRES
HAWTHORNE
Forest Hills
K. F. H.
Res. "B"
Lat. #1
Lat. #3
Lat. #4
Lat. #5
Lat. #6
Lat. #7
Lat. #8
25+61
29+69
33+08
21+78
17+27
13+76
9+30
5+30.0
13+52
11+32
7+50
4+13
3+97
5+50
7+25
2+25
0+00
(See pg. 62 for y's)

Form 41-(54) 3-51

CONSTRUCTION RECORD							SERVICE RECORD					
STATION	ELEVATION		Depth	MANHOLE	4-INCH "Y" BRANCHES		No. of Permit		House Number		DATE OF PERMITS	
	Ground	Grade			North West	South East	North West	South East	North West	South East	North West	South East
Lat. #1												
0+0				0+0								
1+0						1+51.5						
2+0						2+69.0						
3+0					3+31.0							
4+0						4+96.5						
5+0												
				5+30.0								
6+0												
7+0						7+57.0						
8+0												
9+0					9+25.0							
				9+30.0		9+82.5						
10+0												
11+0												
12+0					12+70.0	12+42.0						
13+0												
				13+76.0								
14+0						14+86.5						
15+0												
16+0												
17+0												
				17+27.0		17+80.0						
18+0												
19+0					19+53.0							
20+0												
21+0												
				21+78.0								
22+0												
23+0						23+00						
24+0					24+14	24+17						
25+0												
				25+61.0	(Turn East)							
26+0						26+32.0						
27+0						27+54.0						
28+0												
29+0												
				29+69.0								
30+0												
31+0						31+63.0						
32+0												
				33+08.0								
(Lat. #1 cont. page 61)												
Lat. #4												
0+0				0+0								
1+0					1+12	1+03						
2+0					1+79	1+70						
				2+25								
					2+70	2+73						
3+0					3+77	3+80						
4+0					4+94	4+91						
5+0												
6+0					6+00	6+24						
7+0					7+01	7+10	#2279		Lot 10 Blk. 2		5-1-40	
				7+75								
Lat. #5												
0+0				0+0								
1+0												
2+0					South "y"	2+79						
3+0					3+28		#2016		Lot 18 Blk. 3		12-7-39	
4+0						4+87						
5+0						5+35						
				5+50								