

28		21
29		20
30		19
31		18
32		17
33		16
34	140'	140'
35		14
36		13
37		12
38		11
39		10
40		9
41		8
42		7
43		6
44		5
45		4
46	140'	140.6± 3
47		2
48	110'	110.63± 1


OLD MANOR ROAD

33	110'	110.67	32
34	140'	140'	31
35			30
36			29
37			28
38			27
39		11+90.4	26
40		31+01.0	25
41			24
42			23
43			22
44			21
45			20
46			19
47			18
48			17
49			16
50			15
51			14
52		27+85.6	13
53			12
54			11
55	140'		10
56			9
57			8
58			7
			6
			5
			4
			3
			2
			1

AVE.

MURDOCK

9/10/04 Calvin Fugitt P.L.
 Contact Calvin Fugitt P.L. if repl
 at sewer permit to repl
 requests line between
 sewer line to 11+90.4
 before 7+74.1 to 11+90.4
 Mt F-Mail add
 See Bob

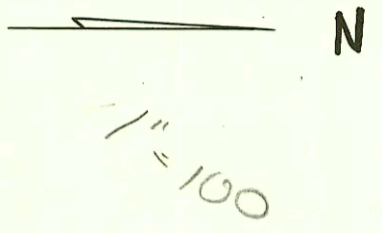

2002-00573- 3/4/02 5332 E Pine - Reddi Rootr - 4"sch 40, 1V22, tied to claytile 1' from main, Replace 14' low end
 2002-01117 4/18/02 5108 E Pine Shallow Vlbog - W/e repair 104'E of MH 3+27.7(4+31.7) 1 Div c.o., (Fernco,
 1V45, Bsmnt, 4"40 PUC

CONSTRUCTION RECORD						SERVICE RECORD						
STATION	ELEVATION		Depth	MANHOLE	4-INCH "Y" BRANCHES		No. of Permit		House Number		DATE OF PERMITS	
	Ground	Grade			North West	South East	North West	South East	North West	South East	North West	South East
26+00					26+95.3	26+92.3						
27+00	202.5	190.15	12.35		27+20.4	27+17.4	#2519	#1039	5023 E	5022 E. Pine	8-14-42	12-4-46
					27+46.4	27+43.4				5012 E. Pine		7-8-47
				27+85.6	27+69.1	27+66.1						
					27+95.8	27+92.8	#22821		5017 E		4-3-89	
28+00	203.3	191.05	12.25		28+21.3	28+18.3	#1816	#351	5011 E.	5408 E. Pine	#0287	7-8-47
					28+43.3	28+40.3	#1832		Murdock			3-22-48
					28+71.0	28+68.0	#1831		5407 E			3-22-48
					28+93.7	28+90.7		#1038	5406 E Pine			12-4-46
29+00	205.0	191.95	13.05		29+19.1	29+16.1	#2510		5403 E		8-10-42	
					29+45.4	29+42.4	#2002		Murdock		seen next pg	2-4-47
					29+70.2	29+67.2	#1203		5327 E	5326 E. Pine	6-9-47	10-23-47
					29+93.3	29+90.3	#2507		Murdock		8-10-42	5-7-42
30+00	205.0	192.85	12.15		30+19.4	30+16.4						
					30+46.3	30+43.3	#1081		5323 E			5-2-52
					30+61.0	30+58.0		#875	5320 E. Pine			1-19-42
					30+92.0	30+89.0	#2508		5319 E. Murdock			8-10-42
31+00	204.5	193.75	10.75									
				31+01.0								
	End Line # 1											
LINE #6 See page 67												
4+00	185.9	176.45	9.45		4+11.4	4+08.4	#2041	#2002	5107 E. Murdock	5108 E. Pine	seen next pg	4-18-42
					4+36.7	4+33.7		#1562	5116 E. Pine			3-20-46
					4+60.9	4+57.9						1-2-47
					4+88.5	4+85.5	#2976		Murdock			3-7-46
5+00	189.0	178.39	10.61		5+12.7	5+09.7						
					5+37.1	5+34.1	#2975		5117 E. Murdock			3-7-46
					5+61.6	5+58.6		#1341	5113 E. Pine			1-23-47
					5+87.5	5+83.5	#2974	#1499	5123 E. Murdock	5122 E. Pine		3-7-46
6+00	191.5	180.34	11.16		6+10.6	6+07.6	#2973	#1557	5127 E. Murdock	5126 E. Pine		11-18-41
					6+38.0	6+35.0						1-11-48
					6+62.8	6+59.8						
					6+89.4	6+86.4	#2772	#1133	5201 E. Murdock	5200 E. Pine		3-7-46
7+00	193.0	182.29	10.71		7+14.3	7+11.3	#2771		5207 E. Murdock			3-7-46
					7+37.9	7+34.9		#1734	5208 E. Pine			5-7-42
				7+74.1								
					7+86.8	7+83.8	#2730	#1812	5211 E. Murdock	5210 E. Pine		3-7-46
8+00	195.7	184.40	11.30		8+11.5	8+08.5	#2731	#27061	5217 E. Murdock	5218 E. Pine		2-14-91
					8+38.2	8+35.2		#1735	5219 E. Pine			3-7-46
					8+62.8	8+59.8						
					8+87.6	8+84.6	#2782	#1342	5223 E. Murdock	5222 E. Pine		3-7-46
9+00	198.4	186.82	11.58		9+11.7	9+08.7						
					9+38.6	9+35.6	#2783	#1267	5227 E. Murdock	5228 E. Pine		3-7-46
10+00	201.1	189.24	11.86		10+26.6	10+23.6						
					10+51.0	10+48.0						
					10+74.6	10+71.6	#2505	#1244	5305 E. Murdock	5302 E. Pine		8-10-42
					10+99.7	10+96.7	#1236	#2506	5307 E. Murdock			12-26-41
11+00	203.1	191.66	11.44		11+27.5	11+24.5		#2984		5312 E. Pine		4-1-46
					11+52.5	11+49.5						
					11+76.0	11+73.0	#2507		5313 E. Murdock			8-10-42
	204.4	193.71	10.69	11+90.4								

#2777 - Top - 5112 E. Pine - 3-7-46 - Brodie Plog. Co
 #1755 - Top - 5316 E. Pine - 4-7-47 - Wichita Plog. Co.
 #1203 - Top - 707 W. Old Manor - 5-12-52 Mitchell & Hensley Inc. (R) 9+14.1 @ 533.05 1-2-47

Finished