E 99 A

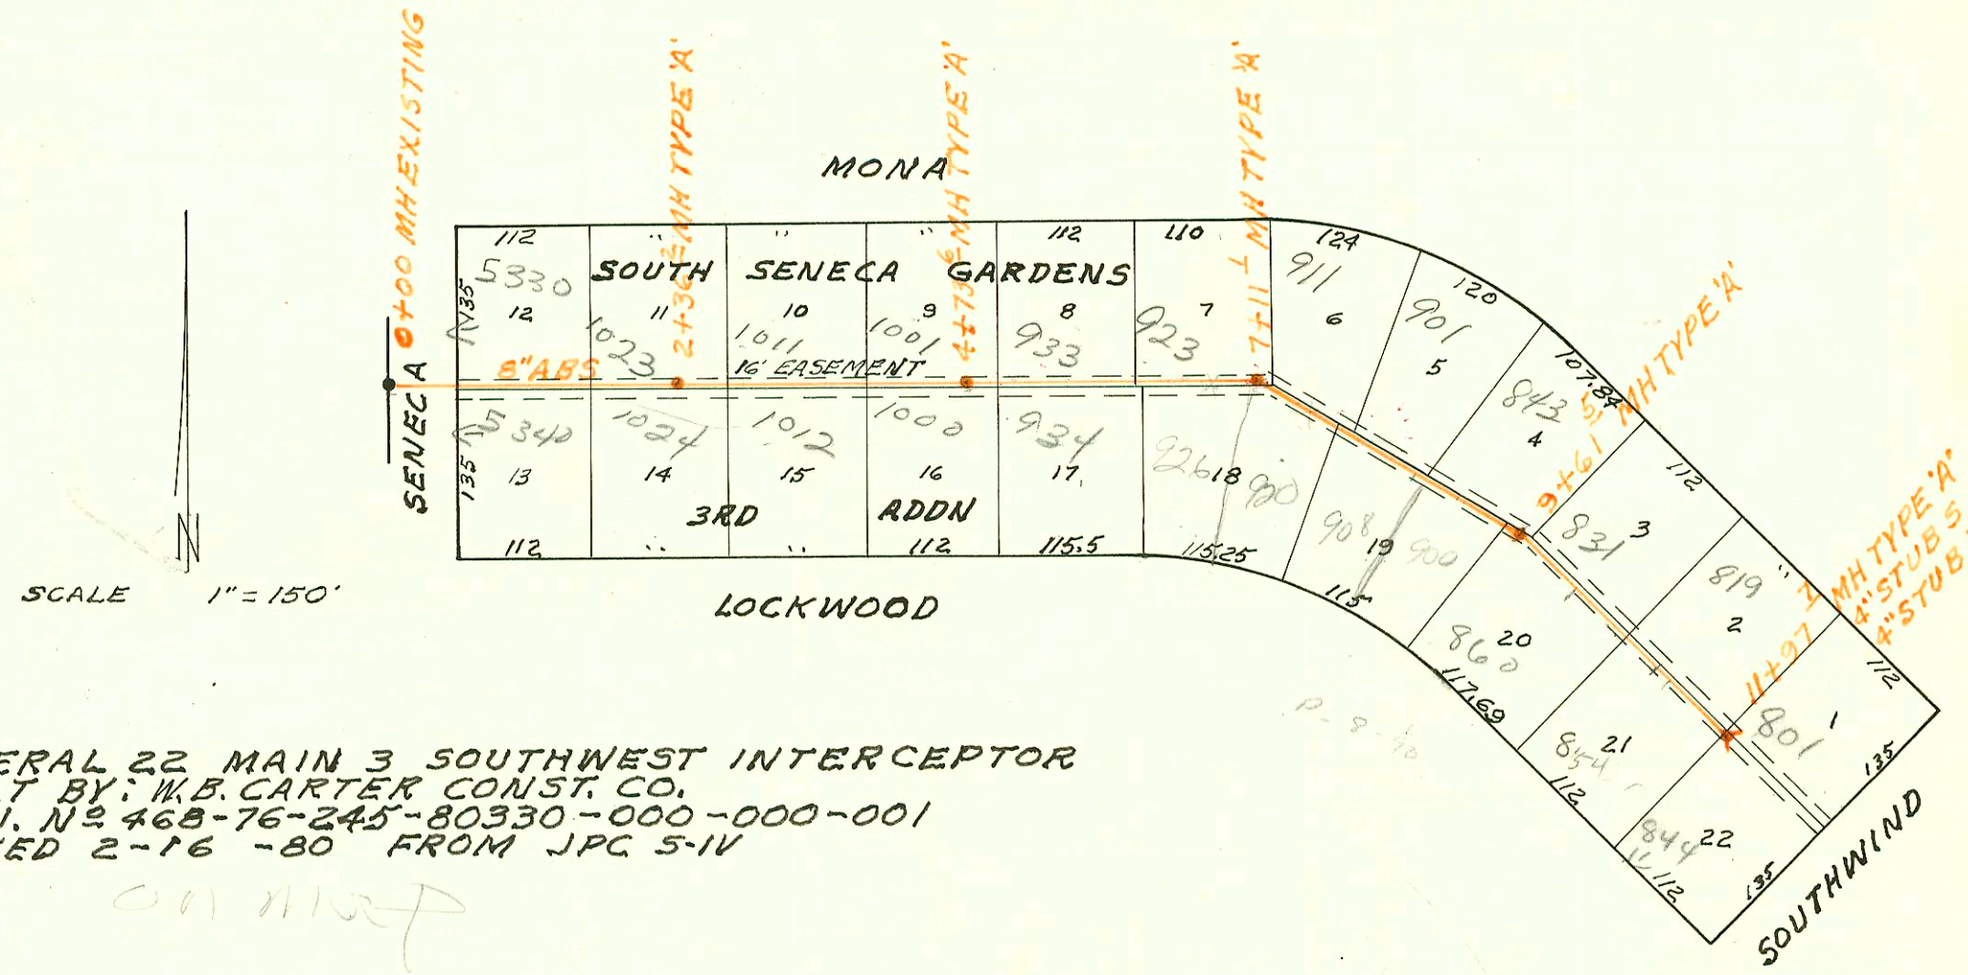

LATERAL 22 MAIN 3 SOUTHWEST INTERCEPTOR
BUILT BY: W.B. CARTER CONST. CO.
PROJ. № 468-76-245-80330-000-000-001
BOOKED 2-16-80 FROM JPC 5-IV

ON MAP

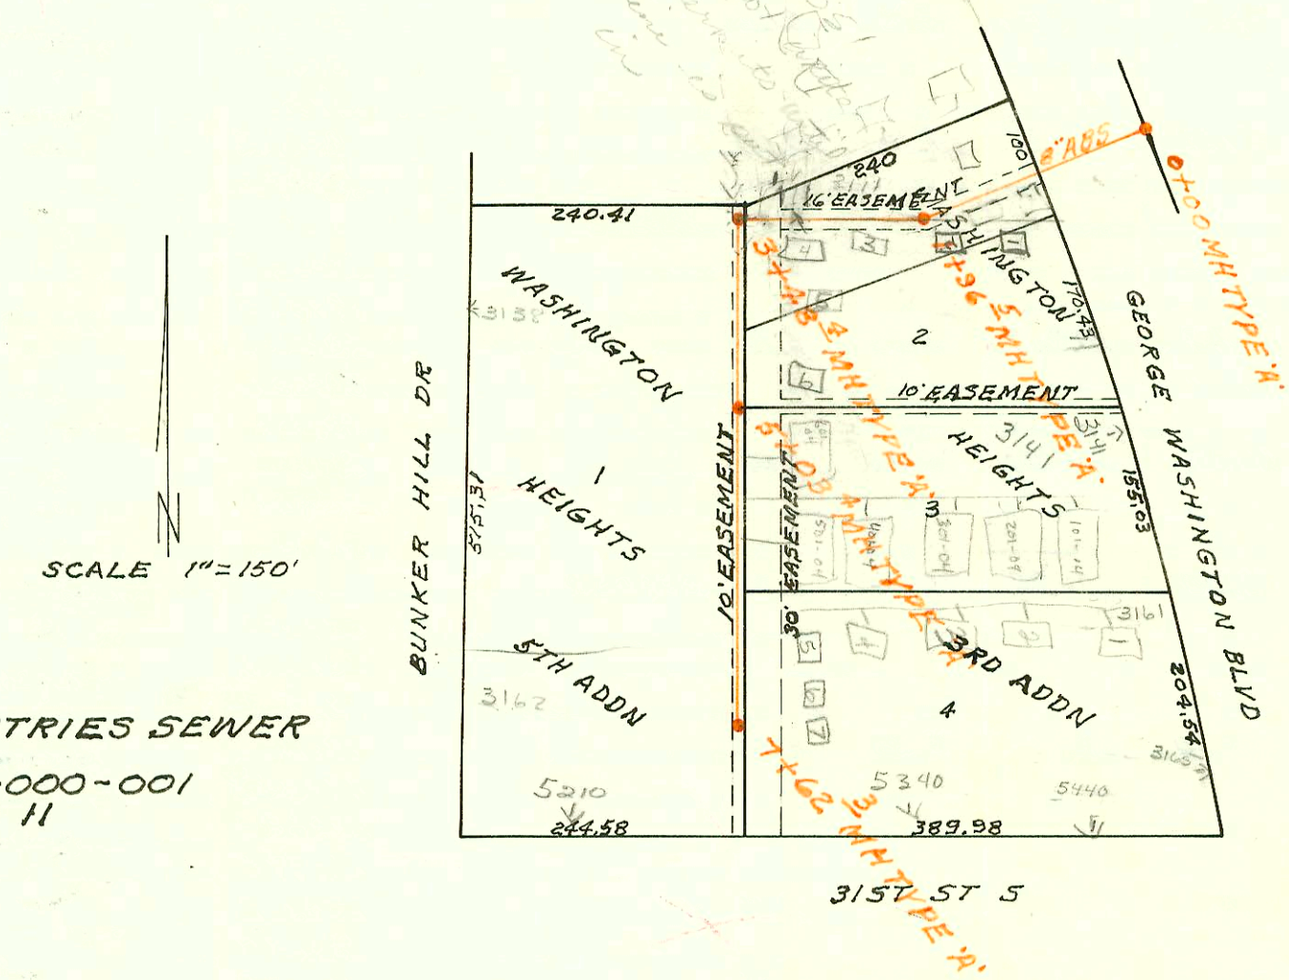

LATERAL 17 MAIN 10 WAR INDUSTRIES SEWER
BUILT BY: UTILITY CONTR. INC.
PROJ. № 468-76-245-80827-000-000-001
BOOKED 2-23-80 FROM JLA 11

ON MAP

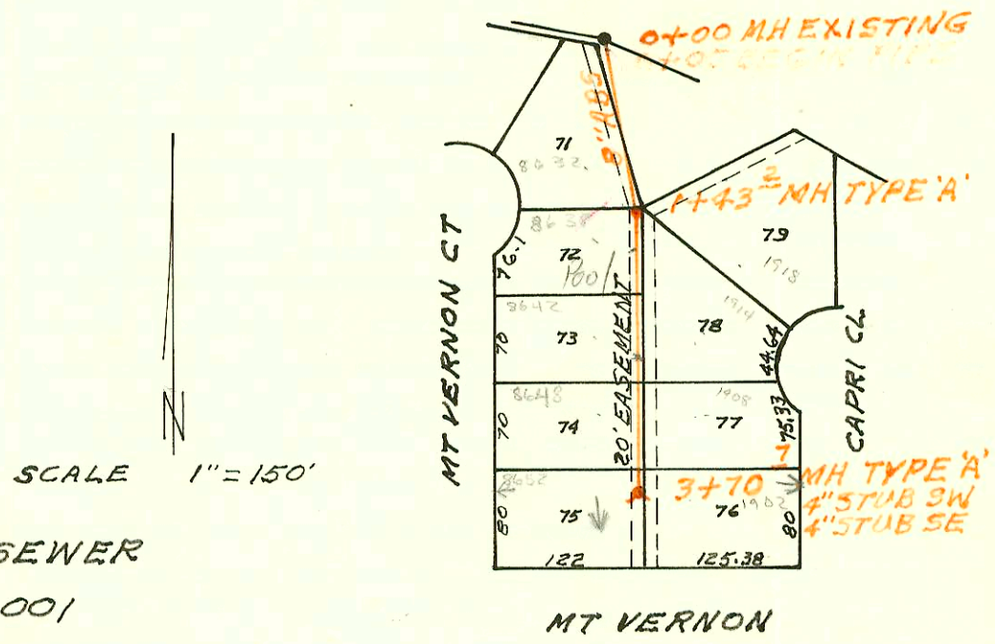

LATERAL 4 MAIN 21 WAR INDUSTRIES SEWER
BUILT BY: W B CARTER CONST. CO.
PROJ. № 468-76-245-80179-000-000-001
BOOKED 2-23-80 FROM AG9

ON MAP

E 99

Form 41-(54) 3-51

CONSTRUCTION RECORD							SERVICE RECORD					
STATION	ELEVATION Ground	ELEVATION Grade	Depth	MANHOLE	4-INCH "Y" BRANCHES North West	4-INCH "Y" BRANCHES South East	No. of Permit North West	No. of Permit South East	House Number North West	House Number South East	DATE OF PERMITS North West	DATE OF PERMITS South East
LATERAL 22 MAIN 3 SOUTHWEST INTERCEPTOR												
0+00	82.8	75.07	7.7	0+00 EXISTING								
1+00	81.9	75.27	6.6		1+22.0 tap	1+26.0 TAP	6194	20981	5330 S. Seneca	5340 S. Seneca	7-21-82	6-28-88
2+00	81.3	75.47	5.8									
	81.7	75.54	6.2	2+36.2	2+30.2	2+47.2 TAP	18507	25205	1033 Mona	1024 W. Lockwood	6-16-87	4-23-90
3+00	82.3	75.67	6.6		3+29.2 tap	3+13.4 tap	7351	4442	1011 W. Mona	1012 Lockwood	1-12-83	10-26-81
4+00	83.3	75.87	7.4			4+57.1 tap		14294		1000 W Lockwood		7-19-85
	82.6	76.02	6.6	4+73.6	4+34.6		C75426		1001 W Mona		11-26-79	
5+00	82.5	76.07	6.4									
					5+36.6	5+53.8	C75427	C76100	933 W. Mona	934 W Lockwood	11-26-79	1-14-80
6+00	82.3	76.27	6.0									
					6+62.0	6+47.9 tap	C75428	1547	923 W Mona	926 Lockwood	11-26-79	10-20-80
7+00	81.9	76.47	5.4									10-20-80
	81.9	OUT 76.49 IN 76.59	5.4 5.3	7+11.1								
					7+73.5	7+70.1 tap	C75429	1133	911 W Mona	920 Lockwood	11-26-79	9-4-80
8+00	81.9	76.77	5.1		8+45.4	8+25.5 tap	C75430	2034	901 W Mona	908 Lockwood	11-26-79	12-5-80
					8+85.5 tap		7433		843 W. Mona		1-26-83	
9+00	81.8	76.97	4.8			9+06.5 tap		2033		900 Lockwood		12-5-80
	81.7	OUT 77.09 IN 77.19	4.6 4.5	9+61.5								
10+00	81.8	77.27	4.5									
					10+56.0 tap	10+42.5 tap	26999	14010	831 Mona	860 Lockwood	2-5-91	6-17-85
11+00	81.4	77.47	3.9		11+14.2 tap	11+36.1 tap	5405	18150	819 Mona	854 Lockwood	3-22-82	4-21-87
	81.6	77.67	3.9	11+97.7	4" stub E	~~4" STUB E~~ 4" STUB S	5067	13499	831 Mona	849 Lockwood	1-14-82	4-7-85
LATERAL 17 MAIN 10 WAR INDUSTRIES SEWER												
0+00	160.2	151.00	9.2	0+00								
1+00	161.3	151.30	10.0									
	161.2	151.59	9.6	1+96.5		1+30.5		C76825		3121 Geo. Wash. Blvd #1		3-14-80
						1+84.9		C76826		Geo. Wash. #2		3-14-80
2+00	161.2	151.60	9.6		2+05.6 tap	2+14.5 tap	C76824	C76827	3111 George Washington Blvd	Geo. #3	3-14-80	3-14-80
						2+91.30 tap		C76828		Geo. 3121 #4		3-14-80
3+00	158.5	151.90	6.6									
	157.3	OUT 152.05 IN 152.15	5.3 5.2	3+48.4								
4+00	157.8	152.35	5.5									
						4+52.4 tap		C76829		3121 Geo. #5		3-14-80
5+00	159.1	152.75	6.4									
	159.1	152.77	6.3	5+03.4		5+54.4 tap		C75678		3141 George Washington Blvd Bldg 6		
						5+77.4 tap		C75222		Bldg 1104 3141 George Washington Blvd		11-6-79
6+00	159.9	153.15	6.8		6+32.3 tap	6+02.0 tap	9-331467	C75677	5200 E 31st St	3141 George Wash. Blvd Bldg 5	9-23-91	11-6-79
						6+77.7 tap		1092		3161 George Wash. Blvd Bldg 5		8-27-80
7+00	161.6	153.55	8.1			7+42.5 tap		1093		3161 Bldg 6		8-27-80
	162.6	153.80	8.8	7+62.3		7+59.3 tap		1094		3161 Bldg 7		8-27-80
LATERAL 4 MAIN 21 WAR INDUSTRIES SEWER												
0+00	156.1	145.00	11.1	0+00 EXISTING	0+36 tap		14542		8632 E. Mt Vernon		8-14-85	
0+05												
1+00	155.3	145.70	9.6									
	156.0	OUT 146.00 IN 147.51	10.0 8.5	1+43.2								
					1+75.4 tap		5449		8638 Mt Vernon Ct		3-23-82	
2+00	158.0	148.36	9.6		4" SDR35	2+28.0 tap		15090		1914 Capri		11-20-85
					2+63.7 tap		6252		8642 Mt Vernon		7-27-82	
3+00	161.5	149.86	11.6		0+09.7 tap	3+33.1 tap	6251	9382	8648 Mt Vernon Ct	1908 Capri Ct	7-27-82	10-6-85
	164.6	150.92	13.7	3+70.7	4" ABS SW	4" ABS SE	7376	10375	8652 Mt Vernon Ct	1902 Capri	1-17-83	3-2-84

1088 3161 apt 1 George Wash. Blvd 8-27-80 B.S. 7+62.3 N
1089 apt 2 " " " " "
1090 apt 3 " " " " "
1091 apt 4 " " " " "
1092 apt 5 " " " " "
1093 apt 6 " " " " "
1094 apt 7 " " " " "

1-4 made 1 conn off 6" line 98' N of 7+62.3 (tap 6+64.3)