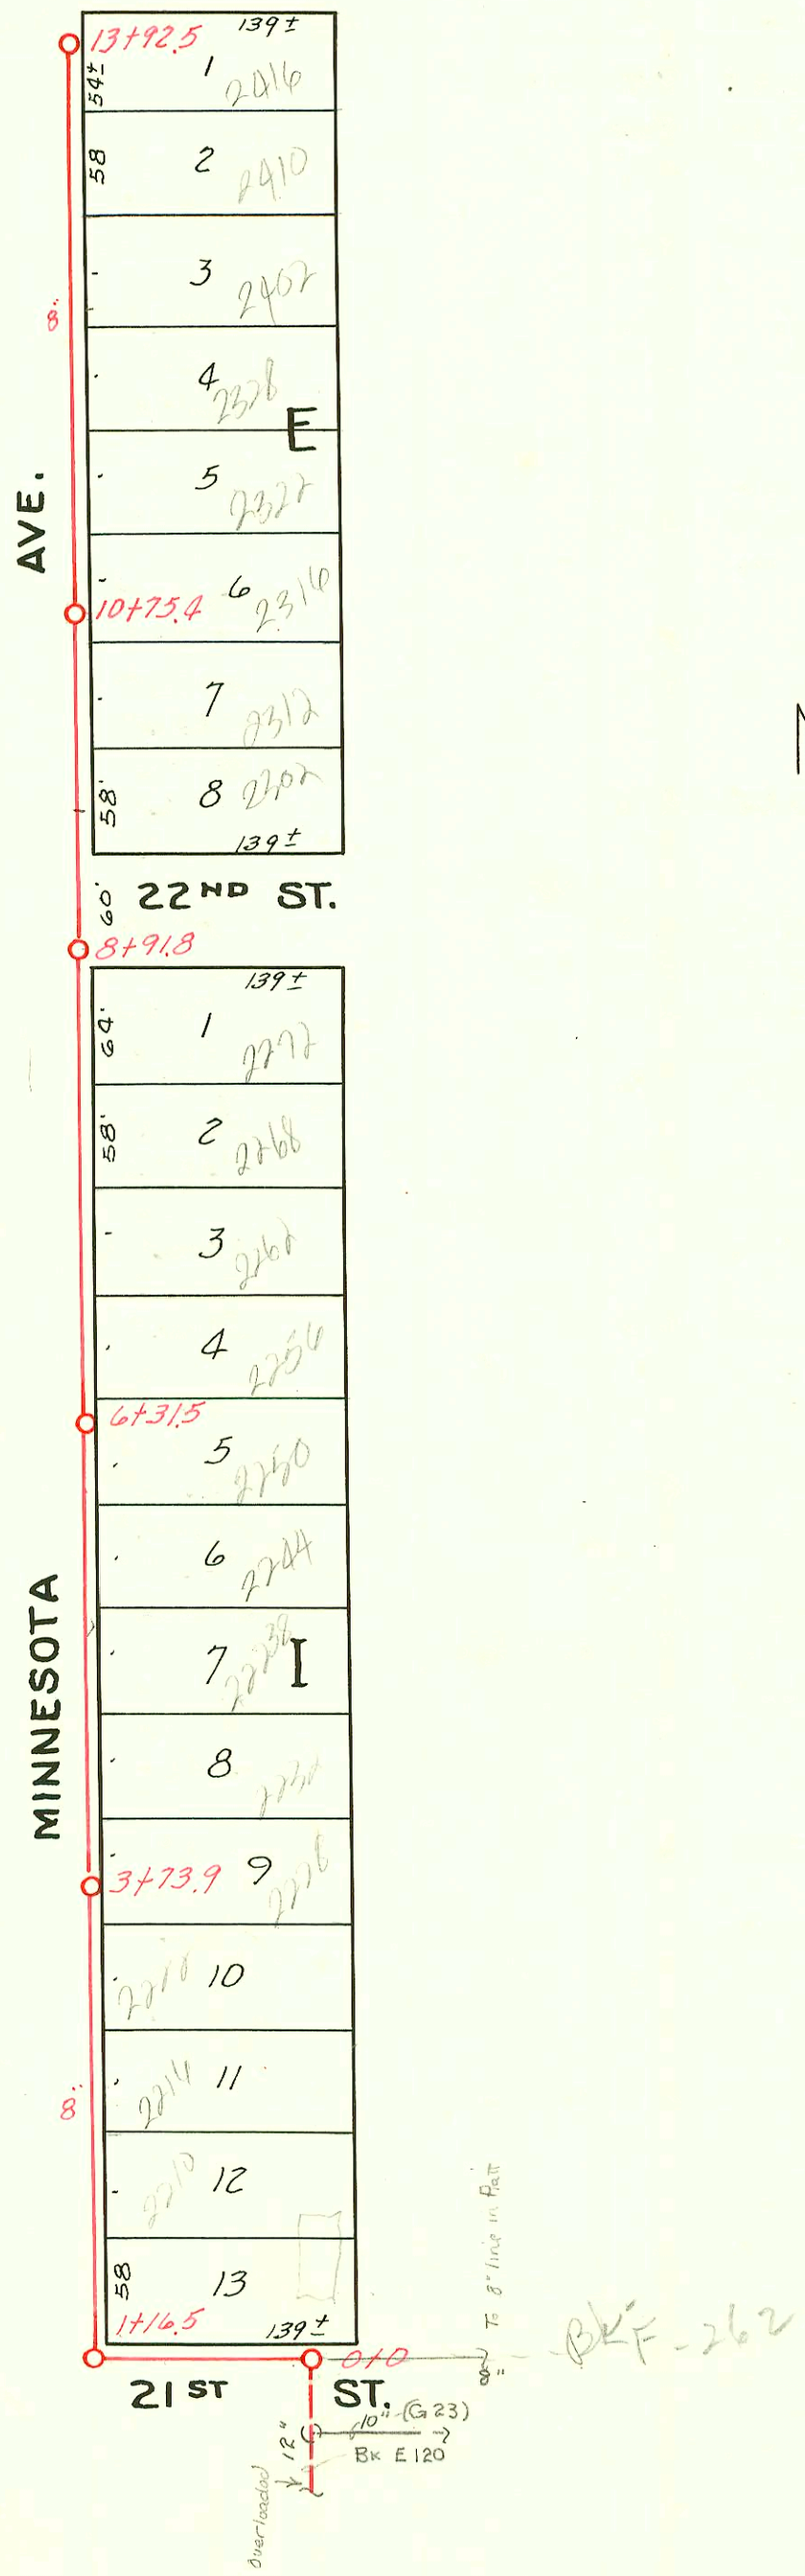

N

LAT. 1, DIST. T, S. S.# 12

W. B. CARTER 1941

123

Form 41-(54) 3-51

CONSTRUCTION RECORD							SERVICE RECORD					
STATION	ELEVATION		Depth	MANHOLE	4-INCH "Y" BRANCHES		No. of Permit		House Number		DATE OF PERMITS	
	Ground	Grade			North West	South East	North West	South East	North West	South East	North West	South East
0+0	123.70	114.44	9.26	0+0								
1+0	123.30	114.54	9.76									
	123.30	114.56	8.74	1+16.5								
						1+26.4						
						1+48.0		~~#C5011~~ 629		2202 N. Minnesota		9-26-67 11-15-41
						1+78.9						
2+0	122.80	114.64	8.16			2+06.0		#623		2210 N. Minnesota		11-15-41
						2+36.9						
						2+52.1		#627		2216 N. Minnesota		11-15-41
						2+94.3						
3+0	122.80	114.74	8.06			3+22.2		~~#13298~~ 626		2222 N. Minnesota		5-14-81 11-15-41
						3+52.2						
	122.90	114.81	8.09	3+73.9								
						3+82.5		#625		2228 N. Minnesota		11-15-41
4+0	122.90	114.84	8.06			~~4+13.2~~ 4+39.9		15 31 #624		2232 N. Minnesota		11-22-41 11-15-41
						4+40.0						
						4+67.8						
						4+98.0		#623		2238 N. Minnesota		11-15-41
5+0	123.00	114.94	8.06			5+28.0						
						5+46.3		#622		2244 N. Minnesota		11-15-41
						5+80.0						
6+0	123.10	115.04	8.06			6+10.8		#1514 621		2250 N. Minnesota		10-15-80 11-15-41
	123.20	115.07	8.13	6+31.5								
						6+45.6						
						6+59.4		#620		2256 N. Minnesota		11-15-41
7+0	123.40	115.14	8.26			7+02.5						
						7+29.6		#619		2262 N. Minnesota		11-15-41
						7+60.2						
						7+87.8		#618		2268 N. Minnesota		11-15-41
8+0	123.60	115.24	8.36			8+18.4						
						8+39.6		#617		2272 N. Minnesota		11-15-41
						8+64.4						
	123.60	115.33	8.27	8+91.8								
9+0	123.60	115.34	8.26			9+41.3		93-20975 599		2302 N. Minnesota		8-10-93 11-15-41
						9+69.4						
						9+96.5						
10+0	124.30	115.44	8.86			10+26.4		#593		2312 N. Minnesota		11-15-41
						10+48.2						
						10+69.8		#~~594~~ 597		2316 N. Minnesota		8-20-82 11-15-41
				10+75.4								
11+0	124.20	115.54	8.66			11+06.8						
						11+41.2		#596		2322 N. Minnesota		11-15-41
						11+69.0						
						11+98.4		#595		2328 N. Minnesota		11-15-41
12+0	124.70	115.64	9.06			12+22.9						
						12+45.0		~~2002-00073~~ #594		2402 N. Minnesota		1-8-02 11-15-41
						12+79.4						
13+0	124.90	115.74	9.16			13+17.5		#593		2410 N. Minnesota		11-15-41
						13+39.4						
						13+66.4		#592		2416 N. Minnesota		11-15-41
	125.00	115.83	9.17	13+92.5								