


HILLSIDE

AVE.

23185
SCHOOL

2161 S. Hillside

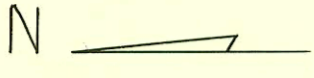

LOKRAIRP

See H-46

Chanayung
0181

5-Rip

See G-202

8" V.C.P.

Volusia

W. Rim MH 7845

0121
2127

Fstelle ST

2127 2121

See G-68

GREEN ST

0190

W. Rim MH 7427

Poplar

1135
0.30' / 16'

42" College Hill Sewer

0+0
S. Rim MH 7752
C3

GROVE

ST.

See G-147 10-65

Scale 1" = 150'

SOUTH HILLSIDE SCHOOL SANITARY SEWER

CONSTRUCTION RECORD						SERVICE RECORD						
STATION	ELEVATION		Depth	MANHOLE	4-INCH "Y" BRANCHES		No. of Permit		House Number		DATE OF PERMITS	
	Ground	Grade			North West	South East	North West	South East	North West	South East	North West	South East
0+0	97.2	90.52	6.7	0+0								
1+0												
2+0												
3+0												
4+0												
5+0												
6+0	96.9	92.35	4.5	6+0								
7+0												
8+0												
9+0												
10+0												
11+0												
12+0	98.0	93.93	4.1	12+0								
13+0												
14+0												
15+0												
16+0												
17+0												
18+0				18+0								
19+0												
20+0												
21+0												
22+0												
23+0												
23+85	End of Line											

C 73156- 2161 So. Hillside - portable Bldg - 7-23-79 (tap 18+05)