E 182 A

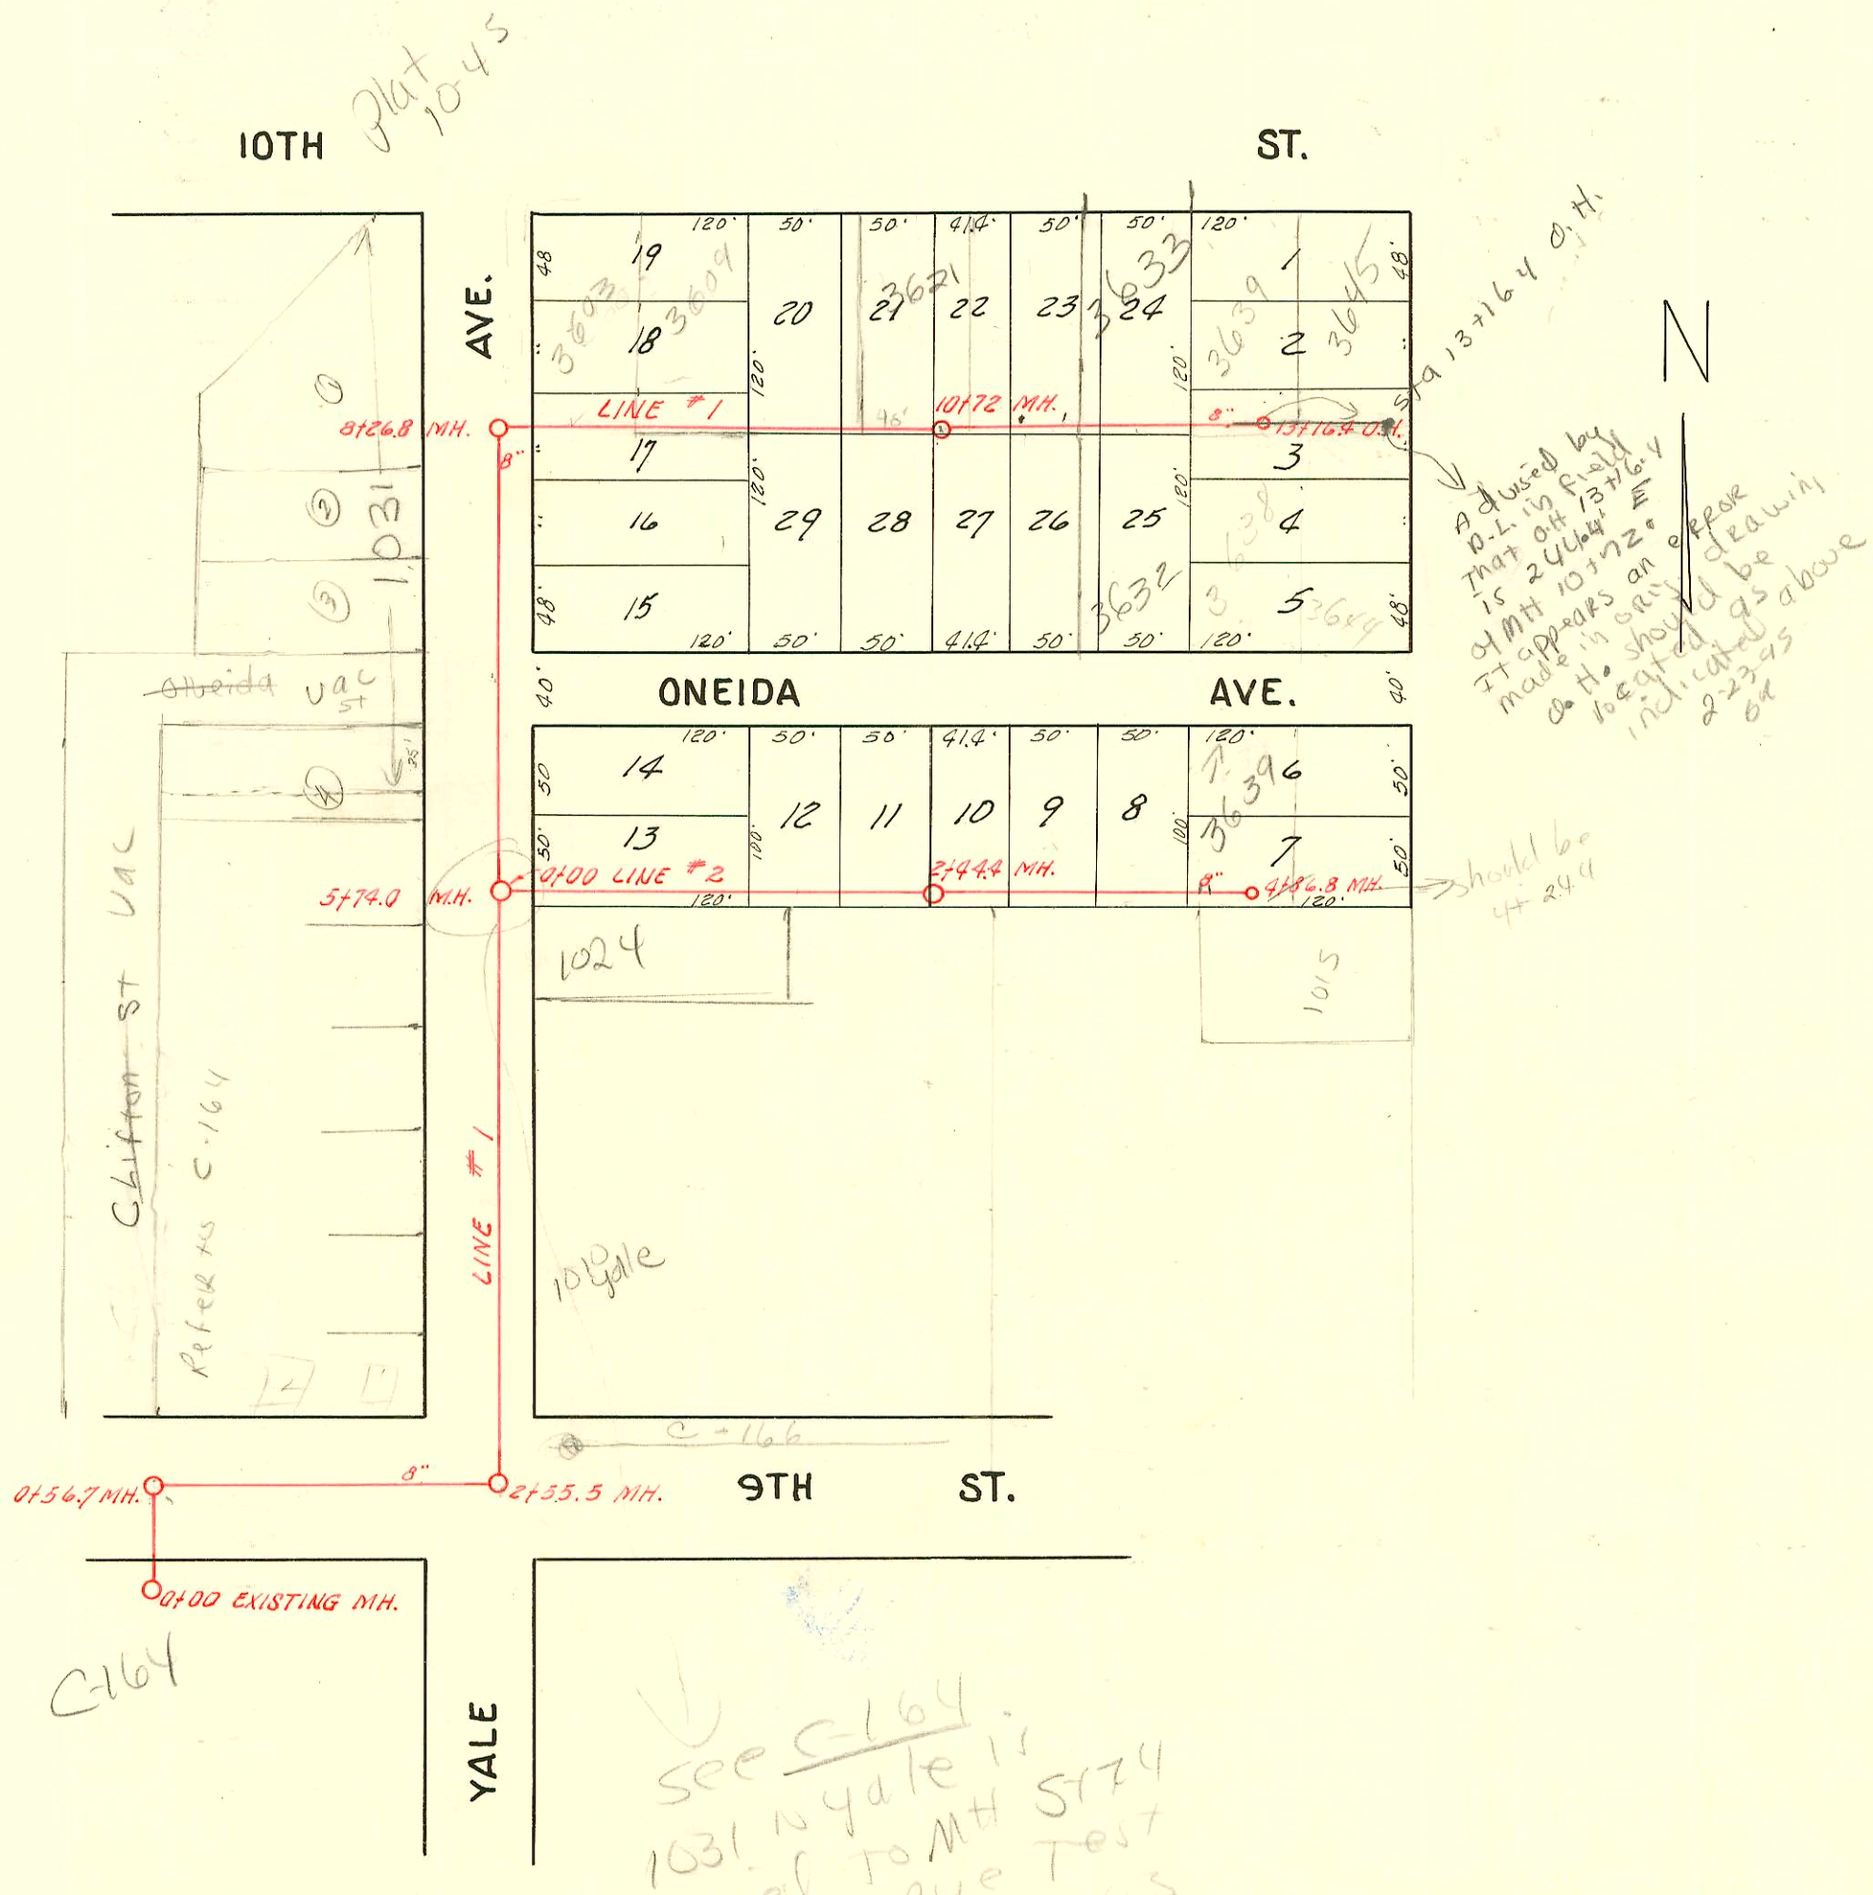

2002-00599-3/6/02-3633 E 10th St- Clear Water Exc- 88'E of MH 10+72(11+60) 4"SCH40 PVC - Replaced 16' Low end 1U22, PVC Saddle

2002-03296-12/6/02-1024 N Yale - A Good Plbr - city wye repair 4" predco 66'E of MH 0+00 (0+66) 1H45, 1U45, 1U22, 1TW1(1)CO 4"40 PVC

LAT. 9, DIST. D, S. S. 12

W. B. CARTER 1946

Form 41-(54) 8-53

	CONSTRUCTION RECORD							SERVICE RECORD					
	STATION	ELEVATION		Depth	MANHOLE	4-INCH "Y" BRANCHES		No. of Permit		House Number		DATE OF PERMITS	
		Ground	Grade			North ~~West~~	South ~~East~~	North West	South East	North West	South East	North West	South East
LINE #1	0+0	180.8	170.27	11.45	0+0								
	0+56.7	179.2	170.33	9.15	0+56.7								
	1+0	180.8	170.37	10.51									
	2+0	183.0	170.47	12.82									
	2+55.5	183.8	170.52	13.26	2+55.5								
	3+0	183.7	170.57	13.13			Riser – East 3+91.6		98-8337		1010 N Yale		5-17-98
	4+0	183.3	170.67	12.67							see #166 for orig conn		
	5+0	183.2	170.72	12.47									
	5+74.0	181.1	170.84	10.21	(0+0 Line #2) 5+74.0								
	6+0	180.0	170.87	9.15									
	7+0	177.8	170.97	6.79									
	8+0	175.6	171.07	4.56									
	8+26.8	175.2	171.10	4.10	8+26.8								
						8+71.0	Conn. 8+68.0	#435	#133	3623 E. 10th	3642 Oneida	7-23-46	5-22-46
						8+99.2	8+96.2						
	9+0	178.1	172.72	5.74									
						9+33.9	Conn. 9+30.9	#436	#135	3609 E. 10th	3638 Oneida	7-23-46	5-22-46
						9+62.1	9+59.1						
						9+90.4	Conn. 9+87.4	#437	#138	3615 E. 10th	3614 Oneida	7-23-46	5-22-46
	10+0	182.2	174.95	7.57									
						10+19.6	10+16.6	20258		R		3-10-88	
						10+49.0	Conn. 10+46.0	#438	#141	3608 E. 10th	3620 Oneida	7-23-46	5-22-46
		185.4	176.55	9.22	10+72.0								
						10+81.5	10+78.5						
							Conn. 10+95.3		#143		3626 Oneida		5-22-46
	11+0	187.1	177.17	10.44									
						11+09.3		#439		3627 E. 10th		7-23-46	
						11+38.7	4" SCH 40 11+35.7	2002-00599 #440		A 3633 10th	see next pg	3-6-02 7-23-46	
						11+60.1	11+57.1						
						11+81.0	Install C.O. Conn. 11+78.0	#441	95-140577 144	3639 E. 10th	3632 Oneida	7-23-46	9-8-95 5-22-46
	12+0	191.4	179.40	12.11									
						12+18.7	12+15.7		#443		3638 Oneida		7-23-46
						12+38.6	12+35.6		#444		3644 Oneida		7-23-46
						12+72.4	12+69.4						
						12+98.3 S/O	12+95.3	95-17637 442		3645 E. 10th		2-8-95 7-23-46	
	13+16.4	193.2	182.0	11.28	13+16.4 (O.H.)	Tap 4" SR40 12+82.4		95-24657		3645 E 10th	NC	2-8-95	
LINE #2	0+0	180.8	174.00	6.80	Same 5+74 on line #1 0+0								
						0+31.3							
						0+42.1	Conn.	#134	1871	3602 Oneida	3604 E. 9th	5-22-46	11-11-50
							4" SCH 40 Riser 0+69.2		2002-03296 164		1024 R N. Yale	see next pg	12-6-02 5-24-46
						0+92.6							
	1+0	187.2	177.18	10.87									
							Conn. 1+27.7	#136		3607 Oneida		5-22-46	
							Conn. 1+45.5	#137		3611 Oneida		5-22-46	
						1+75.4							
	2+0	190.6	180.36	10.86									
						2+8.6	Conn. 2+9.5	#139		3615 Oneida		5-22-46	
	2+44.4	191.8	181.76	10.58	2+44.4								
						2+70.1	Conn. 2+85.4	#140		3619 Oneida		5-22-46	
	3+0	191.7	181.87	10.47									
						3+29.9							
						3+48.1		#142 24066		3622 Oneida		5-22-46 10-10-89	
						3+90.3		#447		3639 R Oneida		7-23-46	
	4+0	191.1	182.07	10.06									
						4+08.0		#448		3643 Oneida		7-23-46	
						4+43.6							
						4+61.5							
	4+86.8	190.7	182.24	9.07	4+86.8 (O.H.) 2								

#35 Tap – 1023 N. Roosevelt – Pray Bros 5-15-47
#72 Tap – 1017 N. Roosevelt – Pray Bros 5-23-47
#349 Tap – 1014-16 N. Yale – 7-1-48 – Pray Bros.
94-37927 #2984 – Tap – 1031 Rep Yale 3-21-94 10-27-52 – Pray Bros. Special fee $20.00 4" Sch 40. PVC