E 210 A

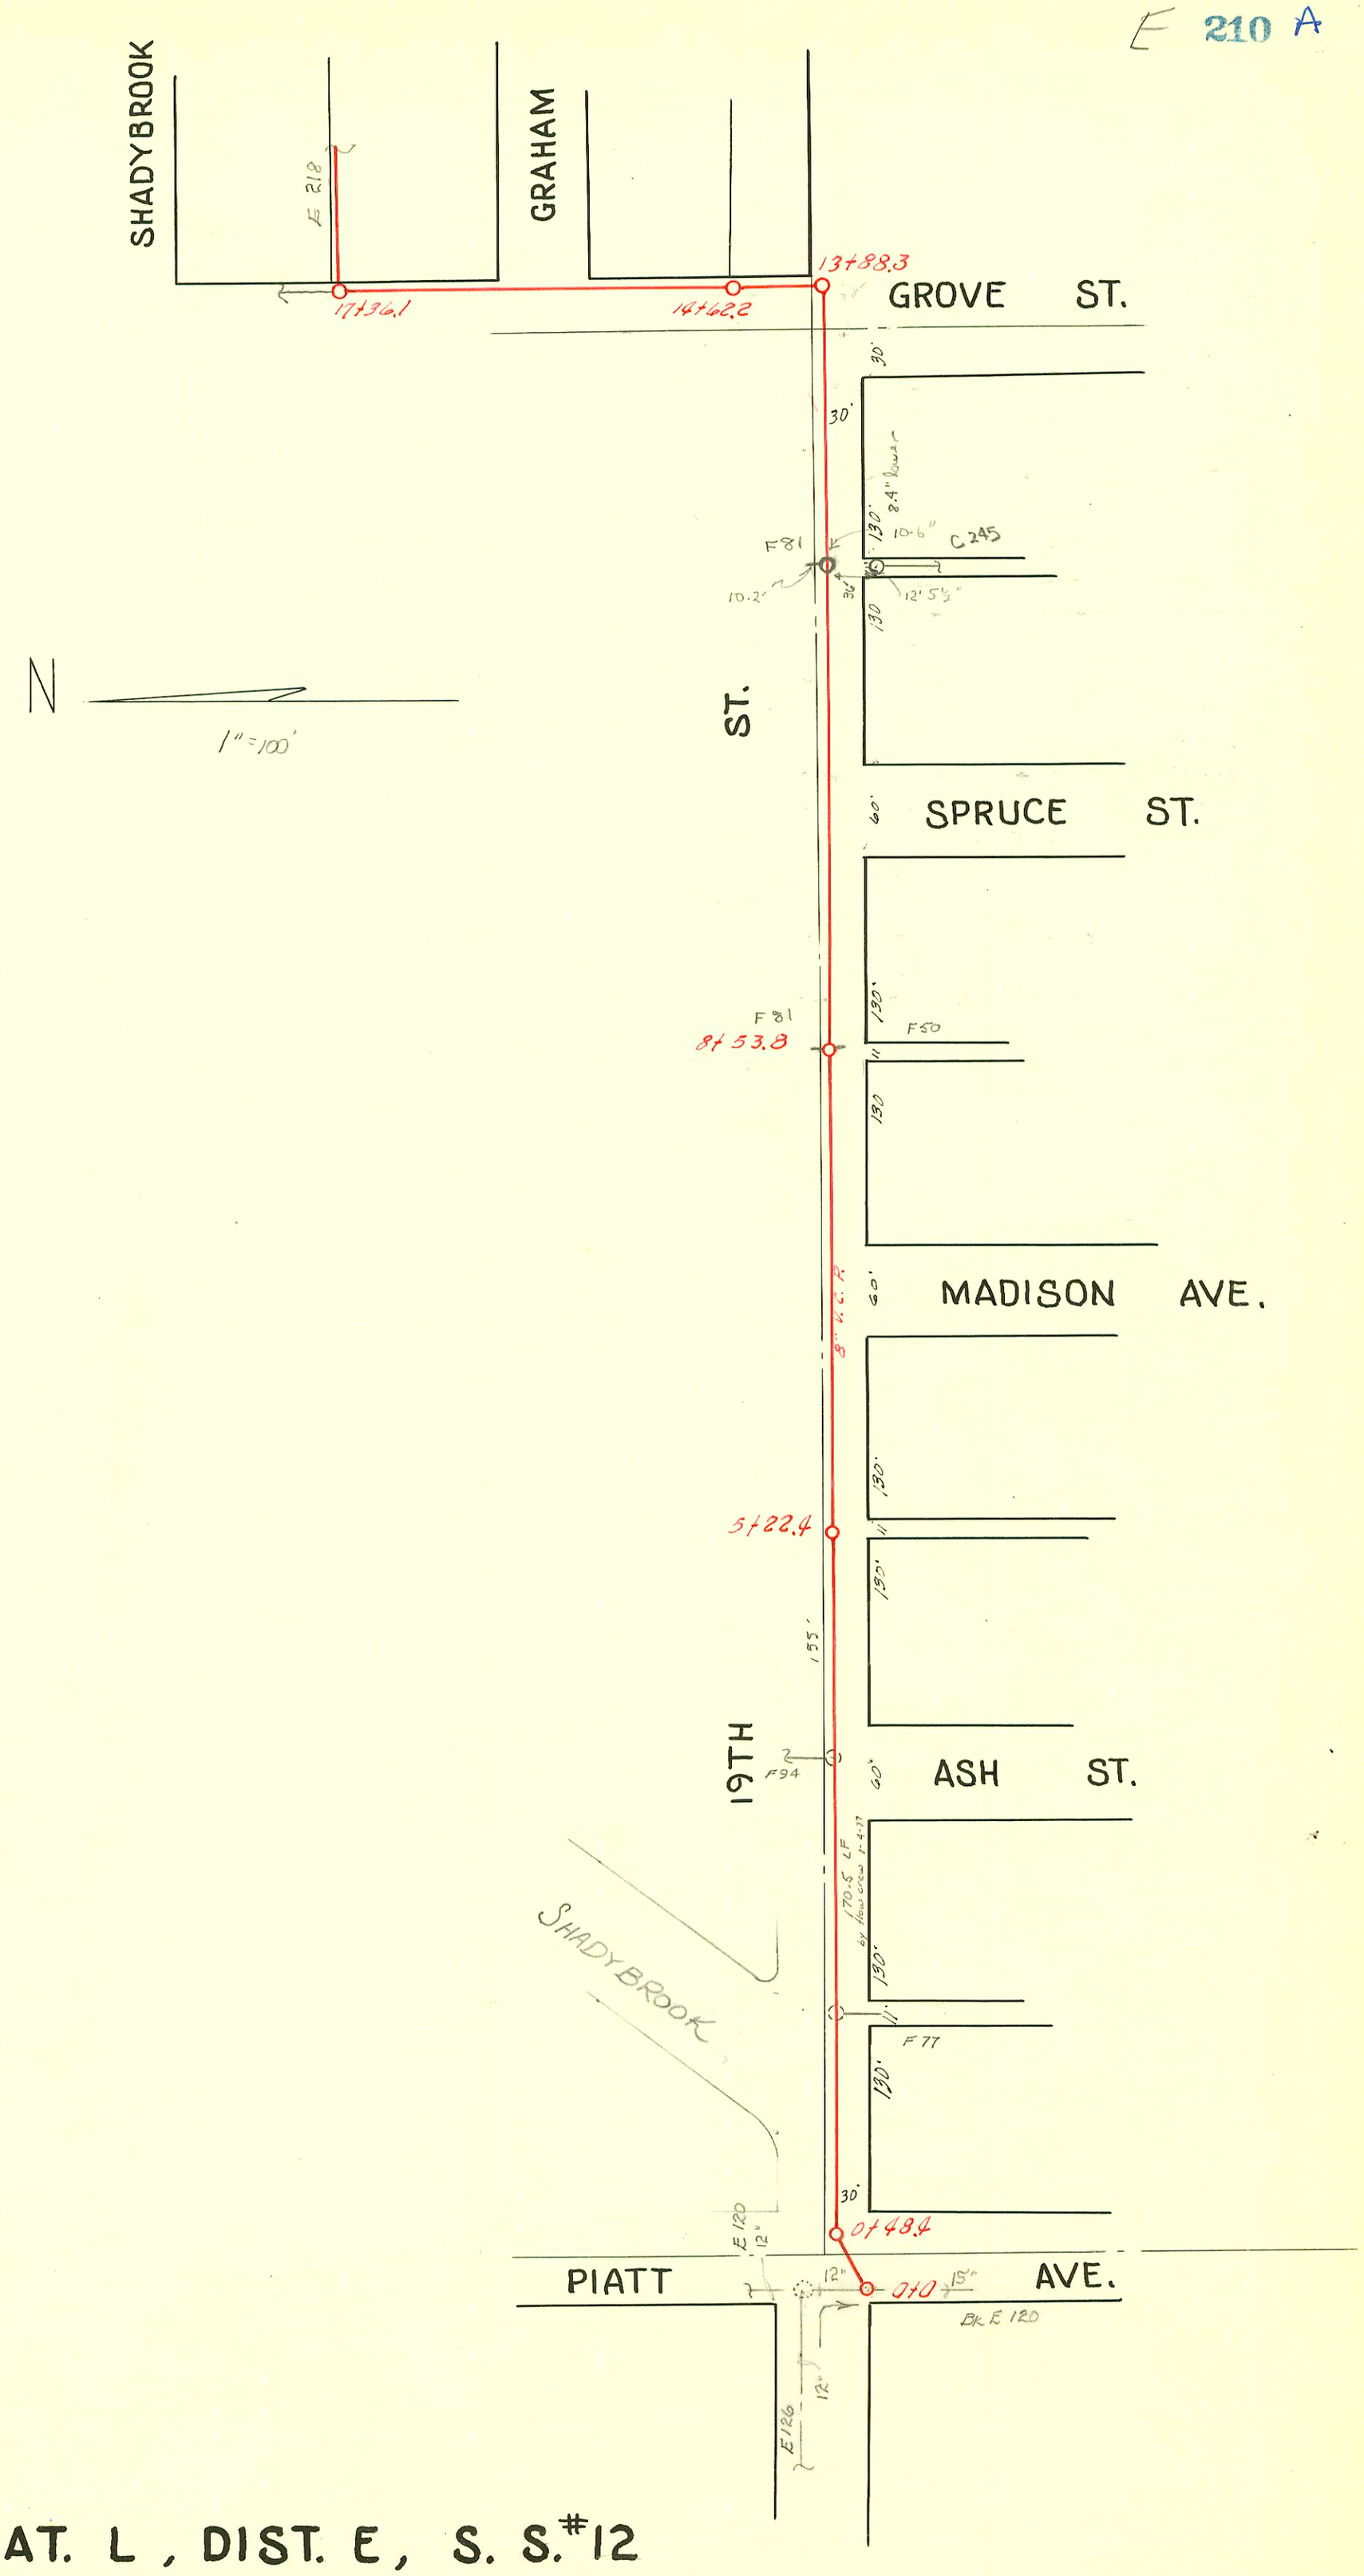

LAT. L , DIST. E , S. S. #12

W. B. CARTER 1942

Form 41-(54) 8-53

CONSTRUCTION RECORD							SERVICE RECORD					
STATION	ELEVATION		Depth	MANHOLE	4-INCH "Y" BRANCHES		No. of Permit		House Number		DATE OF PERMITS	
	Ground	Grade			North West	South East	North West	South East	North West	South East	North West	South East
0+0	122.60	113.00	9.6	0+0								
				0+48.4								
1+0	123.60	113.36	10.24									
2+0	123.50	113.72	9.78									
3+0	123.60	114.08	9.52									
4+0	123.70	114.44	9.26									
5+0	124.20	114.80	9.40									
	124.30	114.89	9.41	5+22.4								
6+0	125.10	115.16	9.94									
7+0	125.30	115.52	9.78									
8+0	125.80	115.88	9.92									
	126.20	116.06	10.14	8+53.8								
9+0	126.40	116.24	10.16									
10+0	126.80	116.60	10.20									
11+0	127.80	116.96	10.84									
12+0	129.30	117.32	11.98									
13+0	130.50	117.68	12.82									
	130.50	118.00 118.50		13+88.3								
14+0	130.40	118.52	11.88									
				14+62.2								
15+0	131.00	118.88	12.12									
16+0	131.30	119.24	12.06									
17+0	131.60	119.60	12.00									
				17+36.1								