E- 220 A

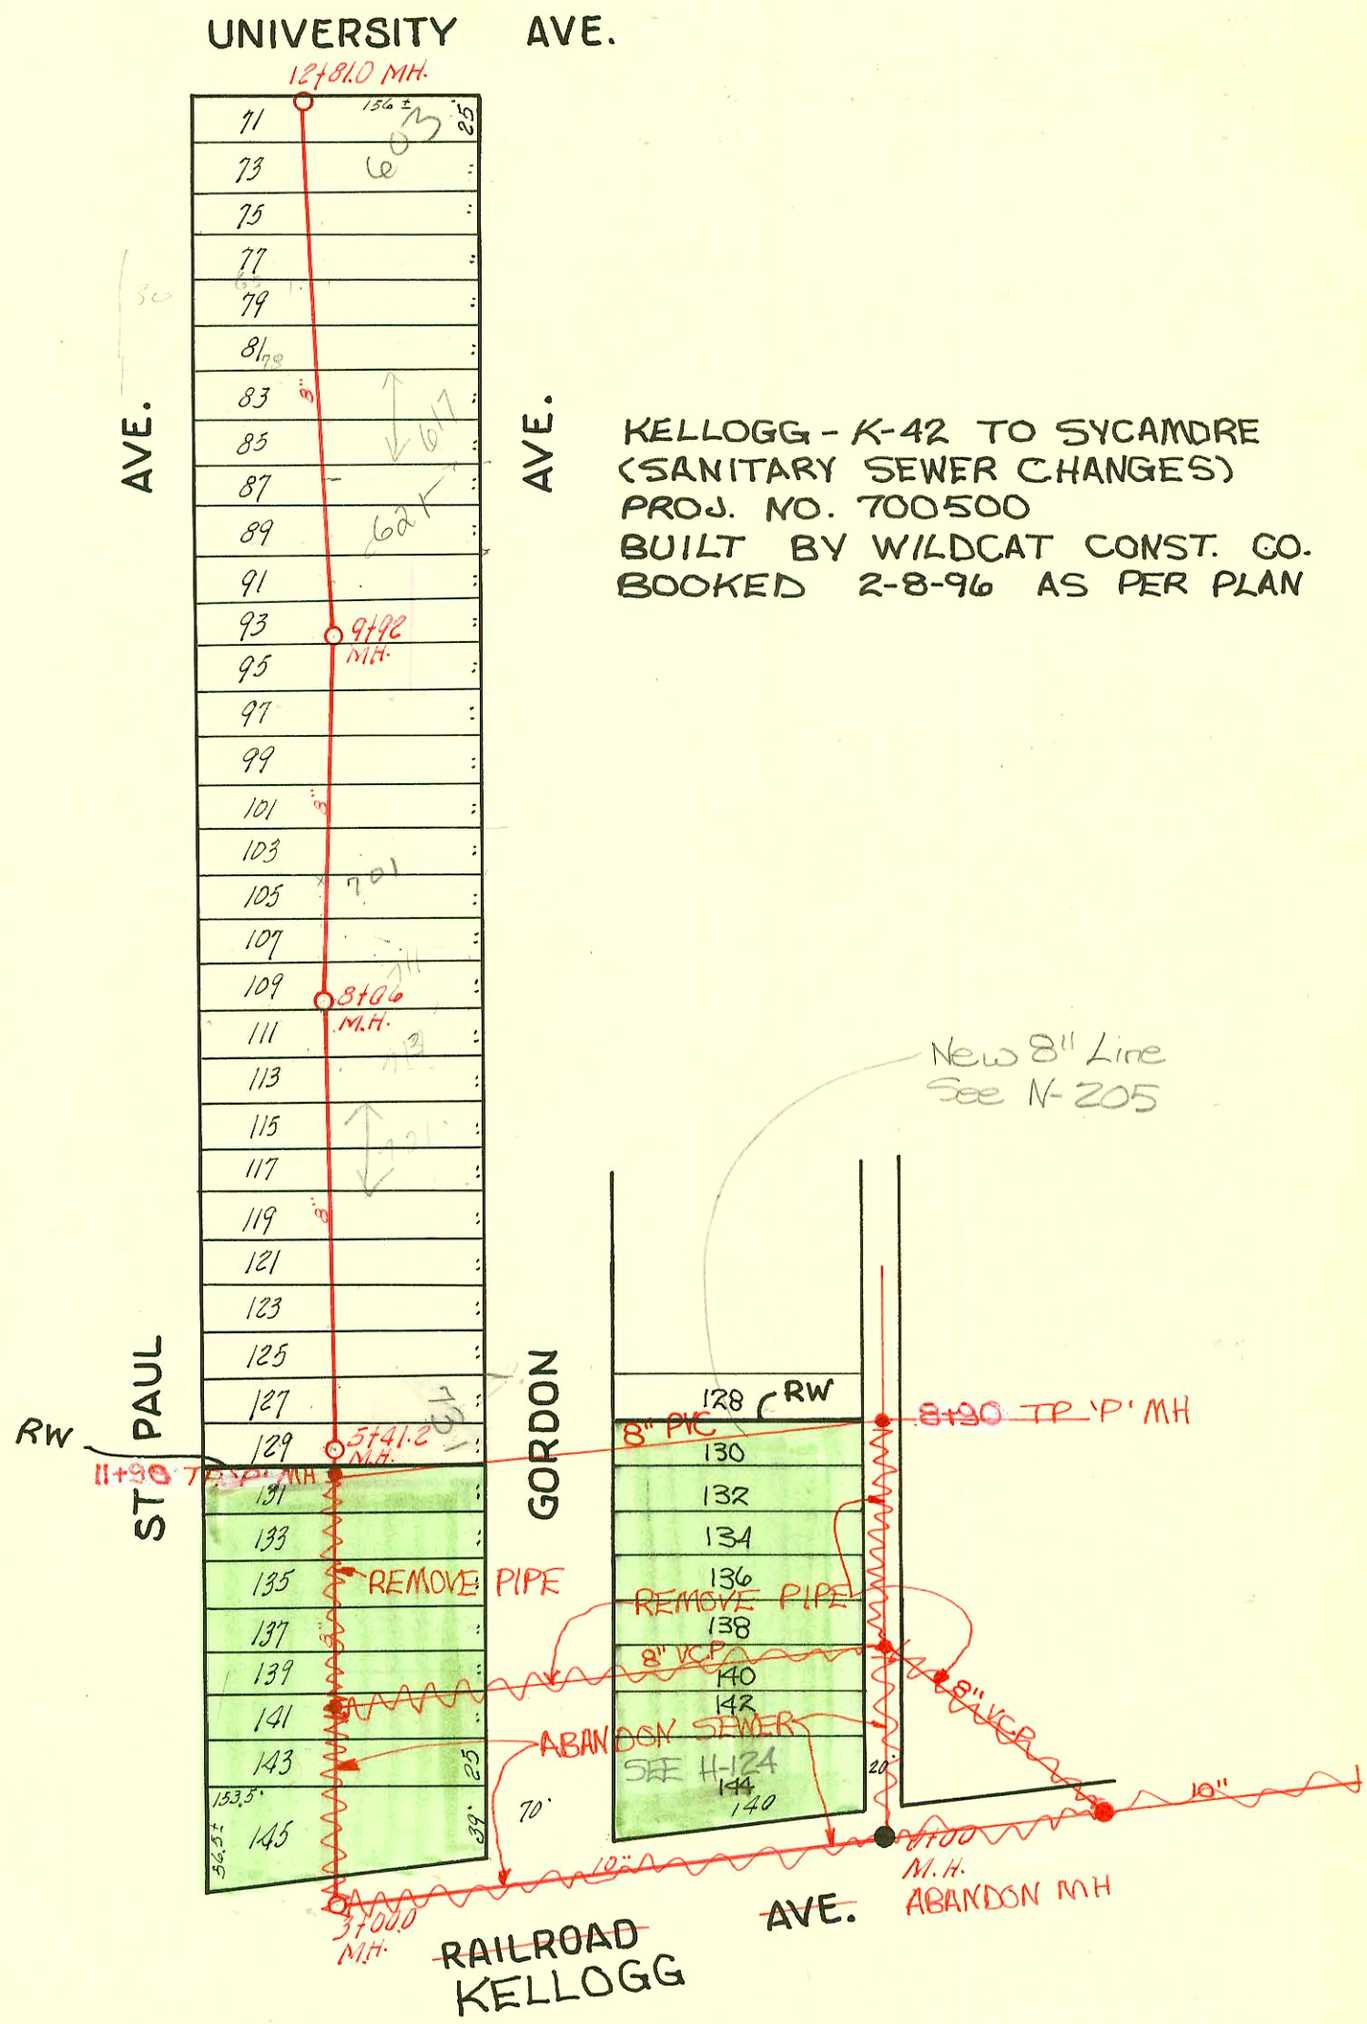

KELLOGG - K-42 TO SYCAMORE
(SANITARY SEWER CHANGES)
PROJ. NO. 700500
BUILT BY WILDCAT CONST. CO.
BOOKED 2-8-96 AS PER PLAN

LAT. 21, DIST. A, S. S.# 21
W. B. CARTER, 1946

Receipt #4837- Tap into MH 3+00 line to Sacred Heart College - 12-16-49 Wm B. Carter ($40.00 Special fee paid 1-27-50 by Ray Lyons. Receipt # 5946)

Form 41-(54) 8-53

CONSTRUCTION RECORD							SERVICE RECORD					
STATION	ELEVATION		Depth	MANHOLE	4-INCH "Y" BRANCHES		No. of Permit		House Number		DATE OF PERMITS	
	Ground	Grade			~~North~~ West	~~South~~ East	North West	South East	North West	South East	North West	South East
				0+00 Old M.H.								
0+0	112.71	106.31	6.40									
1+0	110.87	106.41	4.46									
2+0	110.69	106.51	4.18									
3+0	110.95	106.61	4.34	3+00								
					3+44.5	3+41.5						
					3+69.0	3+66.0						
					3+97.0	3+94.0						
4+0	111.09	106.88	4.21									
					4+20.8	4+17.8						
					4+46.0	4+43.0						
					4+69.7	4+66.7						
					4+94.0	4+91.0						
5+0	110.88	106.98	3.90									
					5+19.0	5+16.0						
					5+37.5	5+34.5						
				5+41.2								
					5+68.5	5+65.5	5143		731 S. Gordon		2-1-82	
					5+92.5	5+89.5						
6+0	110.97	107.08	3.89									
					6+16.0	6+13.0						
					6+47.0	6+44.0	#3120		727 S. Gordon R		11-5-52	
					6+71.5	6+68.5						
7+0	111.13	107.18	3.95									
					7+05.0	7+02.0						
					7+29.3	7+26.3	#6967		721 S. Gordon		11-13-53	
					7+57.3	7+54.3	1579		713 Gordon R		10-24-80	
					7+81.4	7+78.4						
8+0	111.74	107.28	4.46									
				8+06.0								
					8+13.5	8+10.5						
					8+26.0	8+23.0	3259		711 S. Gordon		5-6-81	
					8+57.2	8+54.2						
					8+81.0	8+78.0	#3063		701 S. Gordon		12-10-52	
9+0	111.37	107.38	3.99									
					9+06.0	9+03.0						
					9+29.8	9+26.8						
					9+65.0	9+62.0						
					9+79.5	9+76.5						
				9+92.0								
10+0	111.41	107.48										
					10+07.0	10+04.0						
					10+31.6	10+28.6	#4082		627 S. Gordon		3-14-51	
					10+55.7	10+52.7						
					10+83.0	10+80.0	#4081		621 S. Gordon		3-14-51	
11+0	111.30	107.58	3.72									
					11+07.2	11+04.2						
					11+32.4	11+29.4	#3761		617 S. Gordon		1-23-51	
					11+57.0	11+54.0						
					11+84.5	11+81.5	#511		611 S. Gordon		7-28-47	
12+0	111.58	107.68	3.90									
					12+12.0	12+09.0						
					12+36.7	12+33.7	98737		605 S. Gordon R		1-5-98	
					12+68.0	12+65.0	#798				6-28-54	
				12+81.0								