

ABANDONED  
See Blk. D  
Page 6.  
E 243  
hosed  
in to 33" bell (replaced 32" line)  
Grain Elevator  
Drainage  
Catch Basins

PRIVATE LINE  
W. B. CARTER  
1945

Crested  
37'  
6"


550 E  
17th

540 E  
17th

4+05.5  
8"

4+77.1

7+89.8  
O.H.

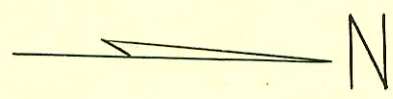

**RECONSTRUCTION S. S. NO. 20**  
W. B. CARTER, 1944

CONSTRUCTION RECORD

SERVICE RECORD

STATION	ELEVATION		Depth	MANHOLE	4-INCH "Y" BRANCHES		No. of Permit		House Number		DATE OF PERMITS	
	Ground	Grade			North West	South East	North West	South East	North West	South East	North West	South East
64+00	117.8	105.12	12.7									
65+00	117.8	105.20	12.6									
66+00	117.3	105.28	12.0									
		105.30	12.3	6+24.0								
67+00	117.6	105.36	12.2									
68+00	117.4	105.44	12.0									
69+00	117.4	105.52	11.9									
		105.57		+67.2								
70+00	117.4	105.60	11.8									
71+00	117.3	105.68	12.1									
72+00	117.5	105.76	11.7									
		105.82		+81.0								
73+00	118.1	105.84	12.3									
74+00	118.1	105.92	12.2									
75+00	119.8	106.00	13.8									
		106.08		+95.8								
76+00	119.3	106.08	13.2									
		106.11		+41.9								
77+00	119.1	106.16	12.9									
78+00	119.1	106.24	12.9									
79+00	119.2	106.32	12.9									
80+00	119.4	106.40	13.0									
81+00	119.6	106.48	13.1									
		106.50		+26.7								
		106.54		+82.5								
82+00	119.8	106.56	13.2									
83+00	119.8	106.64	13.2									
		106.65		+16.9								
84+00	119.5	106.72	12.8									
85+00	119.8	106.80	13.0									
86+00	119.7	106.88	12.8									
		106.93		+73.9								
87+00	119.9	106.95	13.0									
88+00	120.2	107.02	13.2									
		107.05		+44.4								
		107.07		+77.9								
89+00	119.7	107.09	12.6									
90+00	119.8	107.16	12.6									
91+00	120.1	107.23	12.9									
92+00	120.3	107.30	13.0									
		107.35		+72.4								
93+00	120.5	107.37	13.1									
		107.38		+17.4								
94+00	121.0	107.45	13.5									
95+00	121.3	107.52	13.8									
		107.59		+96.7								
96+00	121.1	107.59	13.5									
		107.64		+70.3								
97+00	121.6	107.66	13.9									
98+00	121.9	107.73	14.2									
99+00	122.2	107.80	14.4									
		107.86		+89.0								
100+00	122.3	107.87	14.4									
		107.89		+27.1								
<hr/>												
0+0	121.0	111.77	9.2	0+0								
1+0	121.6	111.92	9.7									
2+0	121.6	112.07	9.5									
3+0	121.7	112.22	9.5									
4+0	121.9	112.38	9.5									
		112.44		4+05.5								
	122.0	116.10		4+77.1								
5+0	122.1	116.13	6.0									
6+0	121.8	116.28	5.5									
7+0	121.8	116.43	5.4									
				O.H. 7+89.8								
				6+07.1 Tee 4" PUCHO 7+50.1				286 2003 00047		540 E 17th 550 E 17th		5-12-80 1-7-03

13  
12-145

Private Line  
Linde Air Products Co.

26519  
570 # 2320 - Top in 15th St. Sewer (4" E. 15th) - 10-9-45 - Nelson Hlog Co. (681762)  
# 200 No. 540 E. 17th N. Ferry. 5-12-80 (Set 4" Tee for no. approx 130' E of 4+77.1 MH)