E251 A

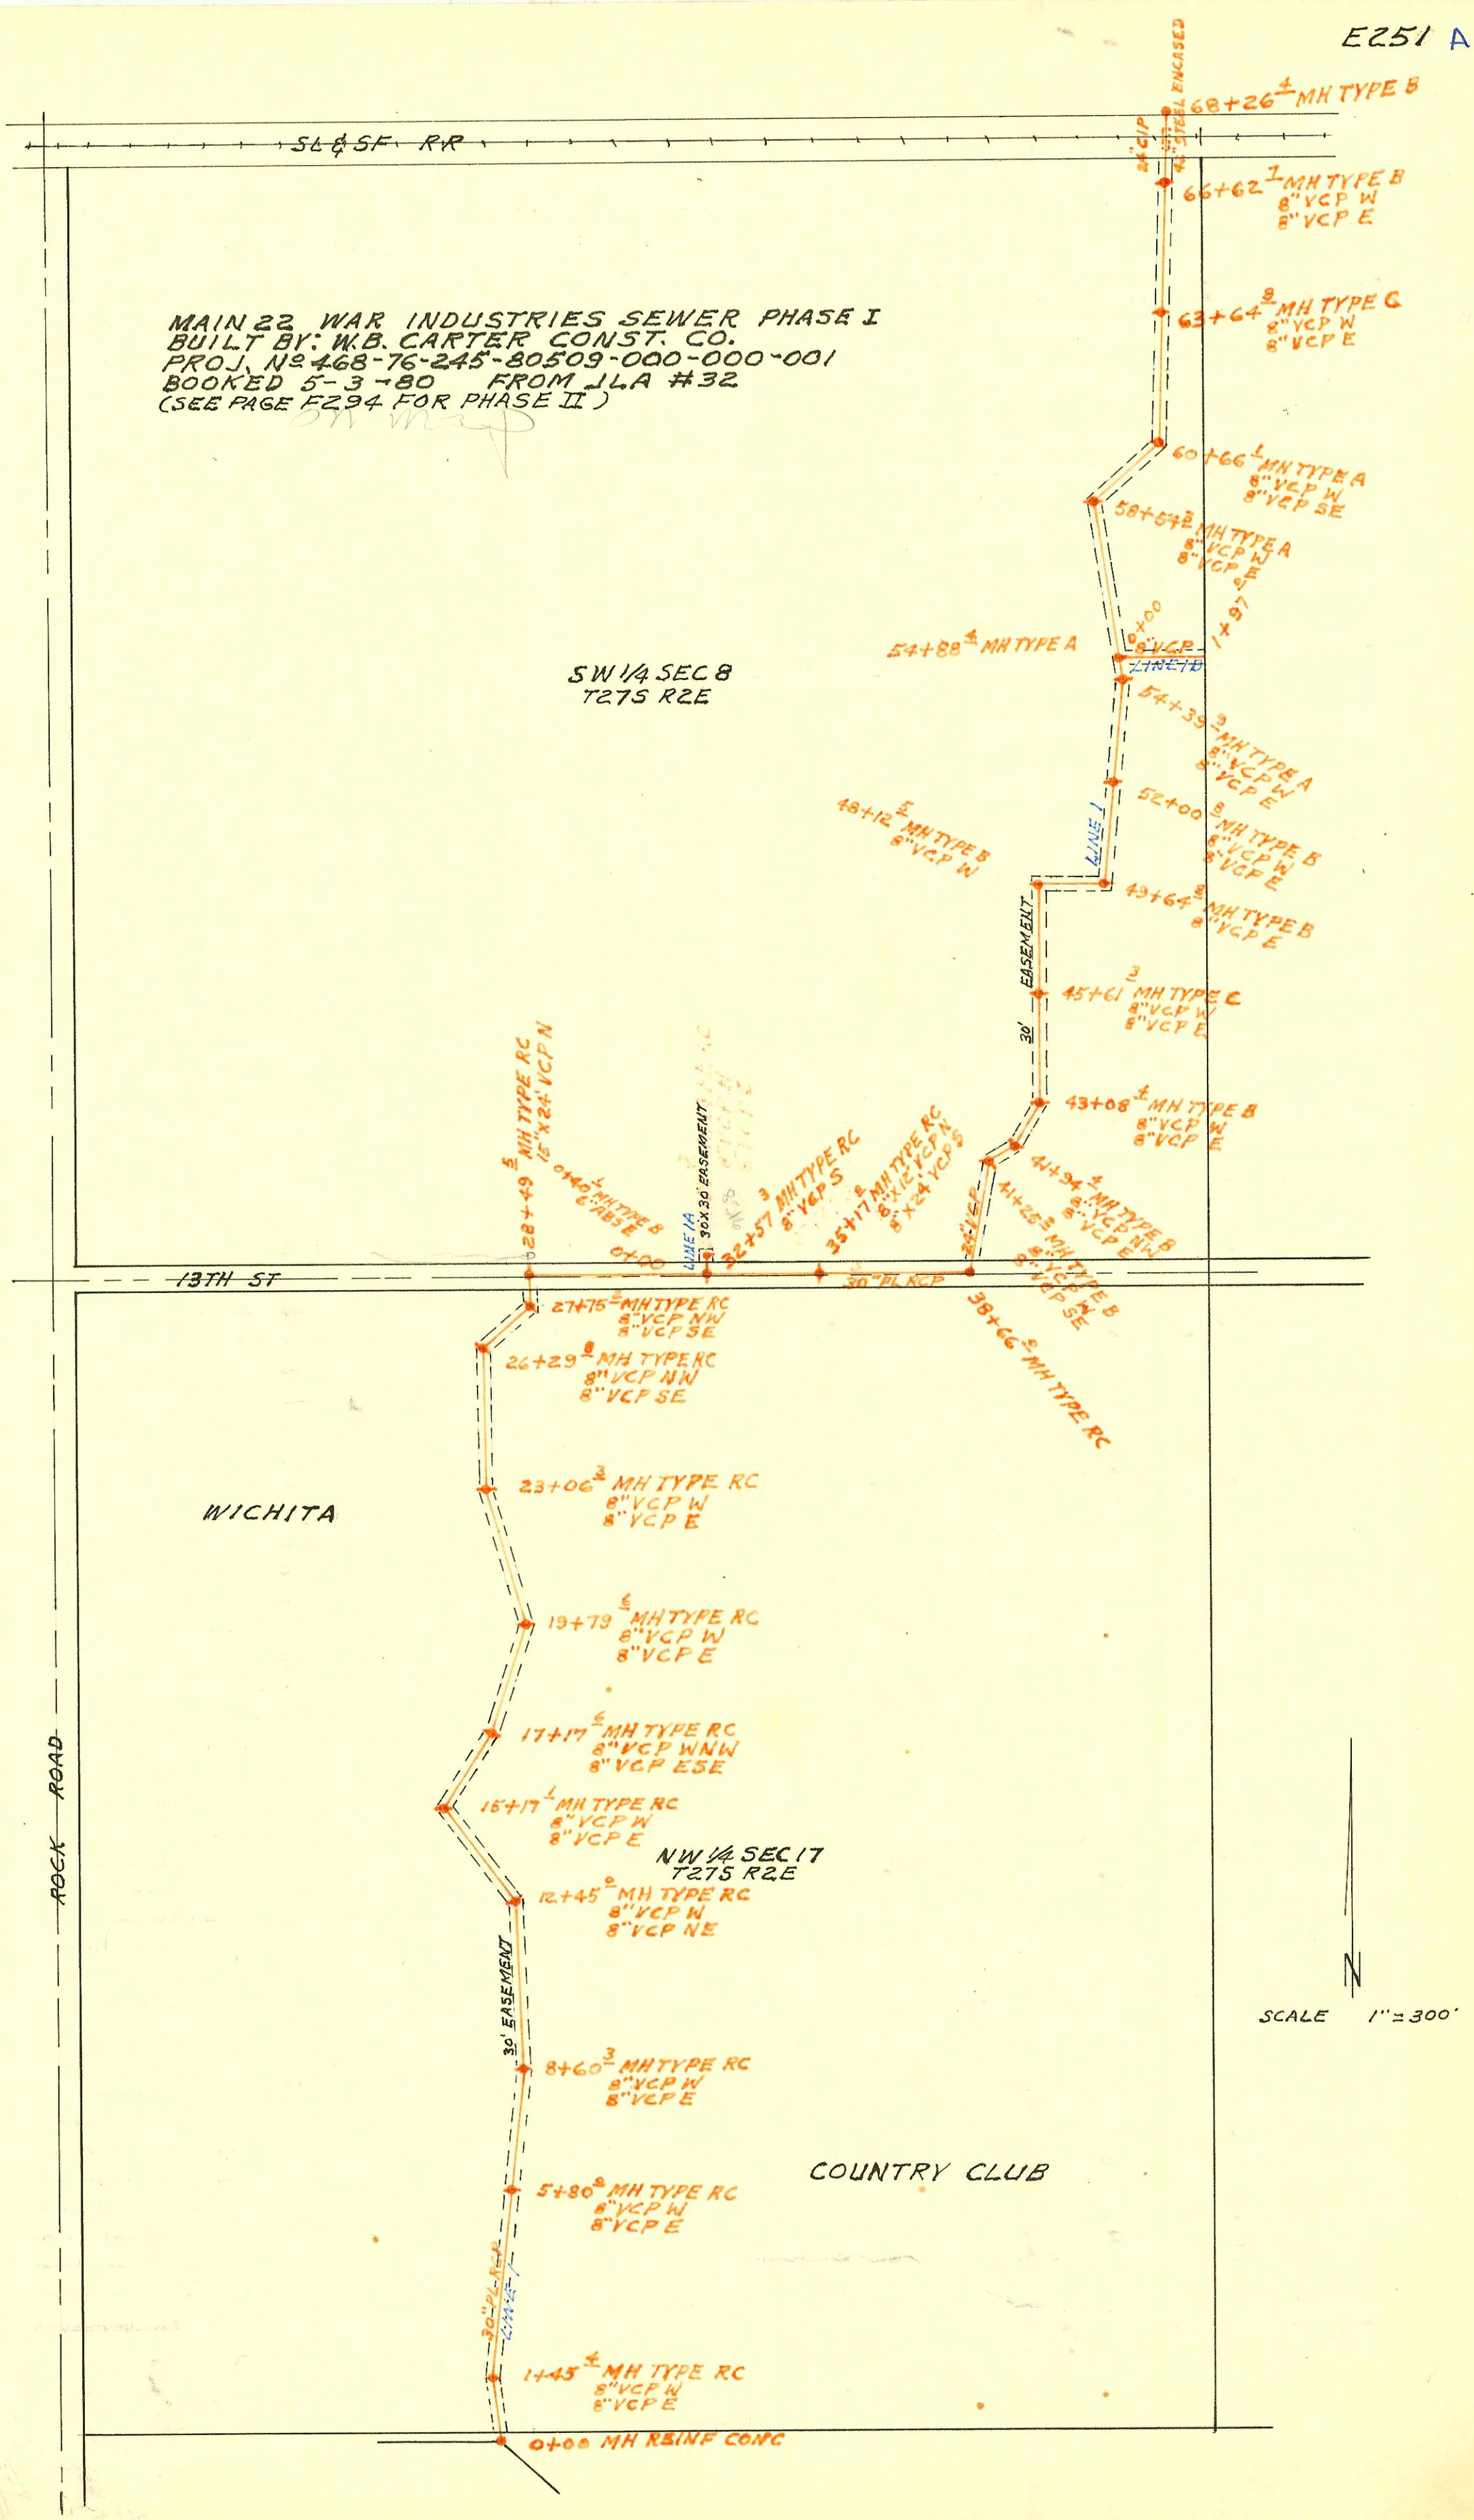
MAIN 22 WAR INDUSTRIES SEWER PHASE I
BUILT BY: W.B. CARTER CONST. CO.
PROJ. Nº 468-76-245-80509-000-000-001
BOOKED 5-3-80 FROM JLA #32
(SEE PAGE F294 FOR PHASE II)
SL&SF RR
SW 1/4 SEC 8
T27S R2E
68+26 MH TYPE B
24" CIP
40' STEEL ENCASED
66+62 MH TYPE B
8" VCP W
8" VCP E
63+64 MH TYPE C
8" VCP W
8" VCP E
60+66 MH TYPE A
8" VCP W
8" VCP SE
58+54 MH TYPE A
8" VCP W
8" VCP E
54+88 MH TYPE A
8" VCP
LINE 1B
54+39 MH TYPE A
8" VCP W
8" VCP E
52+00 MH TYPE B
8" VCP W
8" VCP E
48+12 MH TYPE B
8" VCP W
LINE 1
49+64 MH TYPE B
8" VCP E
EASEMENT
45+61 MH TYPE C
8" VCP W
8" VCP E
30'
43+08 MH TYPE B
8" VCP W
8" VCP E
41+94 MH TYPE B
8" VCP NW
8" VCP E
41+25 MH TYPE B
8" VCP W
8" VCP SE
38+66 MH TYPE RC
35+17 MH TYPE RC
8" X 12" VCP N
8" X 24" VCP S
32+57 MH TYPE RC
8" VCP S
30" X 30' EASEMENT
LINE 1A
28+49 MH TYPE RC
15" X 24' VCP N
0+40 MH TYPE B
8" ABS E
0+00
13TH ST
30" PL RCP
27+75 MH TYPE RC
8" VCP NW
8" VCP SE
26+29 MH TYPE RC
8" VCP NW
8" VCP SE
23+06 MH TYPE RC
8" VCP W
8" VCP E
WICHITA
19+79 MH TYPE RC
8" VCP W
8" VCP E
17+17 MH TYPE RC
8" VCP WNW
8" VCP ESE
15+17 MH TYPE RC
8" VCP W
8" VCP E
NW 1/4 SEC 17
T27S R2E
12+45 MH TYPE RC
8" VCP W
8" VCP NE
ROCK ROAD
30' EASEMENT
8+60 MH TYPE RC
8" VCP W
8" VCP E
COUNTRY CLUB
5+80 MH TYPE RC
8" VCP W
8" VCP E
30" PL RCP
LINE 1
1+45 MH TYPE RC
8" VCP W
8" VCP E
0+00 MH REINF CONC
N
SCALE 1" = 300'

E253

Form 42-020

	CONSTRUCTION RECORD							SERVICE RECORD					
	STATION	ELEVATION Ground	ELEVATION Grade	Depth	MANHOLE	4-INCH "Y" BRANCHES North West	4-INCH "Y" BRANCHES South East	No. of Permit North West	No. of Permit South East	House Number North West	House Number South East	DATE OF PERMITS North West	DATE OF PERMITS South East
MAIN 22 WIS (CONT'D)													
LINE 1 CONT'D	60+00	172.4	161.48	10.9									
		174.3	OUT 161.60 IN 161.70	12.7 12.6	60+66.1	8" STUB W	8" STUB SE						
	61+00	175.4	161.76	13.6									
	62+00	176.4	161.92	14.5									
	63+00	177.0	162.09	14.9									
		177.3	162.20	15.1	63+64.8	8" STUB W	8" STUB E						
	64+00	177.6	162.26	15.3									
	65+00	179.3	162.43	16.9									
	66+00	180.6	162.60	18.0									
		180.8	162.71	18.1	66+62.7	8" STUB W	8" STUB E						
	67+00	181.0	162.77	18.2									
	68+00	178.3	162.94	15.4									
		179.7	162.99	16.7	68+26.4								
LINE 1A	0+00	172.91	157.91	15.0	0+00 = 32+57.3 LINE 1								
		172.0	158.07	13.9	0+40.1		6" Stub E ok		32		8516 E 13th N		4-9-80
LINE 1B	0+00	174.3	161.83	12.5	0+00 = 54+88.4 LINE 1								
	1+00	175.0	162.23	12.8									
	1+97.0	176.8	162.62	14.2									
TOWNEWEST SQUARE SAN SEWER													
LINE A	0+00		104.34	11.6	0+00 EXISTING								
	1+00		104.68										
	2+00		105.02										
	3+00		105.37										
		114.3	105.37	8.9	3+01.2								
	4+00		105.71				TAP 120' ✓ W. of MH		92-15138 92-7743	*	4600 W (SEARS) Kellogg		7-24-92 5-27-92
	5+00		106.05				5+04.4 tap		C71149		4600 W Kellogg		4-9-79
	6+00		106.39				TAP 18' ✓ E of MH		92-15139-7 92-7742-7	*	4600 W. (SEARS) Kellogg (OIL Separator)		7-24-92 5-27-92
		115.4	106.63	8.8	6+69.4								
	7+00		106.74										
	8+00		107.15				TAP 165' ✓ NE of MH		92-15140-7 92-7741-7	*	4600 W (SEARS) Kellogg West Conn		7-24-92 5-27-92
	9+00		107.55										
		114.4	107.76	6.6	9+50.6								
	10+00		107.96										
							10+98.4 tap		C71148		4600 W Kellogg		4-9-79
	11+00		108.37										
		116.1	108.76	7.3	11+98.4		11+73.4 tap		C71146		4600 W Kellogg		4-9-79
	12+00		108.77										
	13+00		109.16						~~2002~~ 52480		4600 W Kellogg 5-0 SQ W Merchandise see next pg		9-5-02
							13+68.7 tap		C71145				4-9-79
	14+00		109.56										
		115.4	109.75	5.7	14+48.7		6" stub E ok		C71144		4600 W Kellogg		4-9-79
	15+00		109.91				15+87.1		C71143		4600 W Kellogg		4-29-79

CONT'D NEXT PAGE

* SEARS-Towne West - 2nd Permits pulled by plumber making final connections.

C71155 - 4600 W Kellogg - 4-9-79 - Jack Stump (Insp. Bay Eng)
C71154 " " " " " " (" " ")