F 62 A

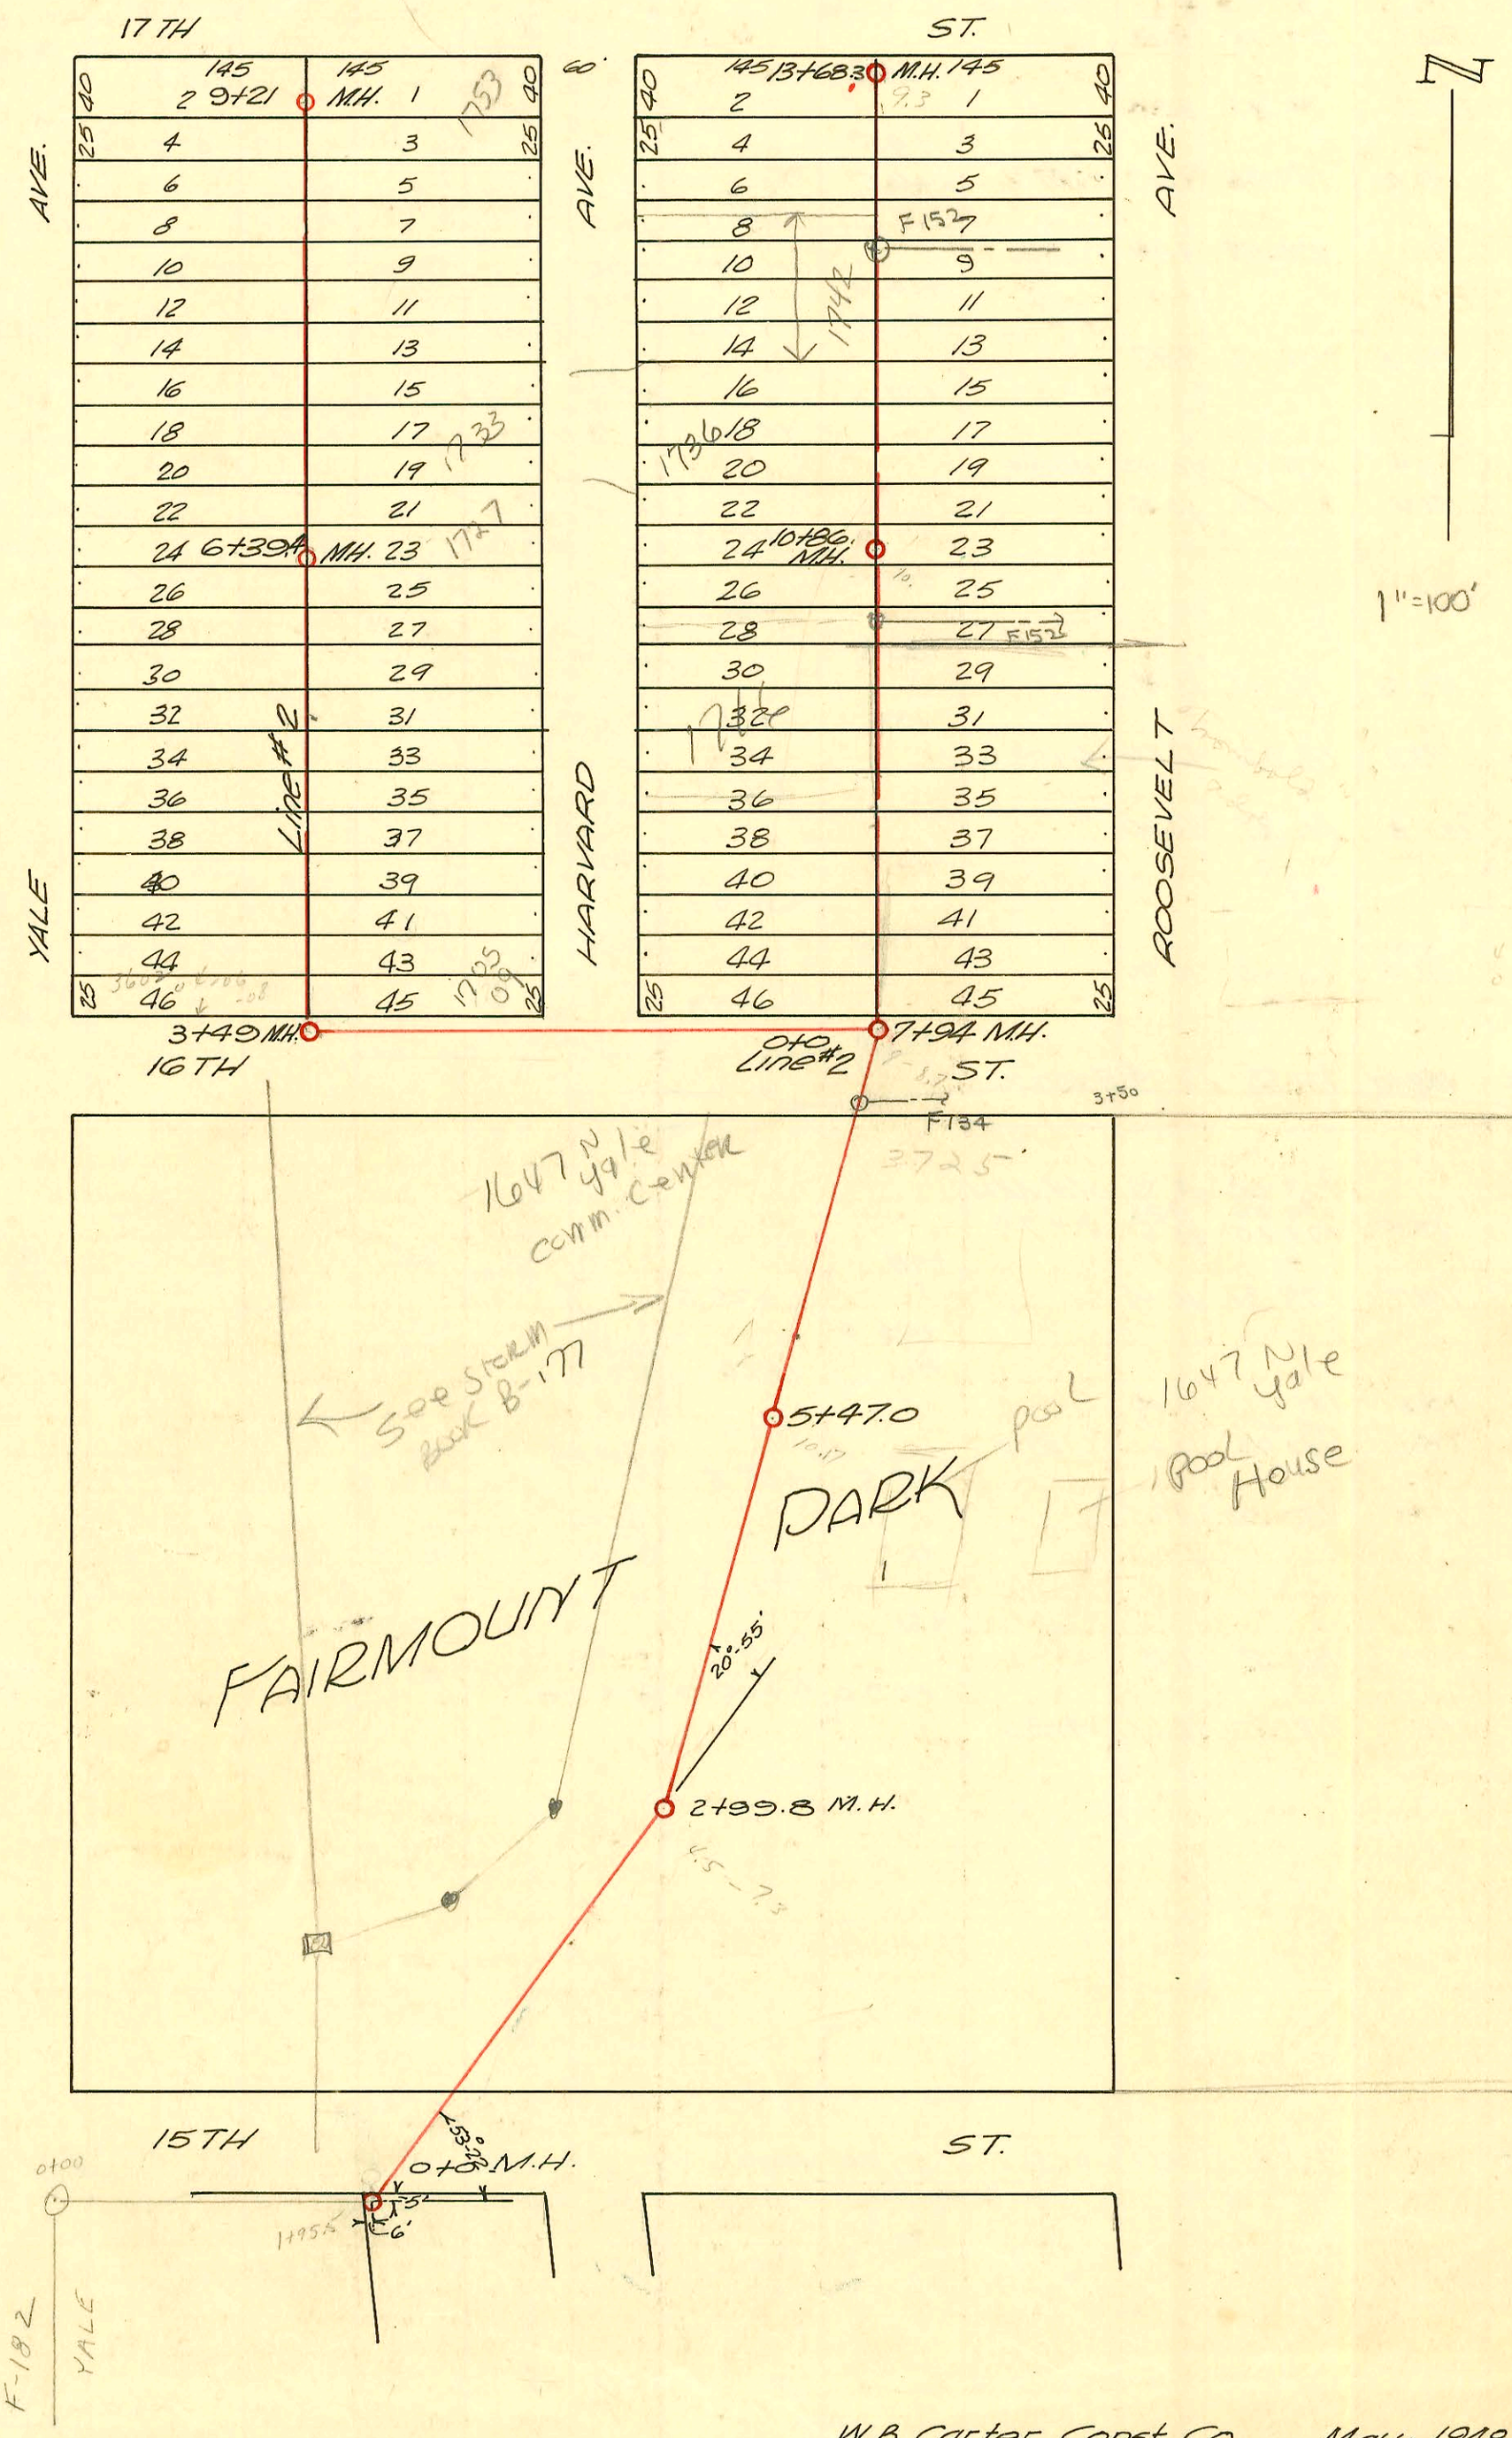

W.B. Carter Const. Co. May-1948
Lateral 2, District E, Main 12

#2586 - Jap - 1733-35-37-39 Roosevelt Court. 11-28-49.
S.O. C13359 - 3720 E. 17th - 8-1-79 (13+08.3)

Sub 2003 - 01582 - 6/17/03 - 1705 N Harvard - Clear water Exc - City wye repair 4" Predko, 1V45, 1H22
2 dir co 40' N of MH 3+49 (3+89)

The Wichita Eagle Press—76405

	CONSTRUCTION RECORD						SERVICE RECORD					
	STATION	ELEVATION		Depth	MANHOLE	4-INCH "Y" BRANCHES		No. of Permit		House Number		DATE OF PERMITS	
		Ground	Grade			~~North~~ West	~~South~~ East	North West	South East	North West	South East	North West	South East
Line I	0+0		176.70	0.56	8+78 Line #I Yale Heights Addn								
	1+0	183.8	176.80	6.10									
	2+0	182.9	176.90	4.51			2+29.8		2474		3725 E 16th N (?) 1510		1-23-81
	2+99.8	183.9	177.20 177.00		2+99.8				2002 02785		1647 Yale House Park		10-1-02
	4+0	185.3	177.30	7.30									
	5+0	187.1	177.40	10.01									
	5+47	187.2	177.45	10.17	5+47								
	6+0	189.1	177.50	11.33		5+27.4		2002 00541		1647 Yale	comm ctr	2/27/02	
	7+0	189.3	177.60	12.15									
	7+94	186.6	178.50 177.69	7.90 8.75	7+94								
	8+0												
						8+16	+13						
						+40	+37						
						+64.4	+61.4	#1562		1700 Harvard		11-18-48	
						+88.5	+85.5						
	9+0	192.5	183.04	10.27		TR 9+28		C24767		1710 Harvard		6-7-71	
						+18.4	+15.4						
						+40.0	+37.0						
						+64.4	+61.2						
						9+89.1	+85.1	#7328		1716 Harvard		12-15-53	
	10+0	197.5	187.32	11.18									
						10+12.5	+09.5						
						+36.6	+33.6						
						+64.6	+61.6	#343		1728 Harvard		6-30-48	
	10+86.~~6~~	200.4	191.50 191.00	9.50 10.00	10+86.~~6~~								
						+96.2	+93.2						
	11+0	200.5	191.62	9.54									
						+20.3	+17.3	2002-03007		1736R Harvard		1-6-02	
						4"40 PVC-CO only +44.4	+41.4	#344				6-30-48	
						+72.0	+69.0						
						+95.6	+92.6						
	12+0	201.8	192.48	9.81									
						12+22.6	+19.6	#2085		1742 Steward		10-18-49	
						+46.5	+43.5		#2585		1741-43-45-47 Roosevelt Ct		11-28-49
						+73.5	+70.5	#5112		1754 Harvard		6-28-51	
						12+97.5	+94.5		#2584		1749-51-53-55 Roosevelt Ct		11-28-49
	13+0	202.8	193.34	9.88									
						+22.3	+19.3						
						+46.0	+43.0						
						+64.5	+61.5						
	13+68.3	203.0	193.93	9.35	13+68.3								
Line II	0+0	186.6	177.70	8.76	0+0 M.H. at Sta. 7+94 on LINE #I								
	1+0	189.1	179.07	10.43									
	2+0	193.5	180.44	13.44									
	3+0	192.8	181.81	11.03									
	3+49	191.6	182.49 182.60	9.46 9.36	3+49								
						+69	+66	#2069	2003-01582	3602-4-6-8 E. 16th		3-2-49	6-17-03
						+92.5	4"40 +89.5	#2068	#1152	1706-8-10 N. Yale	1705-09R Harvard See next	3-2-49	10-8-48
	4+0	191.8	183.06	9.04									
						+17	4 +14						
						+41	+38						
						+67.3	+64.3	#2067		1712-14 N. Yale		3-2-49	
						+92.0	+89.0						
	5+0	192.0	183.78	8.51									
						5+19.1	16.1						
						5+43.7	5+40.7 ok	#2066	98-813-7	~~1716-18-20~~ N. Yale	1723 R Harvard	3-2-49	1-21-97 4-25-57
						5+67.5	+64.5	#2065		1722-24-26 N. Yale		3-2-49	
						5+95.0	+92.0						
	6+0	193.1	184.50	8.91									
						6+19.2	+16.2	#2064	#1938	1728-30 N. Yale	1727 Harvard	3-2-49	2-14-49
	6+39.4	193.6	184.80 185.00	9.17 8.97	6+39.4	+48.6	+45.6						
						4"SCH 40 +70.6	+67.6		2004-02930 1999-00206	1732-34-36 N. Yale	A.R. BURST 1733 R Harvard		12-9-04 7-16-99
						+94.5	4"SCH40-CO +91.5	#2063	#1184			3-2-49	6-1-50
	7+0	193.7	185.62	8.29									
						+18.6	+15.6						
						+42.7	+39.7	#2062	#1185	1738-40-42 N. Yale	1739 Harvard	3-2-49	6-1-50
						+64.4	+61.4						
						+91.7	+88.7	#2061		1744-46 N. Yale		3-2-49	
	8+0	195.9	186.65	9.80									
						+15.8	+12.8		#1041		1747 Harvard		7-30-49
						+40.1	+37.1						
						+67.0	+64.0	#2060		1748-50-52 N. Yale		3-2-49	
						+92.2	+89.2	#2059		3601-3-5-7 E. 17th		3-2-49	
	9+0	197.5	187.68	10.17			4"40-CO		2004-00300				2/10/04
						+16.0	+13.0		#77		1753 R Harvard		5-26-48
	9+21	197.7	187.90	10.27	9+21								