86 A

W. 5.5' of W. 50 of S 8' easem't Vacated Ord. No. 21-586

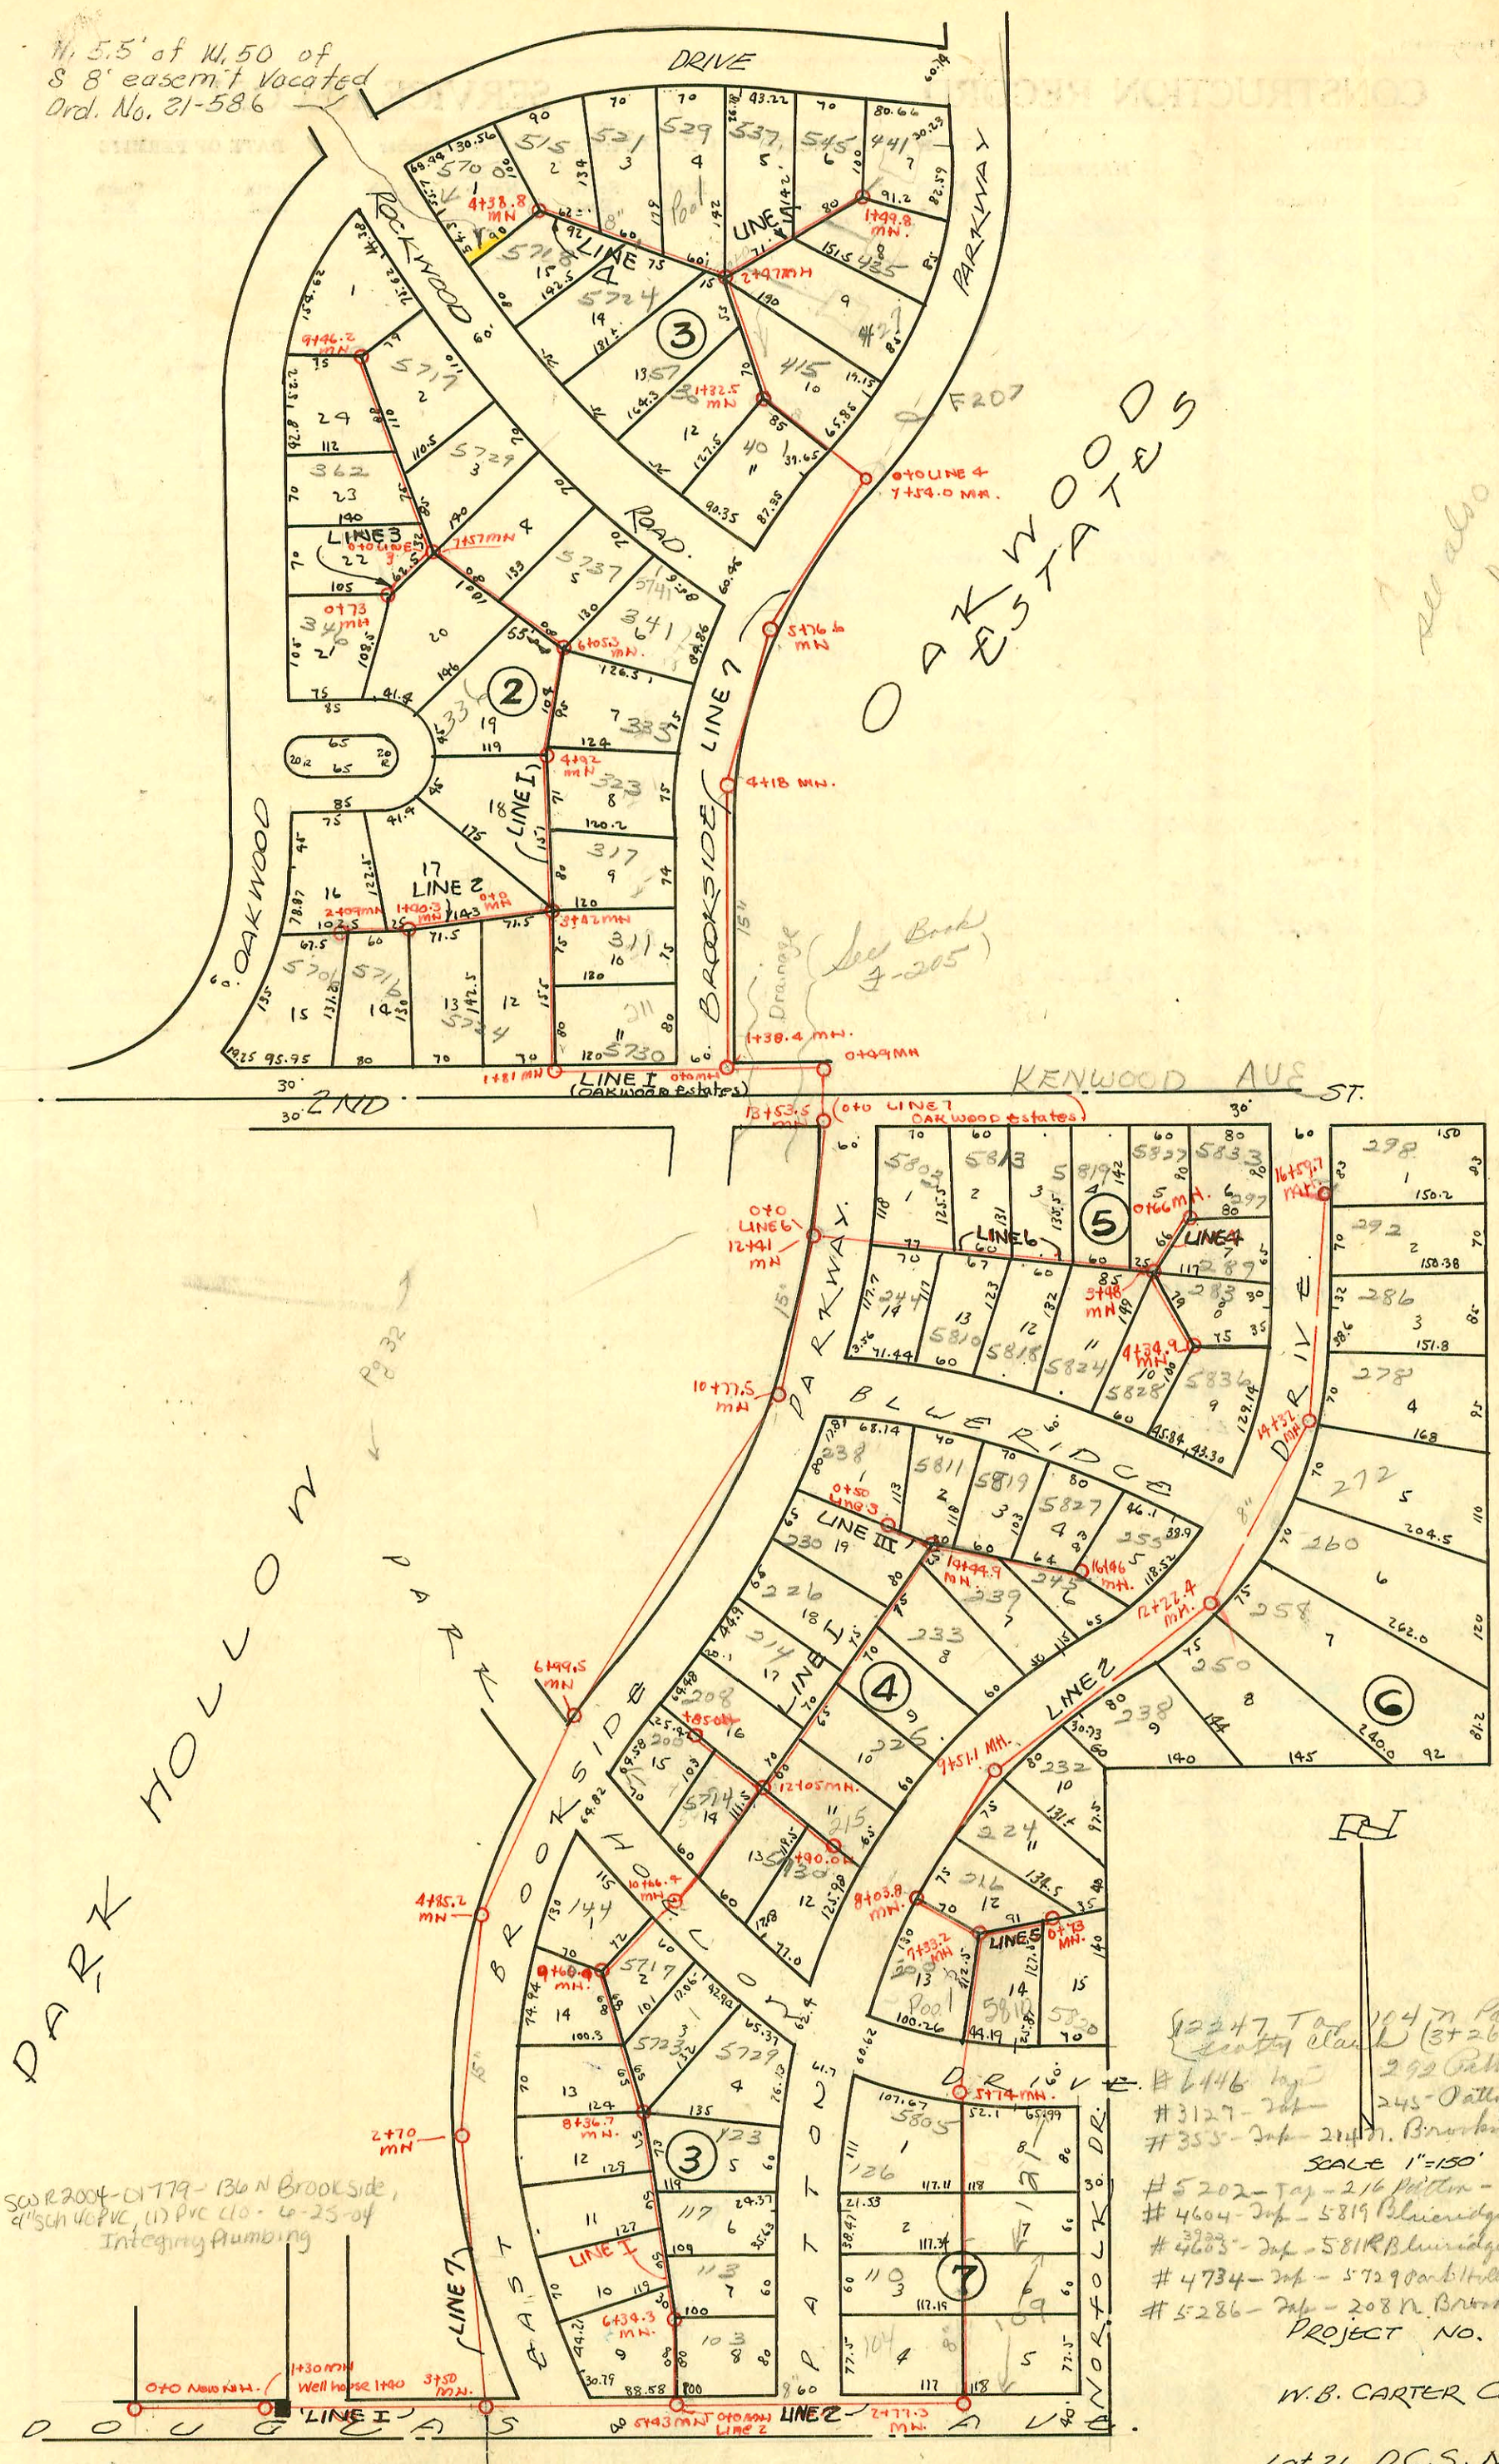

See also page 32

SCO R2004-01779 - 136 N Brookside, 4" Sch 40 PVC, (1) PVC CLO - 6-25-04 Integrity Plumbing

* On Line I - #5[illegible] tap charge to be made when there is no wye on the building site.

#1545 - Tap - 200 N. Brookside - 7-6-50 - Vaughn Plbg. Co
#1611 - Inp - 250 N. Patton - 7-13-50 - C. G. Coleman
#1612 - Inp - 222 N. Brookside - 7-14-50 Vaughn Plbg. Co.
#1843 - Inp - 260 Patton - 8-3-50 - Rupp Plbg. Co.
#1886 - Inp - 272 Patton - 8-8-50 - C. G. Kruse (13+47)
#1875 - Inp - 401 N. Brookside - 8-7-50 - Eugene Reynolds
#2619 Inp - 235 Patton - 10-9-50 - Rupp Plbg. Co

#2247 Tap - 104 N Patton 2-2-60 - Gary Clark (3+26.3)
292 Patton 9-15-53 - Bryant
#6446 Tap
#3127 - Inp - 245 Patton - 11-6-52 - D. A. Lowell
#355 - Inp - 214 N. Brookside - 3-14-52 - Vaughn Plbg. Co (13+30.17)
#5202 - Tap - 216 Patton - 7-10-51 - Thompson
#4604 - Inp - 5819 Blueridge - 5-9-51 - Millard Stipp
#4603 - Inp - 5818 Blueridge - 5-9-51 - Millard Stipp
#4734 - Inp - 5729 Park Hollow - 5-25-51 - Howard Lay
#5286 - Inp - 208 N. Brookside - 7-19-51 - Vaughn Plbg. Co

#3589 - Inp - 103 Patton - 1-5-51 - Kendall Plbg. Co.
#3590 - Inp - 103 Patton - 1-5-51 - Kendall Plbg. Co.
#3276 - Inp - 5730 Park Hollow - 12-4-50 - Rupp Plbg.
#788 - Inp - 5724 E 2nd - 4-28-50 - Liberman
#2406 - Tap - 289 Patton Hwy - 9-19-50 - Kendall Plbg.
#2437 Tap - 136 Brookside - 9-22-50 - Vaughn Plbg.
#2410 - Inp - 225 Patton - 9-19-50 - Rupp Plbg. Co.
#2912 - Tap - 278 Patton - 10-31-50 - Carlson
#3204 - Cap - 113 Patton - 11-27-50 - Kendall Plbg.
#3114 - Inp - 311 N. Brookside - 11-13-50 - Federal Plbg. Co.
#3115 - Inp - 5730 E. 2nd - 11-13-50
#4162 - Cap - 088 Park Hollow - 3-22-51 - Lowe Heat

The Wichita Eagle Press—76405

	CONSTRUCTION RECORD							SERVICE RECORD					
	STATION	ELEVATION		Depth	MANHOLE	4-INCH "Y" BRANCHES		No. of Permit		House Number		DATE OF PERMITS	
		Ground	Grade			~~North~~ West	~~South~~ East	North West	South East	North West	South East	North West	South East
LINE IV Park Hollow	0+0	174.9	160.43	14.30	(3+48 Line 6) 0+0	+20.2	+17.2	#4242	#2778 1543	5827 E. 2nd		3-31-51	10-26-88 7-12-50
	0+66.3	175.1	160.55	15.12	0+66.3	Stub in	Manhole				297 Patton Dr.		
LINE V	0+0	175.3	164.92	9.62	(7+33.2 Line 2) 0+0		South +15.6		#3494		5812 Park Hollow		3-1-50
	0+73	177.2	166.0	11.67	0+73								
LINE VI	0+0	170.3	158.53	11.51	(12+40 Line 7) 0+0	North +81.7	South. +78.7	#3214		5803 E. 2nd		11-28-50	
	1+0	171.3	159.00	12.90		+58.8	1+55.8		~~#5985~~ #5335		5810 Blueridge		~~9-24-51~~ 6-27-51
	2+0	172.9	159.50	13.86		+16.0	2+13.0	#1171 5728		5813 E. 2nd		4-26-82	
						+78.8	+75.8	#1276 2233		5819 E. 2nd	R	5-29-50 9-28-90 6-7-50	
	3+0	174.1	160.00	14.46									
	3+48	174.9	160.22	14.69	3+48.0	West +67.3	East. +64.3		#2203		289 Patton		9-5-50
	4+0	176.0	160.52	15.82					Stub in MH.				
	4+34.9	176.6	160.59	16.45	4+34.9				#2114		5836 Blue Ridge		8-28-50
LINE VII	0+0	163.2	155.22	8.62	(3+50 LINE I 0+0)		4" SCH40 CITY 0+84 Predco		2001-00232		244 N. N/C Brookside		2-1-01
	1+0	165.6	155.45	10.91									
	2+0	166.1	155.70	11.06									
	2+70	165.8	155.88	10.35	2+70								
	3+0	165.6	155.95	10.20									
	4+0	165.5	156.20	9.52									
	4+85.2	166.6	156.41	10.12	4+85.2								
	5+00	166.3	156.45	10.87									
	6+0	167.1	156.70	10.78									
	6+99.5	167.0	156.95	11.14	6+99.5								
	7+0												
	8+0	166.2	157.20	9.71									
	9+0	166.4	157.45	9.80									
	10+0	167.8	157.70	10.56									
	10+77.5	168.6	157.89	11.37	10+77.5								
	11+0	168.8	157.95	11.29									
	12+0	168.6	158.20	11.68									
	12+41.0	168.8	158.30	11.52	12+41.0								
	13+0	168.7	158.45	11.22									
	13+53.5	168.5	158.58	10.45	13+53.5								
LINE 7 OAKWOOD ESTATES			158.76	10.26	STA 13+53.5								
	0+0	168.5 ~~169.0~~	158.58 ~~158.02~~	10.45	0+0 LINE 7 (Park Hollow)								
	0+49	168.5	158.89	9.85	0+49								
	1+0	170.2	159.21	10.49									
	1+38.4	170.2	159.31	11.10	1+38.4								
	2+0	171.3	159.66	12.73									
	3+0	173.2	159.91	13.79									
	4+0	170.5	160.16	11.68									
	4+18	170.9	160.21	11.79	4+18								
	5+0	171.4	160.60	11.23									
	5+76.6	171.0	160.80	10.45	5+76.6								
	6+0	171.7	161.05	10.38									
	7+0	169.0	161.30	9.59									
	7+54.8	172.3	161.45	10.81	7+54.8								
LINE I OAKWOOD Estates.	0+0	170.2	159.51	10.87	Sta. 1140 0+0 (LINE 7)								
	1+0	171.5	160.31	11.55									
	1+81	172.9	160.96	12.07	1+81	East	West	East	West	East	West	East	West
	2+0	172.8	161.31	12.73									
						+12.2							
						+93.1							
	3+0	174.3	162.11	12.55									
	3+42	174.6	162.45	12.71	3+42								
						3+61.6		#4412		317 Brookside		4-19-51	
	4+0	175.0	163.11	13.16			4+07		#1201		332 Oakwood		10-14-48
						+42.5		#3225		325 N. Brookside		11-28-50	
	4+92	177.9	163.85	13.80	4+92								
	5+0	176.9	164.11	13.78		5+19	5+16	#3226	#1199	333 N. Brookside	336 Oakwood	11-28-50	10-14-48
	6+0												
	6+05.3	175.2	164.96	11.27	6+05.3				Stub in MH #3773		341 N. Brookside		1-25-51
							+30.9						
						+90.5	+93.5		#1200		340 Oakwood		10-14-48
	7+0	176.3	165.91	10.29									
	7+57	177.2	166.35	10.83	7+57								
						+82							
	8+0	178.5	166.91	11.64									
							+16.0		#1193		362 Oakwood		10-14-48
						+64.0	+88.9	#1015	#1192	5717 Rockwood	404 Oakwood	7-26-49	10-14-48
	9+0	178.2	167.71	10.50									
	9+46.2	178.8	168.09	10.55	9+46.2	Stub in	M.H.		#1202		410 Oakwood		10-14-48

2001-00277 - 2/1/01 - 244 N Brook S/O side Pkwy - Padgett EXC- S/O with concrete 82' E of MH 0+00 (0+82)
~~see previous page for reconnect info.~~

SEE PAGE 86 FOR PLAN.