


SERVICE RECORD

CONSTRUCTION RECORD

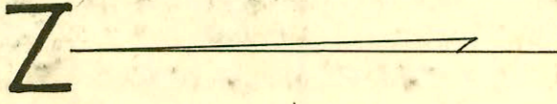

See F52

See Page #102 for 35' sewer

811. 100.56 SE Corner Conc. Patch Ho. #2309 PATTIE.

L. AT. L., DIST. B, MAIN 20
W. B. CARTER CONST. CO.
PAOS. No. C28-38.
Date 3-18-49

ELLIS AVE.

133.72	46	52.16
	47	
	48	
	49	
	50	
	51	
52.16	52	51.47
51.57	53	

LULL AVE. 60

52.16	30	132	34.794	MM. 38	38	52.16
	31	132	39.00			
	32		40.23			
	33		41.23			
	34		42.23			
	35		43.23			
52.16	36		44.23			52.16
51.7	37		45.23			51.57

LINE III

PATTIE AVE. 09

52.16	14	133	34.794	MM. 22	22	52.16
	15		23			
	16		24			
	17		25			
	18		26			
	19		27			
52.16	20		28			52.16
51.94	21		29			51.75

LINE II

LAURA AVE.

133	133	34.794	MM. 6	6	52.16
	7				
	8				
52.68	9				52.68
52.16	10				52.16
	11				
52.16	12				52.16
50.94	13				50.94

LINE I

Handed

F-35

F45

F45

Blake

F45

CONSTRUCTION RECORD

SERVICE RECORD

STATION	ELEVATION		Depth	MANHOLE	4-INCH "Y" BRANCHES		No. of Permit		House Number		DATE OF PERMITS	
	Ground	Grade			North West	South East	North West	South East	North West	South East	North West	South East
LINE I	0+0	100.0	89.14	11.03	(Existing) 0+0 MH.	0+55.3		#2309	2256 Laura			3-21-49
	1+0	99.6	89.24	10.75		1+18.6 +70.2	1+15.6 +67.2	#2135 #2142 #2136 #2143 #2137	2248 Laura 2242 Laura	2251 Pattie 2247 Pattie 2241 Pattie		3-10-49 3-10-49 3-10-49
	2+0	99.9	89.34	11.20		2+21.6 +58.4	2+18.6 +76.4	#2144 #2138 #2139	2238 Laura 2231 Pattie	2237 Pattie		3-10-49 3-10-49
	3+0	100.8	89.44	11.99		2+79.0 3+34.6 +70.9	+76.0 3+25.4 +67.9	#2141 #2338 #2140 #6391 #2141	2234 Laura 2229 Laura 2221 Pattie	2231 Pattie 2227 Pattie		1-30-52 3-10-49 3-10-49
	3+82.5	100.8	89.53	11.69	3+82.5					2231 Pattie		3-10-49
LINE II	0+0	100.4	89.05	11.50	Existing 0+0 MH.	4" PESDR17 0+14.1 +67.7	0+11.1 +64.7	#504 #1177 #503 #1178	2254 Pattie 2250 Pattie	2257 Lulu 2251 Lulu		2-28-53 6-11-49 8-13-49
	1+0	99.5	89.15	10.97		1+16.6 +71.5	1+13.6 +68.5	#502 #1179 #501 #1471	2248 Lulu 2242 Lulu	2247 Lulu 2241 Lulu		6-14-49 8-13-49
	2+0	100.3	89.25	11.41		2+23.0 +77.8	2+20.0 +74.8	#500 #1472 #499 #1473	2237 Lulu 2232 Lulu	2231 Lulu 2227 Lulu		6-14-49 8-31-49 8-31-49

2002-02421 91302 2258 S Pattie - Roto Rooter - 4" PESDR17 Pipeburst repl - CITY WYE REPAIR - 4" PREDKO (on msmt)
1422, 1701 W CO, bsmt - 4" 40 PVC

2275 - top - 2257 Pattie - 10-31-49 - Fredrick Pelly Co.
7229 - top - 2232 Laura - 1-25-52 - Joe Mc Donald
1163 - top - 2258 S Laura - 8-25-55 - Lee Keston
B2992 - top - 2266 Lulu - 3-16-65 - R. M. Turley (0+59.7)