

SERVICE RECORD

CONSTRUCTION RECORD

Kensington Ave.

24	116.85	125	22165.2 MH
23	113.4	2	
22	112.2	3	
21	111.9	4	
20	111.2	5	
19	111.5	6	
18	112	7	
17	112.9	8	
16	114	9	
15	115.7	10	
14	117.7	11	
13	120.45	12	
Vacated 16th			
44	125	125	19+38.2 MH
43		2	
42		3	
41		4	
40		5	
39		6	
38		7	
37		8	
36		9	
35		10	
34		11	
33		12	
32		13	
31		14	
30		15	
29		16	
28		17	
27		18	
26		19	
25		20	
24		21	
		22	
		23	

Crestview Dr.


50		125	12764.0 MH
49		1	
48		2	
47		3	
46		4	
45		5	
44		6	
43		7	
42		8	
41		9	
40		10	
39		11	
38		12	
37		13	
36		14	
35		15	
34		16	
33		17	
32		18	
31		19	
30		20	
29		21	
28		22	
27		23	
26		24	
25	125	125	6741.2 MH

14th St.

46	125	125	1
45	124.11	126.06	2
44	125.35	127.12	3
43	123.39	128.18	4
42	123.36	129.24	5
41	124.08	130.30	6
40	124.25	131.36	7
39	126.17	132.41	8
38	127.14	133.47	9
37	129.08	134.53	10
36	131.43	135.59	11
35	134.55	136.6	12
34	137.87	137.71	13
33	140.36	138.77	14
32	143.40	139.83	15
31	145.70	140.84	16
30	147.59	141.85	17
29	149.10	143.01	18
28	150.24	144.07	19
27	151.03	145.13	20
26	151.47	146.18	21
25	151.50	147.24	22
24	151.24	148.30	23

13th St.

11706.77H Line #6

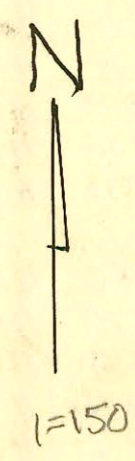

One crest
Homes
Hutton
old manor

7F-112

CONSTRUCTION RECORD

SERVICE RECORD

STATION	ELEVATION		Depth	MANHOLE	4-INCH "Y" BRANCHES		No. of Permit		House Number		DATE OF PERMITS	
	Ground	Grade			North West	South East	North West	South East	North West	South East	North West	South East
0+0		197.50	11.60	Sta 71+06.4 0+0 Line #6	0+15.3	0+04.5		23696	1404 N. Pinecrest	1401 N. Old Manor		8-7-59
1+0	208.7	197.70	10.61		+50.9	+47.9	#312	#1210 #869 #1211	1404 N. Pinecrest	1401 N. Old Manor	#4-50	6-6-50 6-6-50
2+0	209.7	197.90	12.35		+53.3	+50.3	#4778	#3365 #1212	1416 N. Pinecrest	1419 N. Old Manor	5-29-51	5-27-51 6-6-50
3+0	211.4	198.10	13.90		+54.7	+51.7	#3413	#1047	1427 N. Pinecrest	1427 N. Old Manor	13-19-50	1-25-51
3+25.2	211.5	198.15	14.02	3+25.2	3+53.4	3+50.4	#1271	#1174	1432 N. Pinecrest	1432 N. Old Manor	6-12-50	5-8-52
4+0	211.8	198.30	14.08		4+05.2	4+02.2	#7046	2825	1436 N. Pinecrest	1436 N. Old Manor	5-16-50	10-23-50
5+0	212.3	198.50	14.22		+54.9	+51.9	#1274	#2787	1442 N. Pinecrest	1441 N. Old Manor	6-12-50	10-18-50
6+0	212.7	198.70	14.41		5+04.3	5+01.3	#3840	2826	1446 N. Pinecrest	1447 N. Old Manor	2-12-51	10-23-50
6+41.0	212.8	198.58	14.48	6+41.0	6+60.4	6+57.4	#2183	2827	1452 N. Pinecrest	1453 N. Old Manor	11-6-50	10-28-50
7+0	213.1	199.40	14.67		5+53.3	+50.3	#1045	#4656	1462 N. Pinecrest	1462 N. Old Manor	5-16-50	3-27-52
8+0	213.5	199.60	14.31		7+06.0	7+03.0	#1142	#3196	1502 N. Pinecrest	1501 N. Old Manor	5-24-50	11-28-50
9+0	213.9	199.80	14.56		7+54.4	7+51.4	#3802	#1140	1506 N. Pinecrest	1507 N. Old Manor	5-5-51	5-24-50
9+75.9	213.6	199.98	14.01	9+75.9	9+05.5	8+02.5	#1143	#7353	1512 N. Pinecrest	1513 N. Old Manor	5-24-50	1-31-52
10+0	-	200.50	14.04		+56.3	+53.3	4878	#3102	1518 N. Pinecrest	1519 N. Old Manor	6-5-51	11-13-50
11+0	-	200.70	13.53		9+07.6	9+04.6	#4779	#1141	1527 N. Pinecrest	1527 N. Old Manor	5-29-51	5-24-50
12+0	-	200.90	13.38		9+57.7	9+04.6	#7414	#3110	1524 N. Pinecrest	1527 N. Old Manor	2-5-52	2-1-51
12+64.5	213.4	201.07	12.96	12+64.5	12+05.4	12+02.4	#7413	#1869	1530 N. Pinecrest	1533 N. Old Manor	2-5-52	8-5-50
13+0	213.4	200.10	12.65		+57.8	+53.8	#1894		1536 N. Pinecrest	1537 N. Old Manor	8-8-50	8-16-50
14+0	213.5	201.30	12.71		13+69.9	13+60.9	#1893	#1868	1542 N. Pinecrest	1541 N. Old Manor	8-8-50	8-16-50
15+0	214.2	200.50	12.63		+54.8	+51.8	#5618	#665	1542 N. Pinecrest	1541 N. Old Manor	8-19-51	8-16-50
16+0	214.2	201.70	12.82		11+06.6	11+03.6	#1175	#1133	1546 N. Pinecrest	1547 N. Old Manor	12-20-50	6-7-50
16+37.8	214.6	201.77	12.70	16+37.8	11+55.9	11+52.9	#568	#3801	1546 N. Pinecrest	1547 N. Old Manor	5-8-50	3-29-50
17+0	214.5	201.90	12.74		12+05.4	12+02.4	#1869	#2841	1558 N. Pinecrest	1559 N. Old Manor	8-1-50	10-24-50
18+0	214.6	202.10	12.33		+57.8	+53.8	#1894		1562 N. Pinecrest	1562 N. Old Manor	8-8-50	8-8-50
19+0	214.4	202.30	11.93		13+69.9	13+60.9	#1916		1702 N. Pinecrest	1701 N. Old Manor	8-10-50	2-10-51
19+38.2	214.2	202.37	11.91	19+38.2	+63.9	+60.9	#3836		1708 N. Pinecrest	1707 N. Old Manor	12-18-50	9-21-50
20+0	213.9	202.50	11.52		14+06.2	14+03.2	#3555		1712 N. Pinecrest	1712 N. Old Manor	10-4-50	9-21-50
21+0	214.4	202.70	11.84		15+07.9	15+04.9	2562	#2431	1718 N. Pinecrest	1717 N. Old Manor	6-10-50	11-11-50
22+0	205.0	202.90	12.21		+57.9	+54.9	#1258	#2429	1724 N. Pinecrest	1727 N. Old Manor	6-10-50	11-21-50
22+65.2	215.2	203.17	12.19	22+65.2	16+05.5	16+02.5	#1259	#3199	1730 N. Pinecrest	1731 N. Old Manor	6-10-50	2-18-50
					+59.8	+54.8	#1917		1738 N. Pinecrest	1738 N. Old Manor	6-10-50	8-10-50
					17+07.2	17+04.2	#1260		1744 N. Pinecrest	1744 N. Old Manor	6-10-50	8-8-50
					+55.7	+52.7	#1261		1755 N. Pinecrest	1755 N. Old Manor	6-10-50	8-8-50
					18+05.3	18+02.3	#1262		1758 N. Pinecrest	1758 N. Old Manor	6-10-50	9-26-50
					+57.3	+54.3	#1895		1762 N. Pinecrest	1763 N. Old Manor	9-26-50	9-26-50
					19+05.4	19+02.4	#2503		1776 N. Pinecrest	1777 N. Old Manor	8-14-50	8-14-50
					+57.3	+54.3	#2498	#3497	1780 N. Pinecrest	1781 N. Old Manor	8-14-50	8-14-50
					20+06.6	20+03.6	#2500	#2502	1784 N. Pinecrest	1784 N. Old Manor	8-14-50	8-14-50
					+58.9	+55.9	#1957	#1956	1788 N. Pinecrest	1789 N. Old Manor	8-14-50	12-29-53
					21+07.0	21+04.0	#1955	#1951				
					+55.8	+52.8	#1954					
					22+06.8	22+03.8	#1950	#7288				

2003-03388-12/30/03-1546 N Pinecrest-Reddy Rootr-1twin co, 1H22, 4"sch 40PVC, afernco, clo installed@house

2002-02157-8/16/02-1541 N Old Manor-79.4' N of MH 9+75.9 (10+51.8) 2TWIN CO, 2H45, WYE for and kickout, 4" SCH 40 PVC, 1V45, Predco Saddle

2002-01264-01264-1792 N. Pinecrest R - 8-14-50 - Padgett Exc - 6' S of MH 22+65.2 (22+57.2) Predco Saddle
 #1952-24-1792 N. Pinecrest R - 8-14-50 - Ray Bryant
 #1957-24-1401 N. Old Manor - 7-25-50 - Betty Clat Pkg. (see above)
 #1918-24-1739 N. Old Manor - 8-10-50 - Riggs Pkg. Co
 #1919-24-1747 N. Old Manor - 8-10-50 - Riggs Pkg. Co
 #1953-24-1791 N. Old Manor - 8-14-50 - Ray Bryant
 #69 1526 N Pinecrest R 4-14-80 R O Campbell 9+75.9 S. (6+41-261' N) (9.9+020)