


EXTENSION TO LAT. 30, D.C. SUB., S.S. #12
MID STATES CONSTRUCTION CO. 7-16-66
PRIVATE PROJ. BOOKED 9-22-67 (Plan)

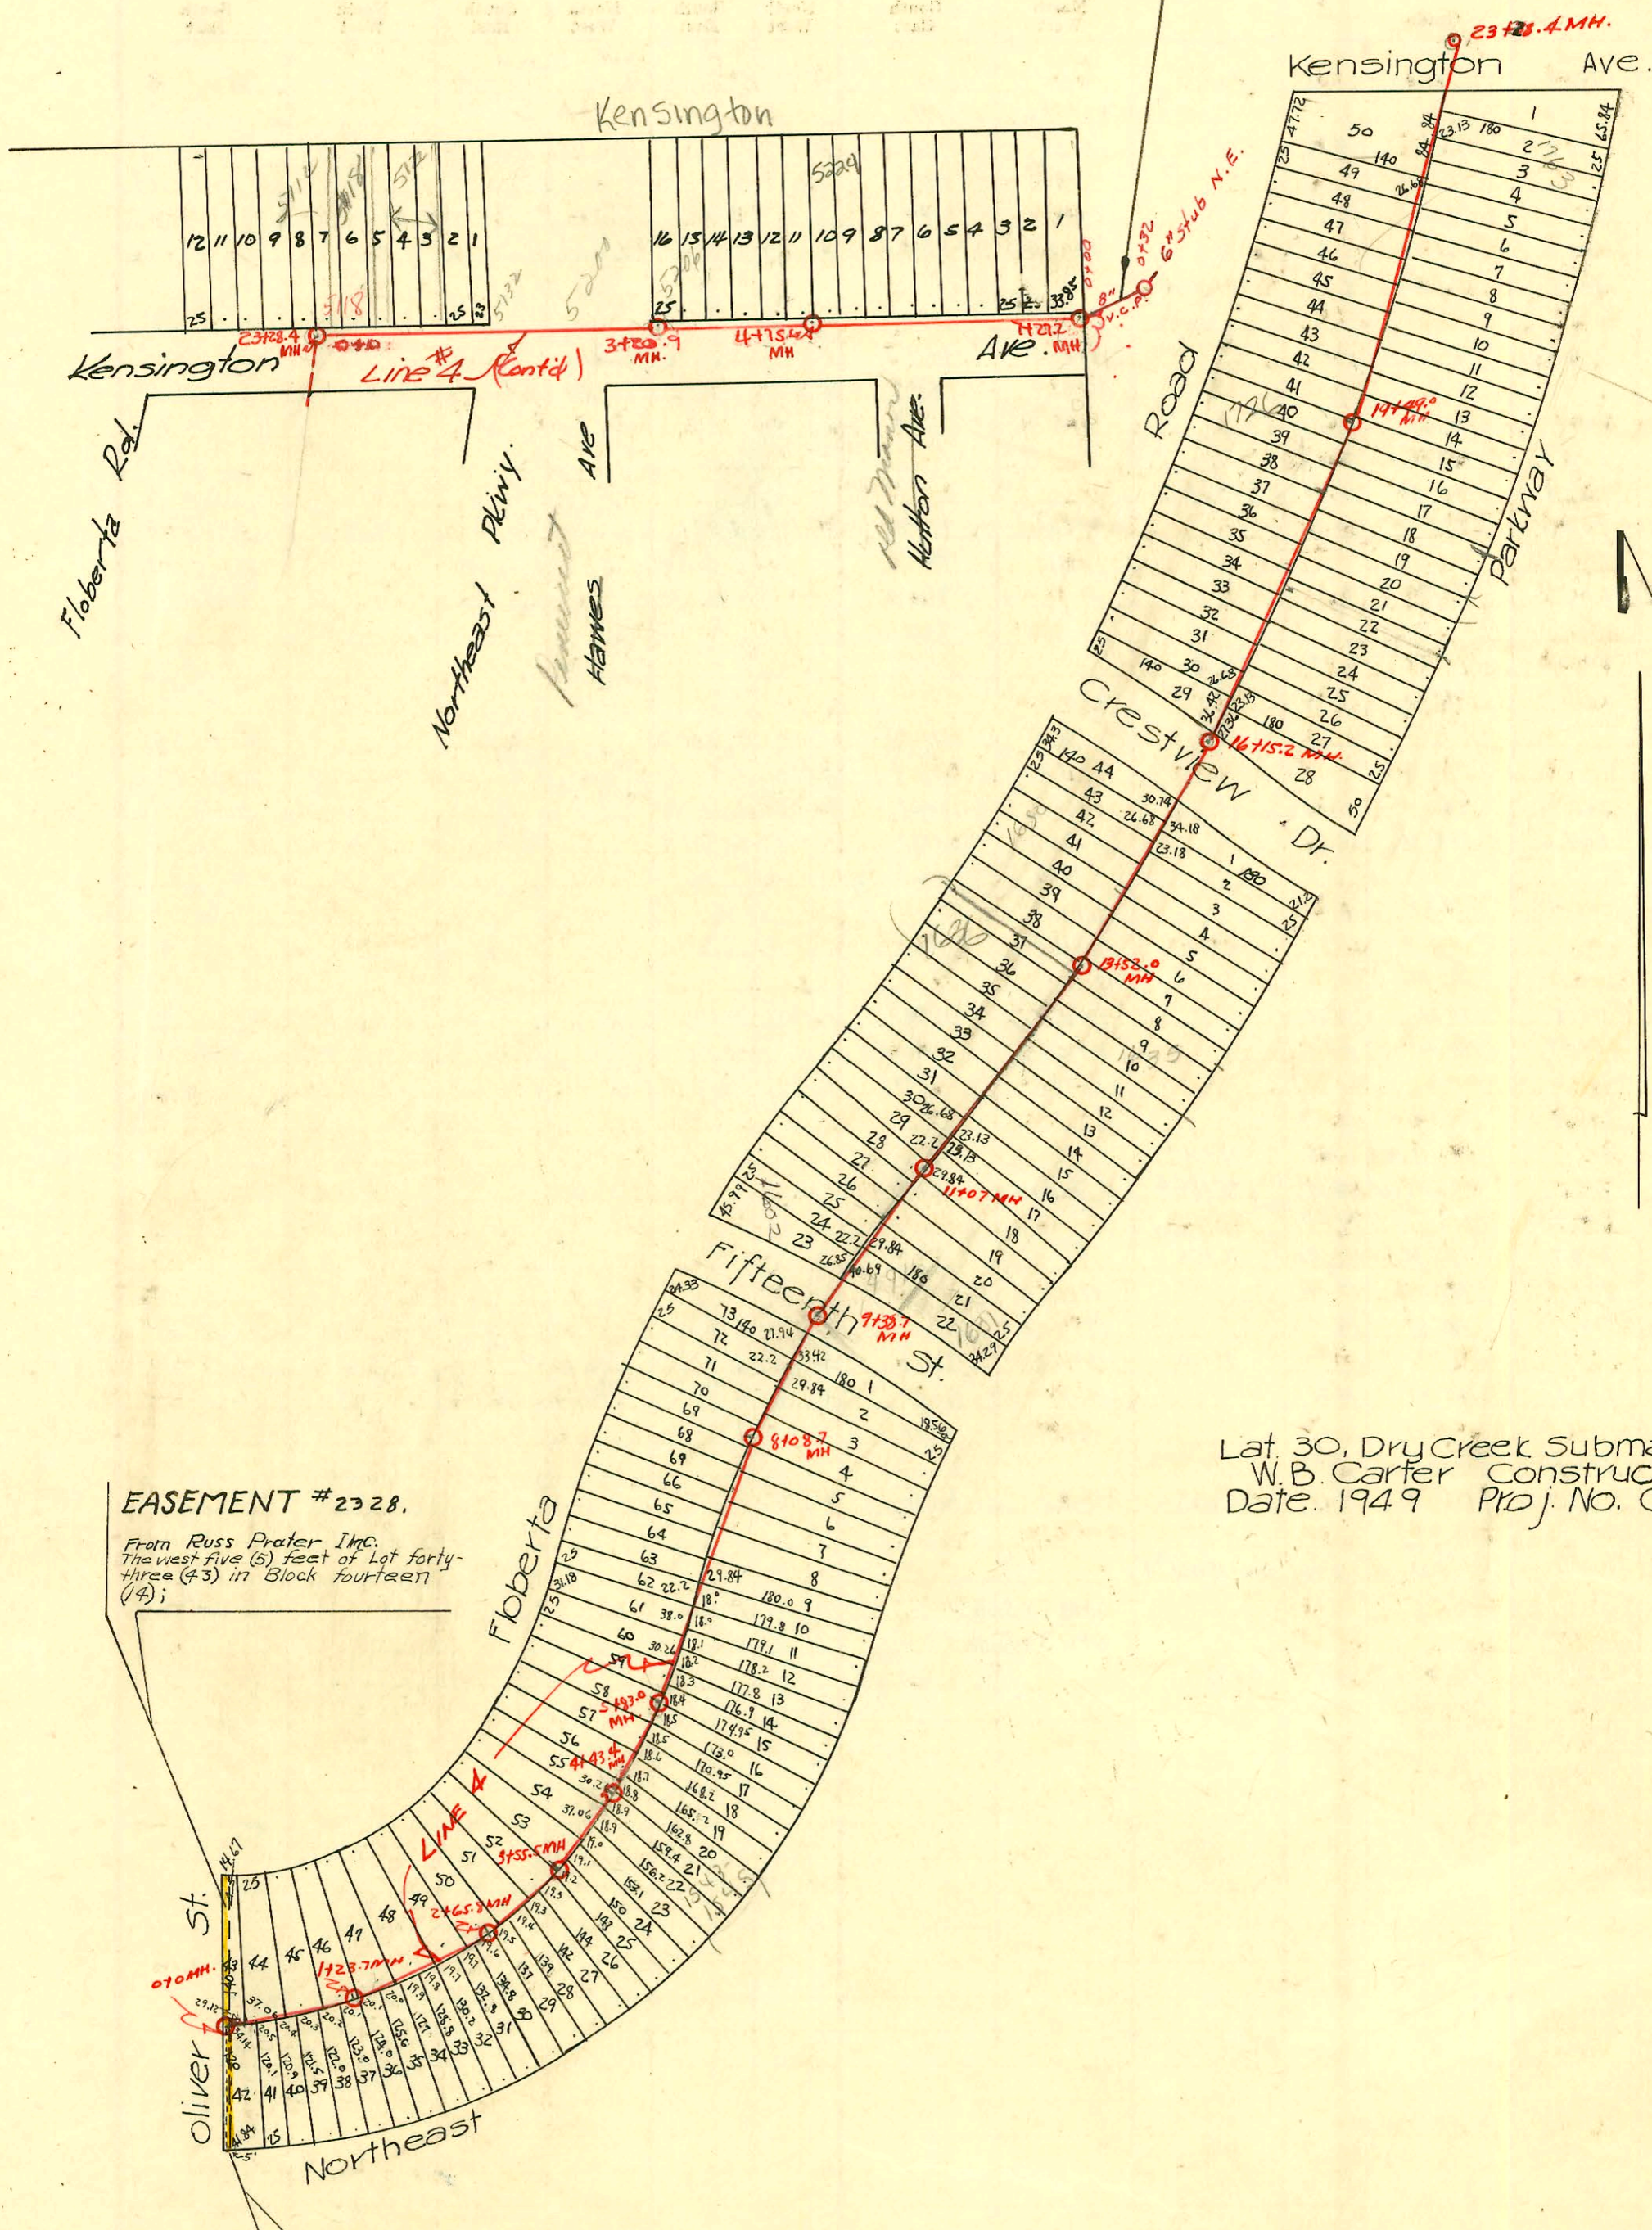

EASEMENT # 2328,
From Russ Prater Inc.
The west five (5) feet of Lot forty-
three (43) in Block fourteen
(14);

EASEMENT # 2327, The East
five (5) feet of the West ten (10) feet
of Lot forty-two (42), Block fourteen (14).

Lat. 30, Dry Creek Submain, SS #12
W.B. Carter Construction Co.
Date: 1949 Proj. No. C 28-27

- # 656-24 - 5132 Kensington - 5-21-50 - Pray Bros
- # 2671-24 - 5202 Kensington - 10-12-50 - Submittal
- # 2915-24 - 1602 Floberta - 10-31-50 - Brodie Pkg. Co.
- 2000-00585 # 6358-24 - 4916 E. 15th - 9-3-53 - Harry Mann - 3/6/00 - Roto Rooter - 4" SCH 40 - 1 TWIN CO ONLY
- # 1395-24 - 1442 N. Oliver - 7-6-54 - Harry Mann

CONSTRUCTION RECORD

SERVICE RECORD

STATION	ELEVATION		Depth	MANHOLE	4-INCH "Y" BRANCHES		No. of Permit		House Number		DATE OF PERMITS	
	Ground	Grade			North West	South East	North West	South East	North West	South East	North West	South East
0+0	210.0	195.67	15.30	0+0	South 0+19 C+91	North 0+16 +88	South #1706	North #1685	South 1507 N.E. Parkway #1685	North 1508 #1685	South 12-10-48	12-10-48
1+0	210.2	195.76	15.24						1515 N.E. Parkway		12-10-48	
1+23.9	209.8	195.78	14.62	1+23.7	1+46.9 +93.5	1 +90.5	#1707	#1686	1521 N.E. Parkway	1514 #1686	12-10-48	12-10-48
2+0	209.7	195.86	14.69		2+59.2	2+56.2	#1709	#1687	1527 N.E. Parkway	1520 #1687	12-10-48	12-10-48
2+65.8	209.1	195.92	13.74 13.97	2+65.8					1533 N.E. Parkway			
3+0	208.8	195.96	13.93		3+24.4 C+West	C+East	#1710				12-10-48	
0+0	214.3	205.00	10.00	0+0	North 0+23	South	#1635		5178 Kensington		9-14-49	
1+0	213.9	205.10	9.15		1+31.7							
2+0	213.8	205.20	9.53									
3+0	214.0	205.30	8.75		3+03.9		#1958		5200 Kensington		9-15-67	
3+20.9					3+20.9		#1958		5206 Kensington		8-14-50	
4+0	215.1	205.40	9.83		4+41.5		#1959		5210 Kensington		8-14-50	
4+75.0	215.8	205.47	8.36	4+75.0	4+41.5		#1481		5224 Kensington		9-1-49	
5+0	216.2	205.50	8.65		5+41.6		#1090		5236 Kensington		5-18-50	
6+0	217.2	209.60	9.51		6+70.5		#1482		5302 Kensington		9-1-49	
7+0	218.0	209.70	10.87		7+17.7							
7+27.2	218.2	209.73	11.34	7+27.2	30+66.1							
0+00	218.00	210.50	7.5	Exist. 0+00								
0+32	219.2	211.46	7.7	0+32		6" stub N.E.	#16175		1601 N. Kidgewood		8-12-66	

LINE 4

Line 4 (Continued)

"Extension"

#1774 - 24 - 1744 Floberta - 12-20-48 - Brodie Pelly Co.
 #1775 - 24 - 1750 Floberta - 12-20-48 - Brodie Pelly Co.
 #1783 - 24 - 1739 N. E. Parkway - 12-20-48 - Brodie Pelly Co.
 #1785 - 24 - 1751 N. E. Parkway - 12-20-48 - Brodie Pelly Co.
 #1636 - 24 - 5122 Kensington - 9-14-49 - Pray Bros.
 #1637 - 24 - 5128 Kensington - 9-14-49 - Pray Bros.
 #631 - Top - 5202 Kensington - 4-21-50 - Cigno Reynolds
 #6647 - 16 - 5206 Kensington - 11-29-51 - Jack C. Day (6+61.6) repair 10/1/68
 #6650 - Top - 5200 Kensington - 11-29-51 - Jack C. Day (6507) 5.01 2-16-78. Jack Brunner (7+12.2)