

N

SERVICE RECORD

CONSTRUCTION RECORD

BAYLEY

AVE

266	1	128.5	6+38.2 M.H.	2	128.5	26.33
25	3			4		25
	5			6		
	7			8		
	9			10		
	11			12		
	13			14		
	15			16		
	17			18		
	19			20		
1028	21			22		
	23			24		
	25			26		
	27		3+19.2 M.H.	28		
	29			30		
	31			32		
	33			34		
	35			36		
	37			38		
	39			40		
	41			42		
	43			44		
	45			46		
25	47	128.5		48		25

AVE


AVE

YALE

ROOSEVELT

ZIMMERLY

AVE

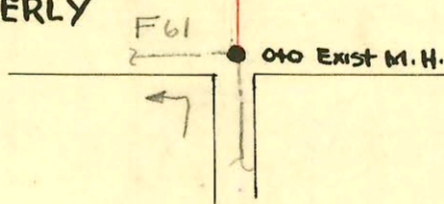

LAT 16 DIST 6 SS 12
 W.B. CARTER CONST. CO APR. 1949
 PROJ. NO. C-28-39

CONSTRUCTION RECORD						SERVICE RECORD						
STATION	ELEVATION		Depth	MANHOLE	4-INCH "Y" BRANCHES		No. of Permit		House Number		DATE OF PERMITS	
	Ground	Grade			North West	South East	North West	South East	North West	South East	North West	South East
0+0		141.81	10.95		0+71.8	0+68.8						
1+0	153.0	141.91	11.57		1+12.0 1+10.7 +35.7 1+82.0	1+07.7 +32.7 +79.0	#4714 #2234 199-00897 #2324		1052 S. Yale 3766 E. Jmmuelly 1048 S. Yale	1055 S. Roosevelt	11-18-81 10-28-49 10-12-49 11-4-49	5-17-49
2+0	153.6	142.01	12.10		2+01.7 2+34.8 +61.8 +94.6	+31.8 +58.8 +91.6	#1399 #71 #1056 #1145		1042 S. Yale 1038 S. Yale 1035 S. Roosevelt	1051 S. Roosevelt	8-27-49 5-16-50	4-23-49 5-5-52
3+0	152.8	142.11	10.99									
3+19.2		142.13	10.63	3+19.2	3+27.1 +63.8 +97.7	3+24.1 +60.8 3+94.7	#6010 #4021 #1363 #4893	21332	1024 S. Yale 1028 S. Yale	1031 E. Roosevelt 1023 S. Roosevelt	10-2-51 3-5-51	8-19-88 7-23-80 6-7-51
4+0	152.3	142.21	10.39		4+22.7 +45.1 +77.2		#2018 #926 #490		1022 S. Yale 1018 S. Yale	1017 S. Roosevelt	10-14-49 7-19-49	4-1-54
5+0	151.6	142.31	9.64		5+04.5 +46.8	5+43.8	06-00464 #3242 #5211		1012 S. Yale 1011 S. Roosevelt		2-16-00 2-7-50	5-14-53
6+0		142.41	8.81		6+10.1	6+07.1	#4569 #282		1008 S. Yale	3721 E. Banbury	5-7-51	5-24-49
6+38.2		142.45	8.03	6+38.2								

*#2908
10412 Roosevelt
12-23-49

#231 - Private Line - 1051 S. Roosevelt - 5-17-49 - J. E. Landrose.
 #869 - Tap - 1008 S. Yale - 5-5-50 - H. H. Crnkovic
 #21334 - 8/19/88 B1023 S. Roosevelt -