


SERVICE RECORD

CONSTRUCTION

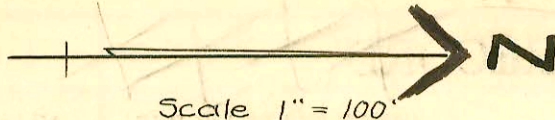

Scale 1" = 100'

HYDRAULIC

AVE.

54'	1	1703	54'
53'	2	1709	53'
	3	1713	
	4	1719	
	5	1723	
	6	1729	
	7	1733	
53'	8	1739	53'

54'	9	1703	54'
53'	10	1705	53'
	11	1713	
	12	1719	
	13	1723	
	14	1729	
	15	1733	
53'	16	1738	53'

54'	1	1703	54'
53'	2	1709	53'
	3	1713	
	4	1719	
	5	1723	
	6	1729	
	7	1733	
53'	8	1739	53'

KANSAS

AVE.

50'	1	1803	50'
	2	1807	
	3	1813	
	4	1817	
	5	1821	
	6	1827	
	7	1903	
	8	1907	
	9	1913	
	10	1917	
	11	1926	
50'	12	1927	50'

50'	13	1803	50'
	14	1807	
	15	1813	
	16	1817	
	17	1821	
	18	1827	
	19	1903	
	20	1907	
	21	1913	
	22	1917	
	23	1921	
50'	24	1927	50'

50'	1	1803	50'
	2	1807	
	3	1813	
	4	1817	
	5	1821	
	6	1827	
	7	1903	
	8	1907	
	9	1913	
	10	1917	
	11	1920	
50'	12	1927	50'

MINNESOTA

AVE.

53'	12	2412	53'
52'	11	2419	52'
	10	2430	
	9	2434	
	8	2442	
	7	2446	
	6	2450	
	5	2451	
	4	2458	
	3	2402	
	2	2466	
30'	1	2409	30'

0+00 Existing M.H.

11+20.8 M.H.

17+87.0 M.H.

8+51.8 M.H.

15+10.5 M.H.

5+68.2 M.H.

12+26.3 M.H.

2+84.0 M.H.

9+42.7 M.H.

3+40.5 M.H.


6+66.2 M.H.

LINE #1

LINE #2

LINE #7

F 258

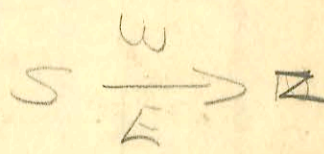

Mc Farland St

LAT. 18, DIST. T, S.S. # 12  
 CITY OF WICHITA, KANSAS  
 L. K. WHITE CITY ENGINEER  
 EBY CONSTRUCTION CO. 1950  
 PROJECT NO. C 29-62

CONSTRUCTION RECORD

SERVICE RECORD

STATION	ELEVATION		Depth	MANHOLE	4-INCH "Y" BRANCHES		No. of Permit		House Number		DATE OF PERMITS	
	Ground	Grade			North West	South East	North West	South East	North West	South East	North West	South East
0+00	125.3	117.02	8.48	0+00 Exist M.H.		0+20.6		# 937				5-10-50
1+0	125.7	117.12	8.83			+76.0		# 938				5-10-50
2+0	126.0	117.22	9.01			+81.3		# 940				5-10-50
3+0	126.6	117.32	9.57			+86.0		# 941				5-10-50
3+40.5	126.6	117.36	9.50	3+40.5		+86.0		# 942				5-10-50
4+0	127.3	117.42	10.09			+86.0		# 943				5-10-50
5+0	128.2	117.52	10.89			+86.0		# 945				5-10-50
6+0	128.8	117.62	11.42			+86.0		# 945				5-10-50
6+66.2	128.7	117.89	11.04 out	6+66.2		+86.0		# 945				5-10-50
7+0	128.1	117.92	10.42			+86.0		# 945				5-10-50
8+0	127.1	118.02	9.37			+86.0		# 945				5-10-50
9+0	128.0	118.12	10.15			+86.0		# 945				5-10-50
9+42.7	128.3	118.17	10.33	9+42.7		+86.0		# 945				5-10-50
10+0	128.0	118.22	10.04			+86.0		# 945				5-10-50
11+0	127.5	118.32	9.41			+86.0		# 945				5-10-50
12+0	127.1	118.42	8.97			+86.0		# 945				5-10-50
12+26.3	127.4	118.45	9.20	12+26.3		+86.0		# 945				5-10-50
13+0	127.4	118.52	9.14			+86.0		# 945				5-10-50
14+0	127.1	118.62	8.74			+86.0		# 945				5-10-50
15+0	126.9	118.72	8.46			+86.0		# 945				5-10-50
15+10.5	126.8	118.73	8.36	15+10.5		+86.0		# 945				5-10-50
16+0	126.5	118.82	7.96			+86.0		# 945				5-10-50
17+0	126.4	118.92	7.76			+86.0		# 945				5-10-50
17+87	127.0	119.01	8.23	17+87.0		+86.0		# 945				5-10-50

Line #1

Line #2

2001-03039-11/29/03-1903 E McFarland-4" sch 40-17WINCO-1122, Tied back to clay tile aprx 1' from main  
 R-2000-01852-8/18/00-2450 N Minnesota-4" sch 40-WYE CON-Tied to wye w/donut, 17WINCO.  
 C61118-1812 E 24th - 5-12-77-top 11+96.3

- # 796-2444 N. Hydraulic - 5-1-50 - Wichita Pkg. Co.
- # 3431-244 - 1917 McFarland - 12-20-50 - Curtis Pkg. Co.
- # 3460-244 at 17+17.2 - 1709 McFarland - 12-9-52 - H. H. Creechmore -
- # B3745 Seal off - 1709 McFarland - Phil. Dranching - 7-6-65 (17+17.2)
- # B5717 Seal off - 3444 N. Hydraulic - Headgate - 5-27-66