


Extension of Lat. 3, S.S. #21
Mid-states Construction Co., Inc.
Booked From 56#4 JK, March 24, 1970.
Private Project

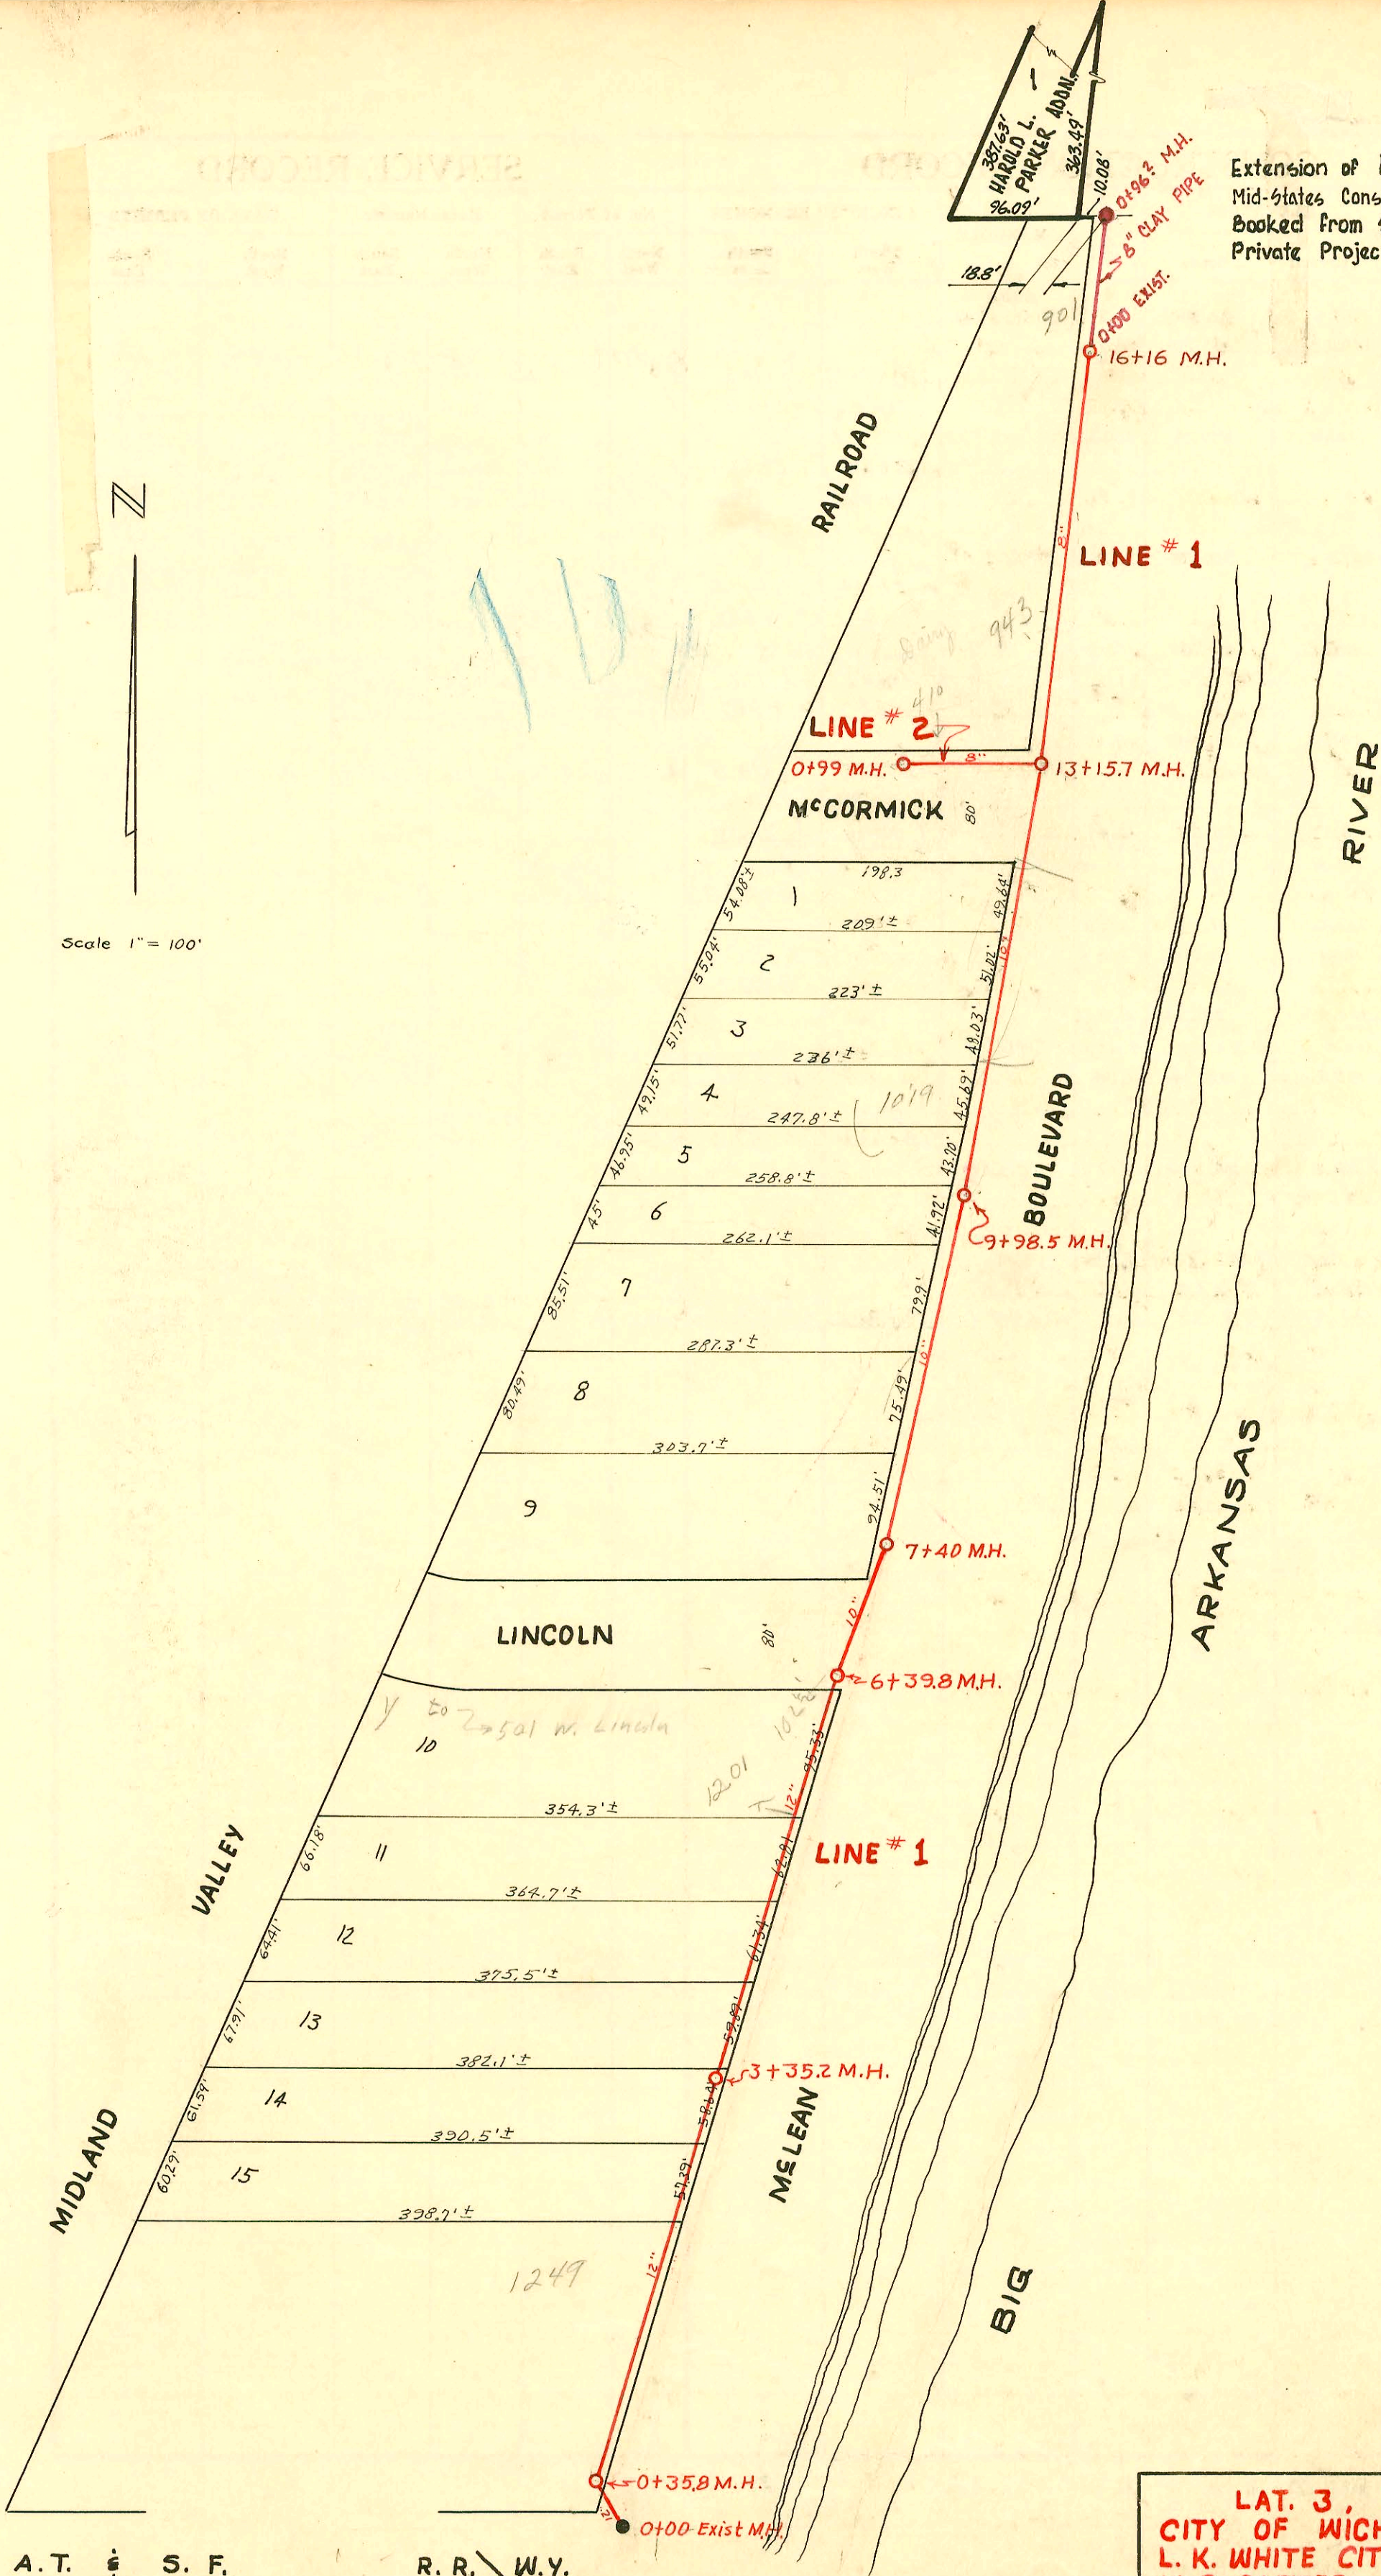

LAT. 3, S.S. #21
CITY OF WICHITA, KANSAS
L. K. WHITE CITY ENGINEER
W. B. CARTER 1950
PROJECT NO. C 29-61

Book # M-1

