


CONSTRUCTION RECORD


N

Scale 1"=100'

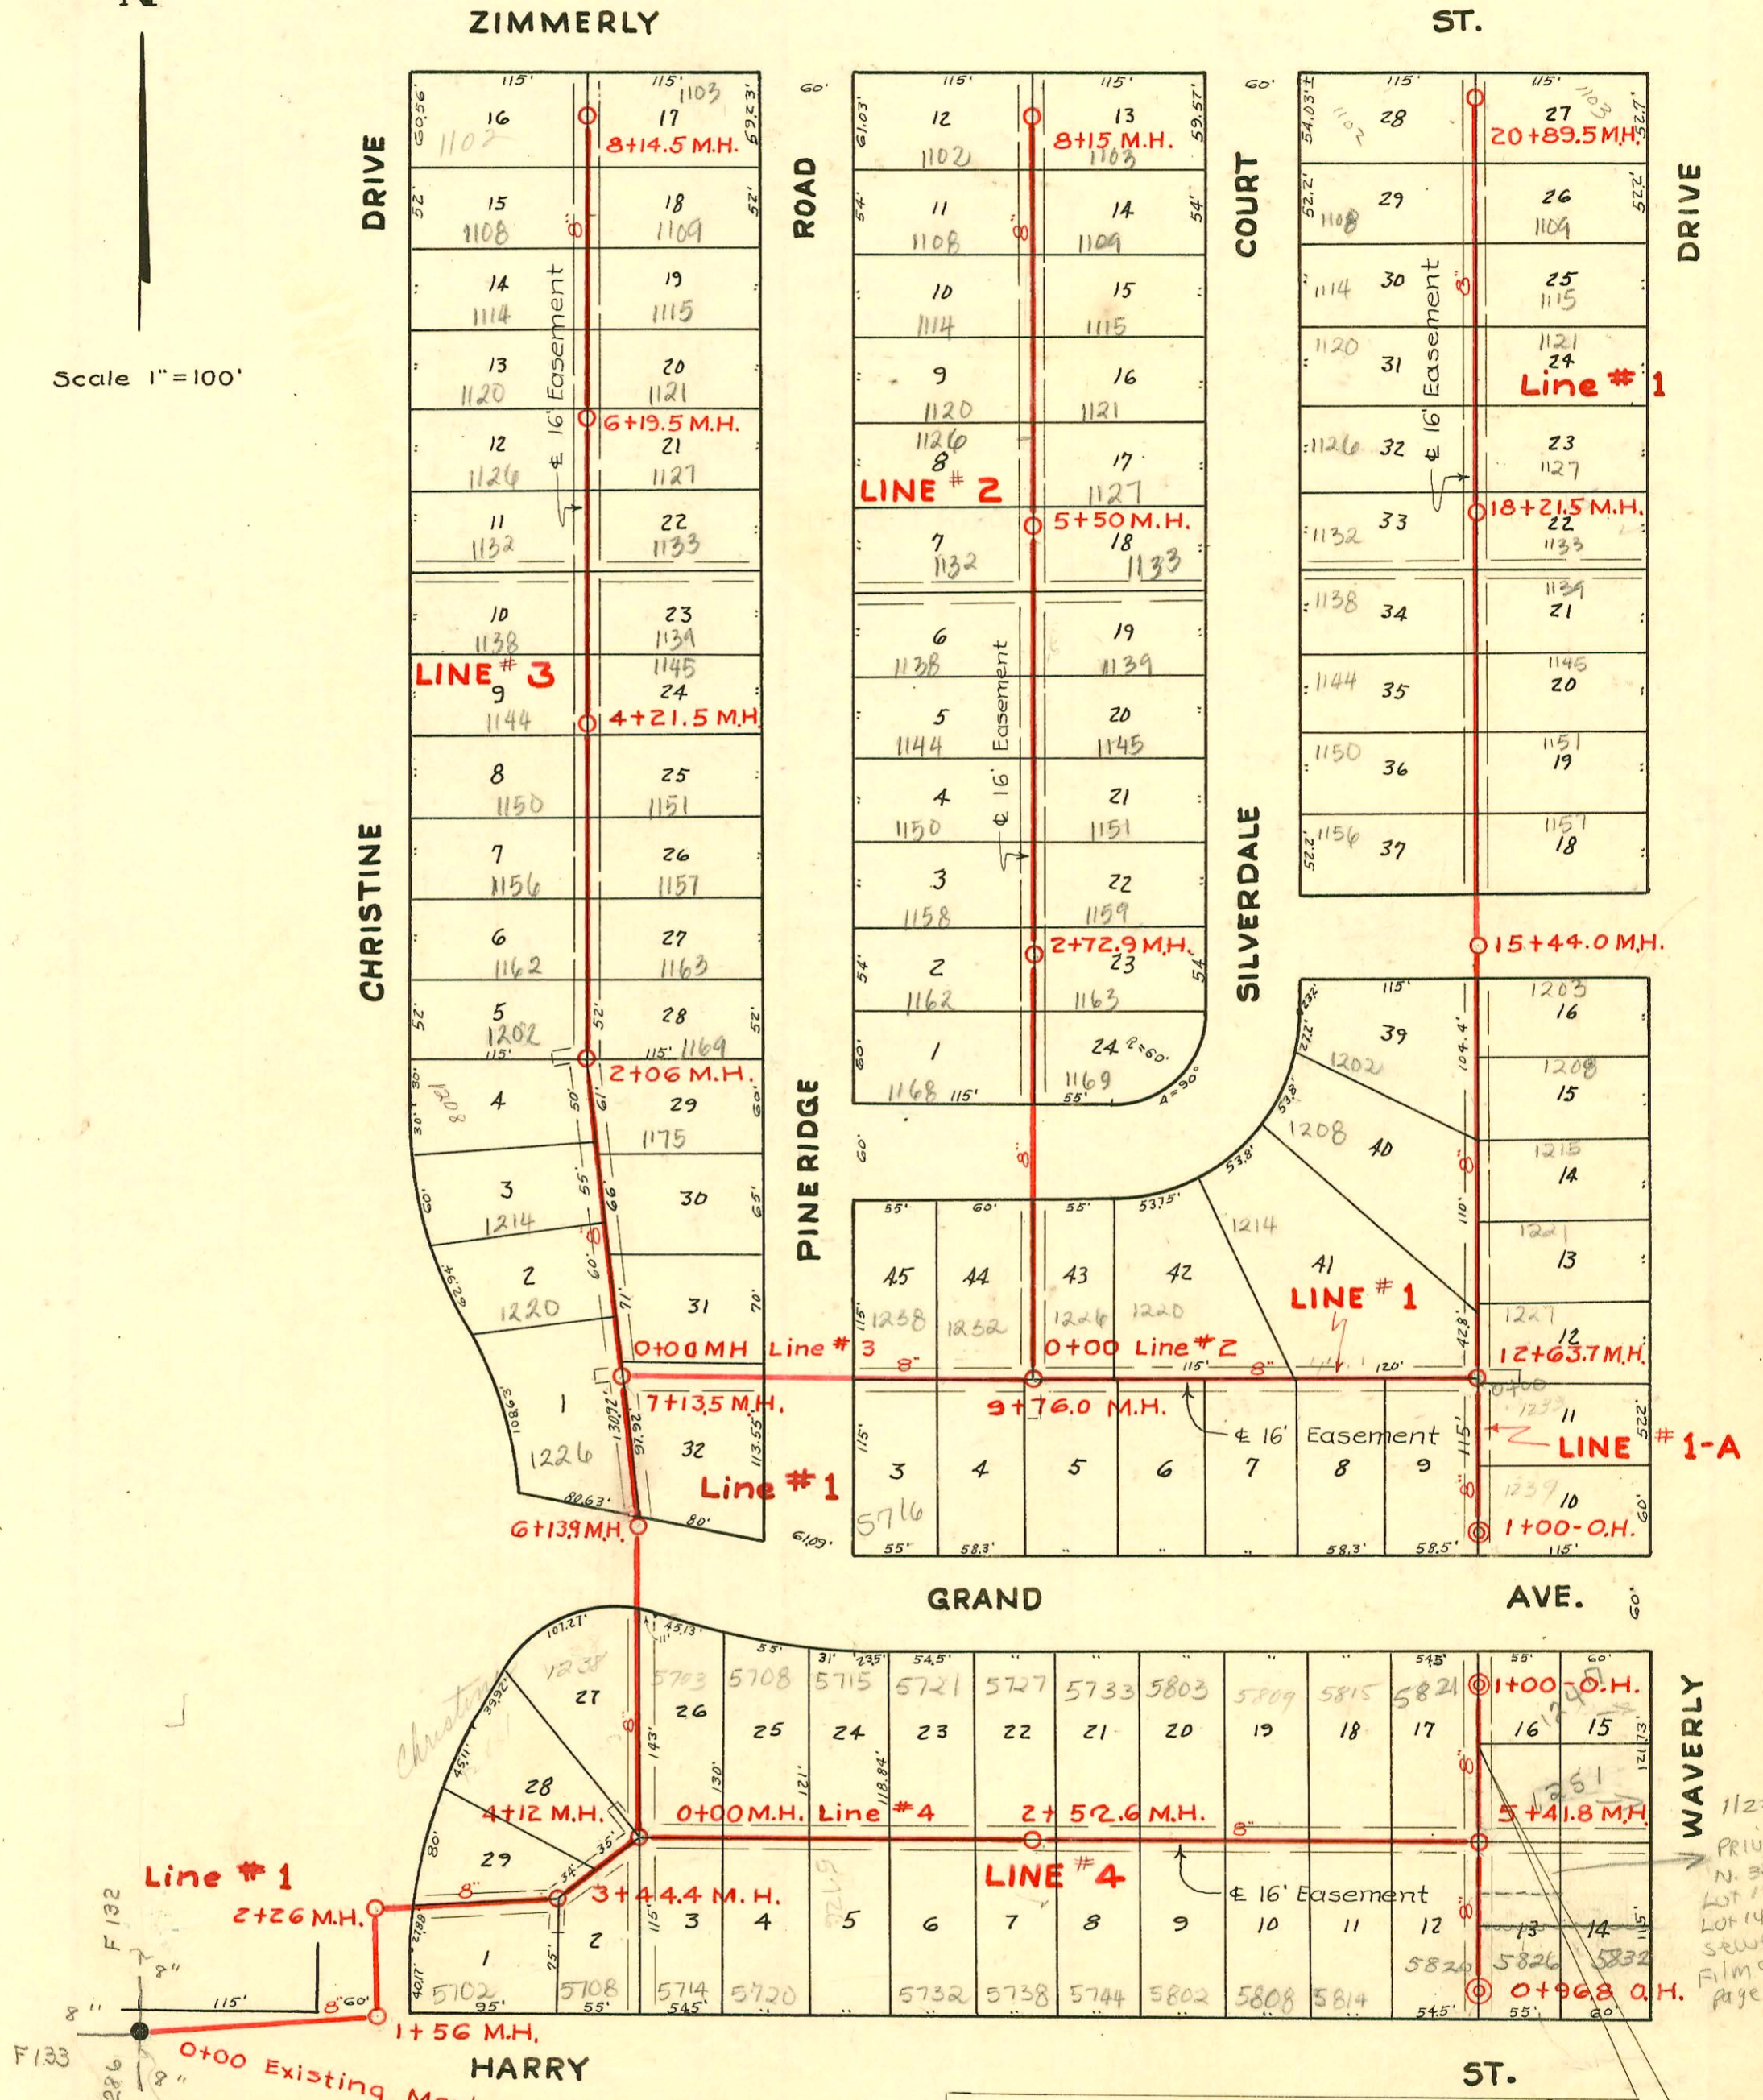

Note: The Lateral running North from Line 4 all Wye's are West Wye's and the City is to issue taps at no charge to Lots on the East.

LAT. 43, DRY CREEK SUBMAIN, S.S.#12
 CITY OF WICHITA, KANS.
 L.K. WHITE CITY ENGINEER
 W. B. CARTER 1950
 PROJECT NO. C 20- 6
 Book #44

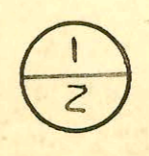

1122188
 Private Ewe
 N. 35' of
 Lot 13 to
 Lot 14 for
 sewer.
 Film 944
 page 1230

CONSTRUCTION RECORD

SERVICE RECORD

LINE # 1

STATION	ELEVATION		Depth	MANHOLE	4-INCH "Y" BRANCHES		No. of Permit		House Number		DATE OF PERMITS	
	Ground	Grade			North West	South East	North West	South East	North West	South East	North West	South East
0+00	146.6	137.22	9.59	0+00 Exist M.H.	Y North	Y South						
1+00	146.5	137.32	9.44									
1+56	147.2	137.39	10.12 in 10.06 out	1+56								
2+00	147.1	137.42	9.97									
2+26	147.1 147.2	137.45 137.45	9.92 in 9.91 out	2+26								
3+00	147.4	137.52	10.11	3+44.4	3+64.8 +89.1	3+61.8	#2139 #2138	5702 E. Harry 5708 E. Harry			4-31-50 8-31-50	
4+00	147.1	137.62	9.68		Y West	Y East	#2088	1244 Christini			8-24-50	
4+12	147.2	137.63	9.80	4+12	4+85.4		#2086	1239 Christini			8-24-50	
5+00	147.4	137.72	9.90									
6+00	148.0	137.82	10.41 10.64 in									
6+13.9	148.2	137.83	10.58 out	6+13.9	6+30.2							
7+00	149.1	137.92	11.38 11.23 in		Y North	Y South						
7+13.5	149.3	138.13	11.39 out	7+13.5	7+45.5	7+48.5	#479 #1503	1209 Omeridge 1238 Subudale	1215 Omeridge 5716 Grand		4-13-50 7-1-50	4-13-50 7-1-50
8+00	148.2	138.22	10.18		8+92.0	8+95	#1502	1232 Subudale	5722 Grand		7-1-50	7-1-50
9+00	147.0	138.32	8.95		9+38.1	9+41.1						
9+76	146.6	138.40	8.49	9+76								
10+00	146.5	138.42	8.35		10+07.6	10+10.6 +62.7	#1501	1226 Subudale	5728 Grand		7-1-50	7-1-50
11+00	145.9	138.52	7.62		11+18.0	11+21.0 +69.0	#1500	1220 Subudale	5734 Grand		7-1-50	8-24-50
12+00	146.0	138.62	7.61 7.48 in		12+26.0	12+29.0	#2078	1220 Subudale	5808 Grand		8-24-50	8-24-50
12+63.7	146.0	138.69	7.55 out	12+63.7	Y West	Y East	#2072					
13+00	145.7	138.72	7.20		13+38.6	13+35.6 +84.4	#1725	1208 Subudale	1221 Wardley		7-24-50	7-24-50
14+00	144.1	138.82	5.57		14+39.2	14+36.2 +84.8	#1724	1202 Subudale	1209 Wardley		7-24-50	7-24-50
15+00	143.7	138.92	4.98 5.01 in		15+44.0							
15+44.0	143.6	138.97	4.92 out									
16+00	144.1	139.02	5.37		16+06.7	16+03.7 +59.2	#1722	1156 Subudale	1157 Wardley		7-24-50	7-24-50
17+00	144.9	139.12	6.02		17+07.8	17+04.8 +59.7	#1721	1150 Subudale	1151 Wardley		7-24-50	7-24-50
18+00	146.6	139.22	7.58		18+09.0	18+06.0 +58.4	#1720	1144 Subudale	1145 Wardley		7-24-50	7-24-50
18+21.5	146.8	139.24	7.83	18+21.5	+58.4	+55.4	#1719	1138 Subudale	1139 Wardley		7-24-50	7-24-50
19+00	147.0	139.32	7.85		19+07.1	19+04.1 +59.0	#1718	1132 Subudale	1133 Wardley		7-24-50	7-24-50
20+00	146.8	139.42	7.60		20+08.5	20+05.5 +60.8	#1717	1126 Subudale	1127 Wardley		7-24-50	7-24-50
20+89.5	146.2	139.50	7.03	20+89.5	+60.8	+57.8	#1716	1120 Subudale	1121 Wardley		7-24-50	7-24-50
					Y WEST	Y EAST	#1715	1114 Subudale	1115 Wardley		7-24-50	7-24-50
							#1714	1108 Subudale	1109 Wardley		7-24-50	7-24-50
							#1713	1102 Subudale	1103 Wardley		7-24-50	7-24-50
							#1712	1100 Subudale	1101 Wardley		7-24-50	7-24-50
							#1711	1098 Subudale	1099 Wardley		7-24-50	7-24-50
							#1647	970 Subudale	971 Wardley		7-24-50	7-24-50