F 182 A

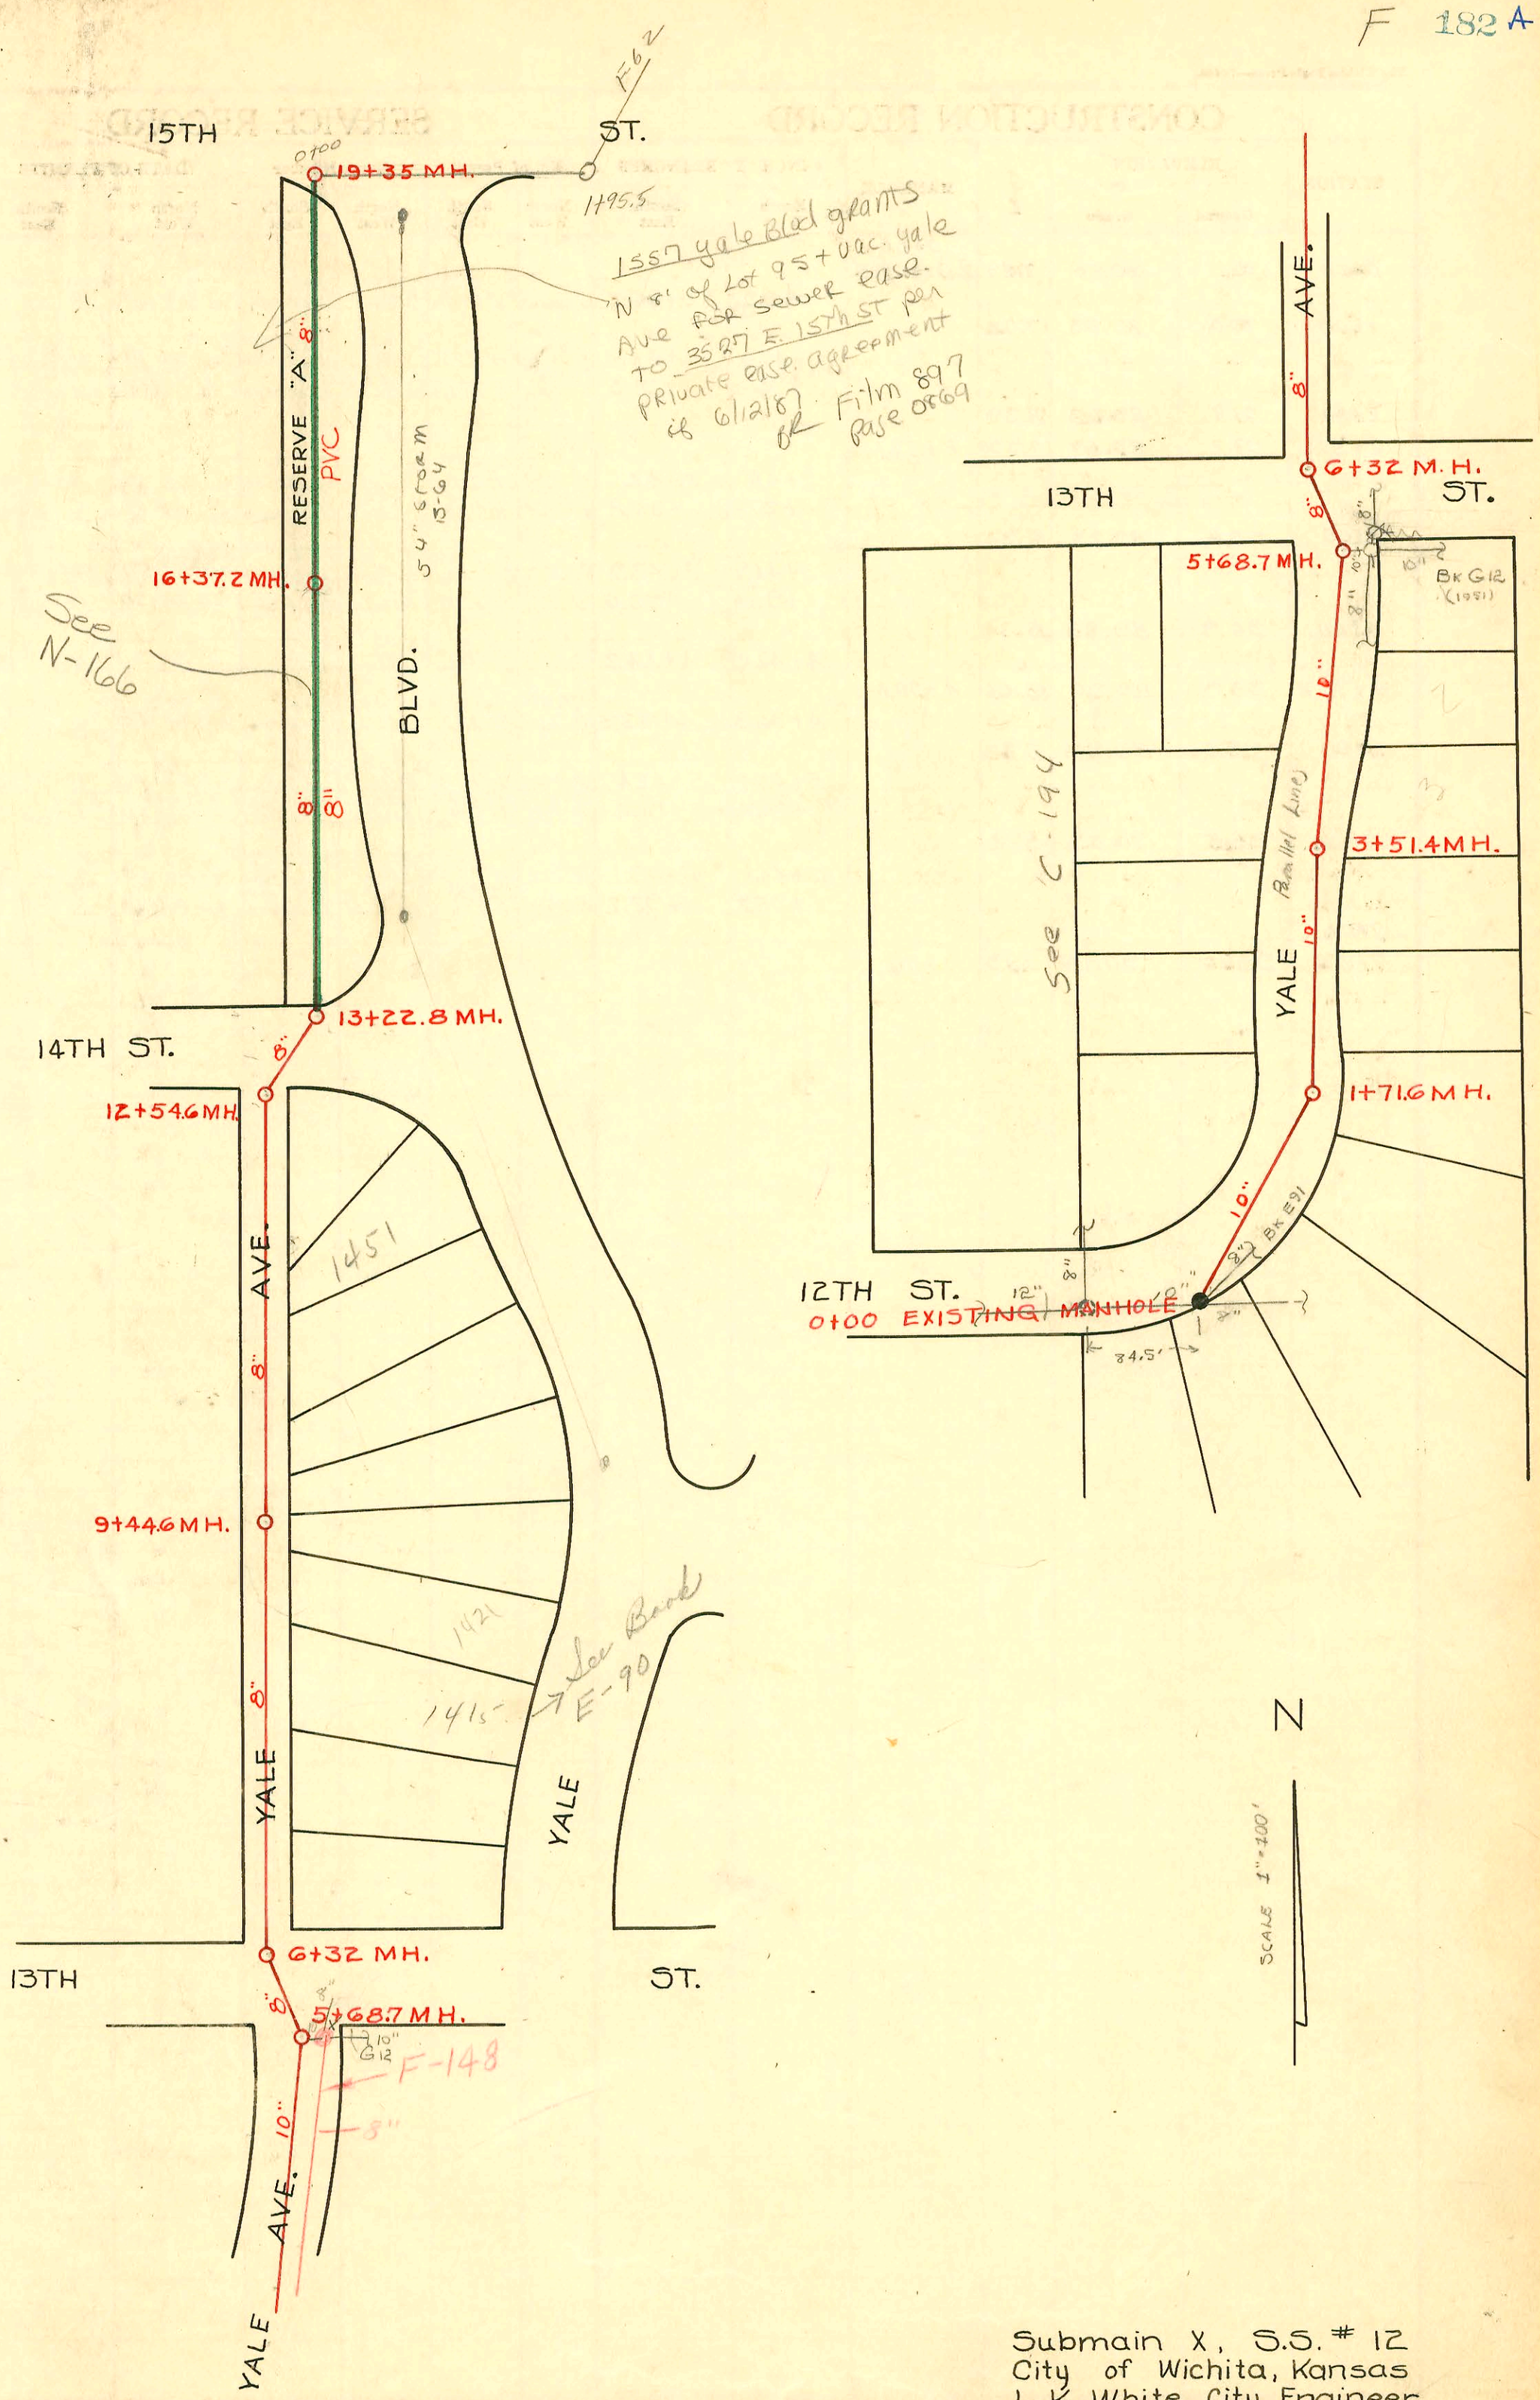

Submain X, S.S. # 12
City of Wichita, Kansas
L. K. White City Engineer
Martin K. Eby 1950
Project No. C-29-54, Book #43

The Wichita Eagle Press—76405

CONSTRUCTION RECORD							SERVICE RECORD					
STATION	ELEVATION		Depth	MANHOLE	4-INCH "Y" BRANCHES		No. of Permit		House Number		DATE OF PERMITS	
	Ground	Grade			North West	South East	North West	South East	North West	South East	North West	South East
0+00	172.2	167.40	5.09	0+00 Exist'g MH.								
1+00	169.9	167.50	2.66									
1+71.6	171.6	167.57 167.57	4.28 in 4.23 out	1+71.6								
2+00	172.2	167.60	4.89									
3+00	174.3	167.70	6.88									
3+51.4	175.1	167.75	7.60 in 7.62 out	3+51.4								
4+00	175.2	167.80	7.61									
5+00	173.6	167.90	5.94									
5+68.7	172.2 172.3	167.97	4.45 in 4.60 out	5+68.7								
6+00	172.2	168.03	4.39									
6+32	172.4 172.5	168.10	4.56 in 4.67 out	3'10" meas. in fld 6+32								
7+00	176.7	168.24	8.67									
8+00	179.9	168.44	11.66									
9+00	181.4	168.64	13.01									
9+44.6	181.4	168.73	12.93	9+44.6								
10+00	182.0	168.83	13.38									
11+00	181.4	169.03	12.66									
12+00	180.0	169.23	11.01									
12+54.6	178.4 178.8	169.34	9.32 in 9.65 out	12+54.6								
13+00	177.8	169.43	8.55									
13+22.8	176.4 176.8	169.50	7.19 in 7.54 out	13+22.8								
14+00	175.9	169.63	6.56									
15+00	174.1	169.83	4.49									
16+00	175.5	170.03	5.67									
16+37.2	176.1	170.10	6.24	16+37.2								
17+00	177.8	170.23	7.82									
18+00	176.6	170.43	6.42		18+37.0		18605		3587 Eso 15th		6-30-87	
19+00	181.7	170.63	11.36		19+30.2		18606		3527 E. 15th		6-30-87	
19+35	181.7	170.70	11.29	19+35								
		174.80										
0+00	181.70	170.70	11.29	0+00								
	182.58	175.98	6.60	1+95.5								

3168 - Tap - 3515 E. 15th - 11-21-50 - E. B. Brunner

Used old connection # 2023 - 1557 N. Yale - 9-15-54 - Richard Le Fay Jr

2892 - Tap - 1513 Yale Blvd. - 12-7-54 - Jack Derbaum

2893 - Tap - 3527 E. 15th - 12-7-54 - Richard Le Fay Jr.

2704 Tap 1533 N Yale Blvd 10-9-55 - Al Henning (16+23.2)

6392 - tap - 1525 N Yale Blvd - 9-14-55 (15+63.7)

6092-93 - taps - 1541-47 N Yale - Reynolds 9-9-55

B5375 - tap - 1519 Yale Blvd - Moon + Sons 3-31-66

C440 - Tap - 1537 N. Yale Blvd - Barnes Bldg 10/14/66 (15+06.2)

91-29008-7 - 7/25/91 - 1547 N Yale Blvd - Kent Burger (16+86.8)
(6" wye 151's of MH 4" sch 40 PVC)