

CONSTRUCTION RECORD


6" y

AVE. SCOTT ST. AVE.

0+00 Existing Manhole

TRAP AREA

6" y

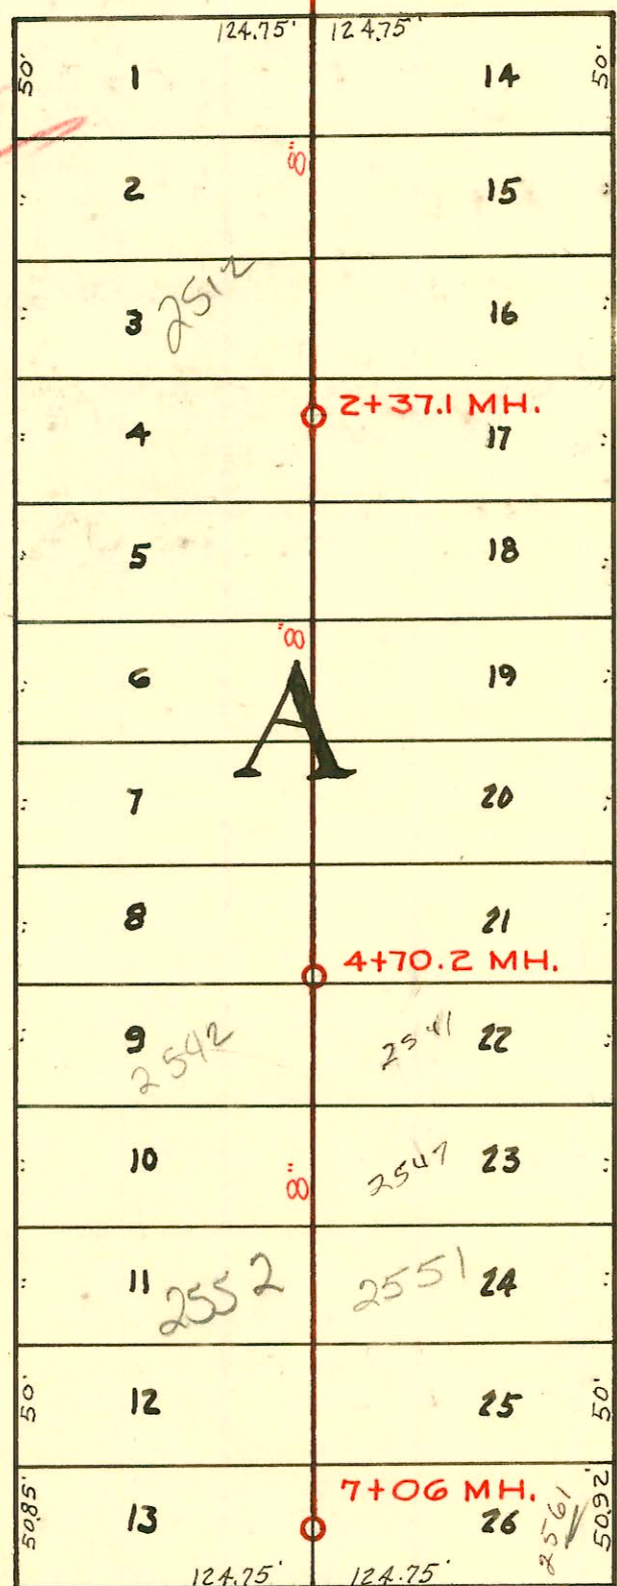

6" y

MARION ROAD

6" y

Lat. 14, Dist. B, S.S. # 20  
 City of Wichita, Kansas  
 L.K. White City Engineer  
 W. B. Carter 1950  
 Project No. C 29-63  
 Book # 32

