
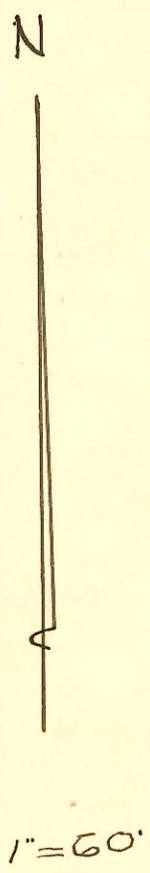


REVERSE RECORD

CONSTRUCTIVE RECORD

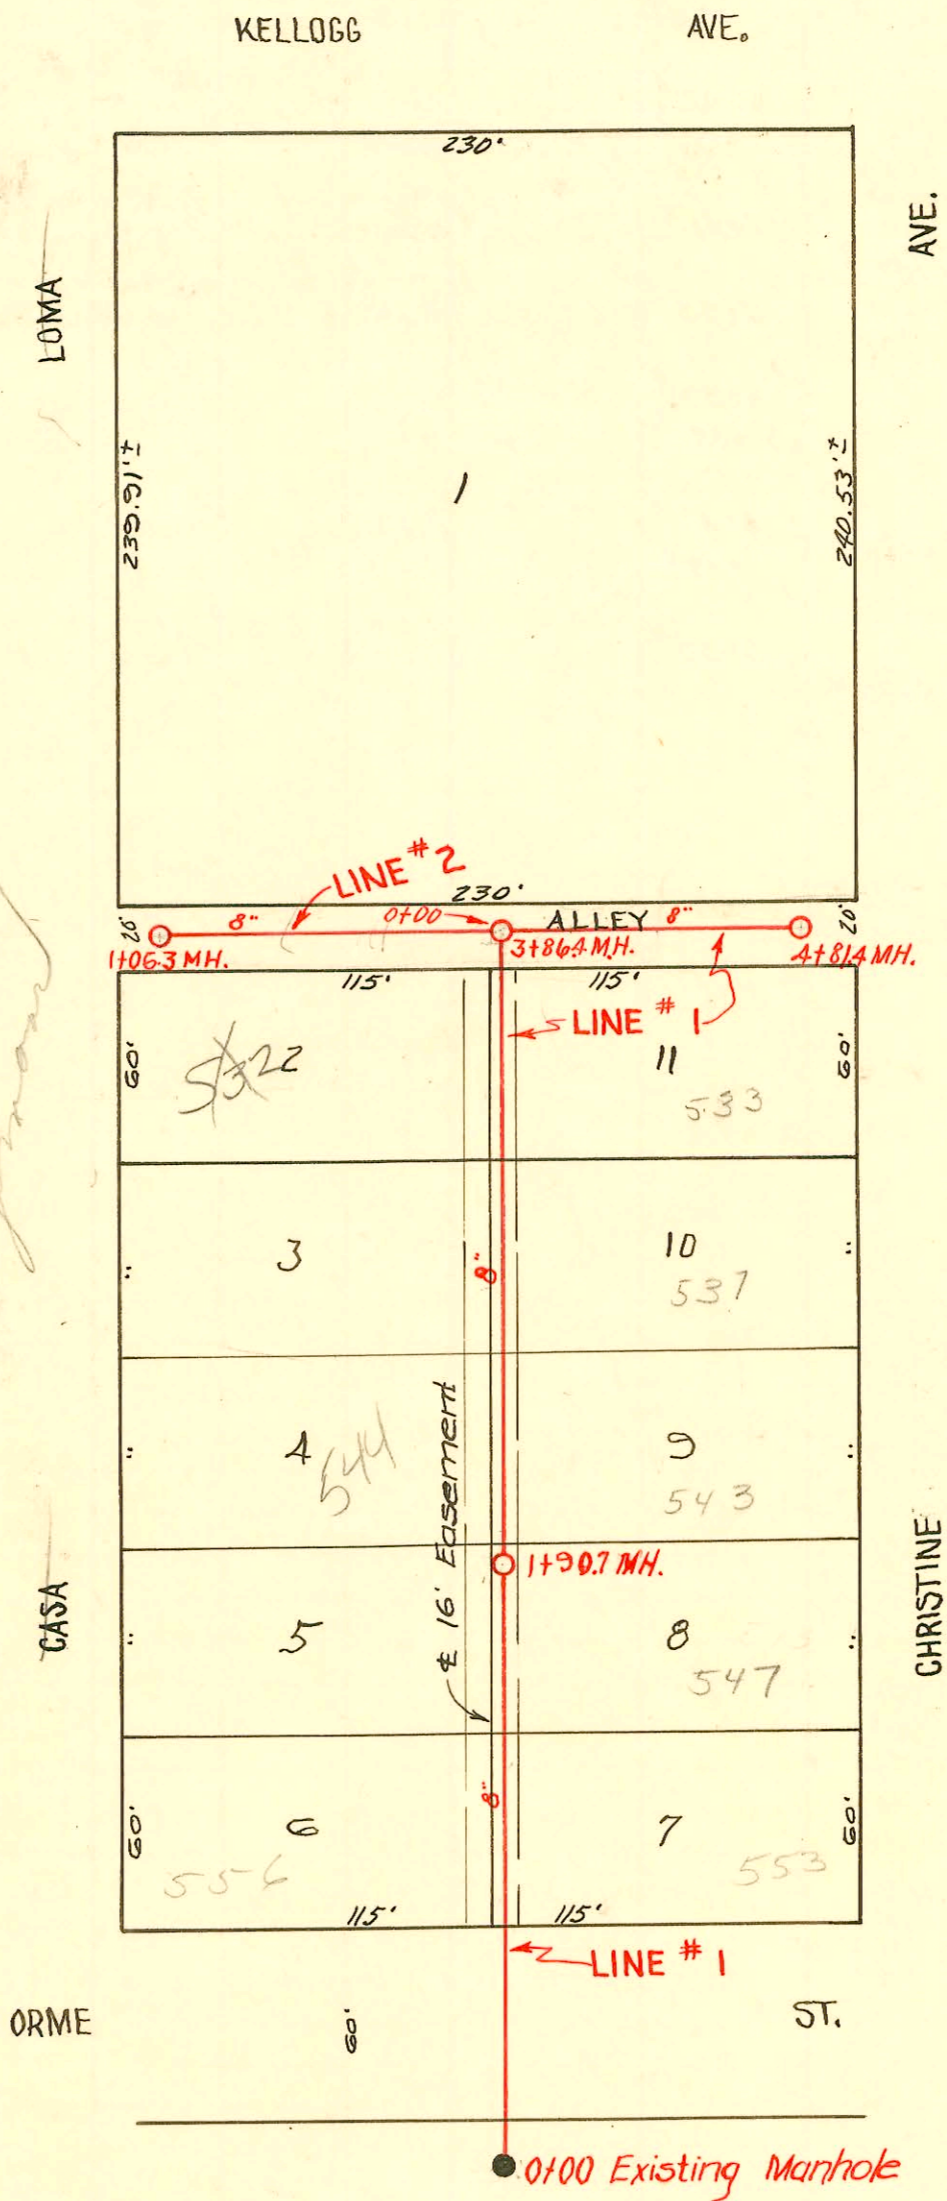

Edgman

CASA

CHRISTINE

Lat. 46, D.C.S. S. S. #12
 City of Wichita, Kansas
 L.K. White City Engineer
 W. B. Carter 1950
 Project No. C 20-19
 Book # M-6

5-27

