


TWENTIETH ST.

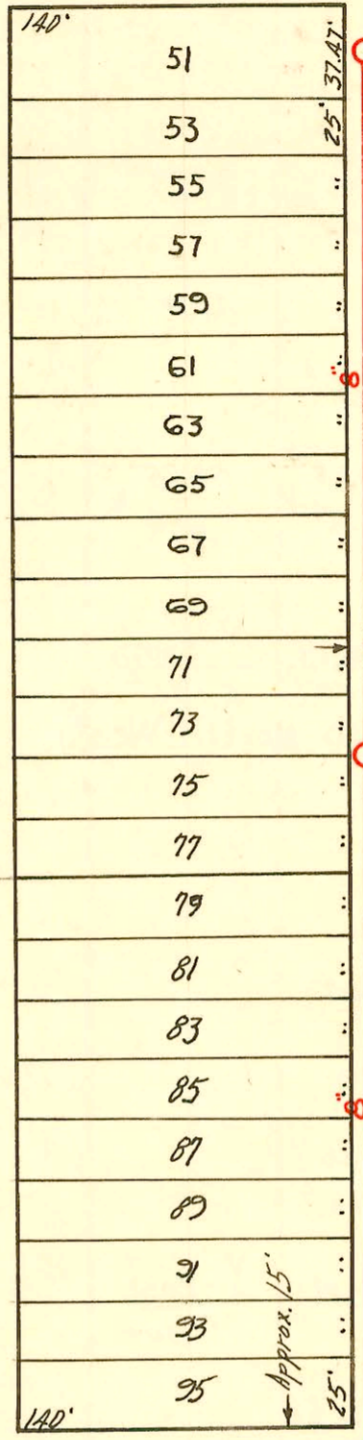

5+79.6 M.H.

AVE.

N

1"=80'

2+88.7 MH.

PENNSYLVANIA

0+00 New Manhole on existing Line.

NINETEENTH ST.

Lat. 20, Dist. T, S.S.#12  
 City of Wichita, Kansas  
 L.K. White City Engineer  
 M. K. Eby 1950  
 Project No. G 20-12  
 Book M-12

