


SERVICE RECORD

CONSTRUCTION RECORD

DATE OF SERVICE		DESCRIPTION OF SERVICE		DATE OF CONSTRUCTION		DESCRIPTION OF CONSTRUCTION	
START	STOP	BY	REASON	START	STOP	BY	REASON

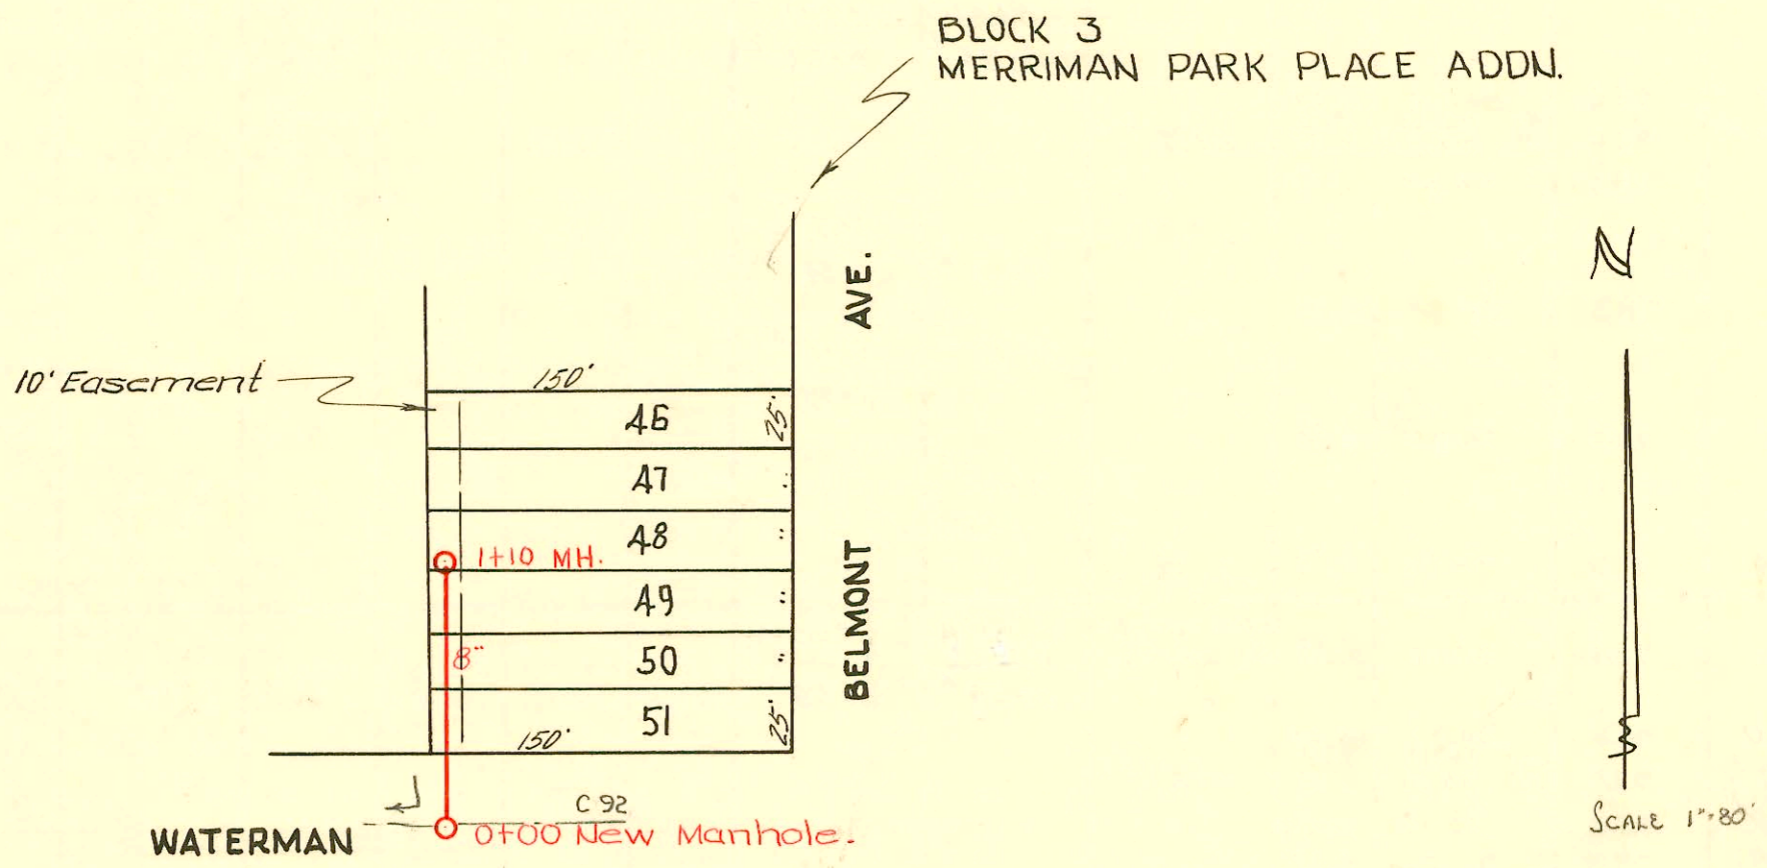

LAT. 30. DIST. A, S.S. # 12
 CITY OF WICHITA, KANSAS
 L. K. WHITE CITY ENGINEER
 UTILITY CONTRACTORS INC
 AUG. 1950, PROJ. NO. C 20-36
Book # M-4

