

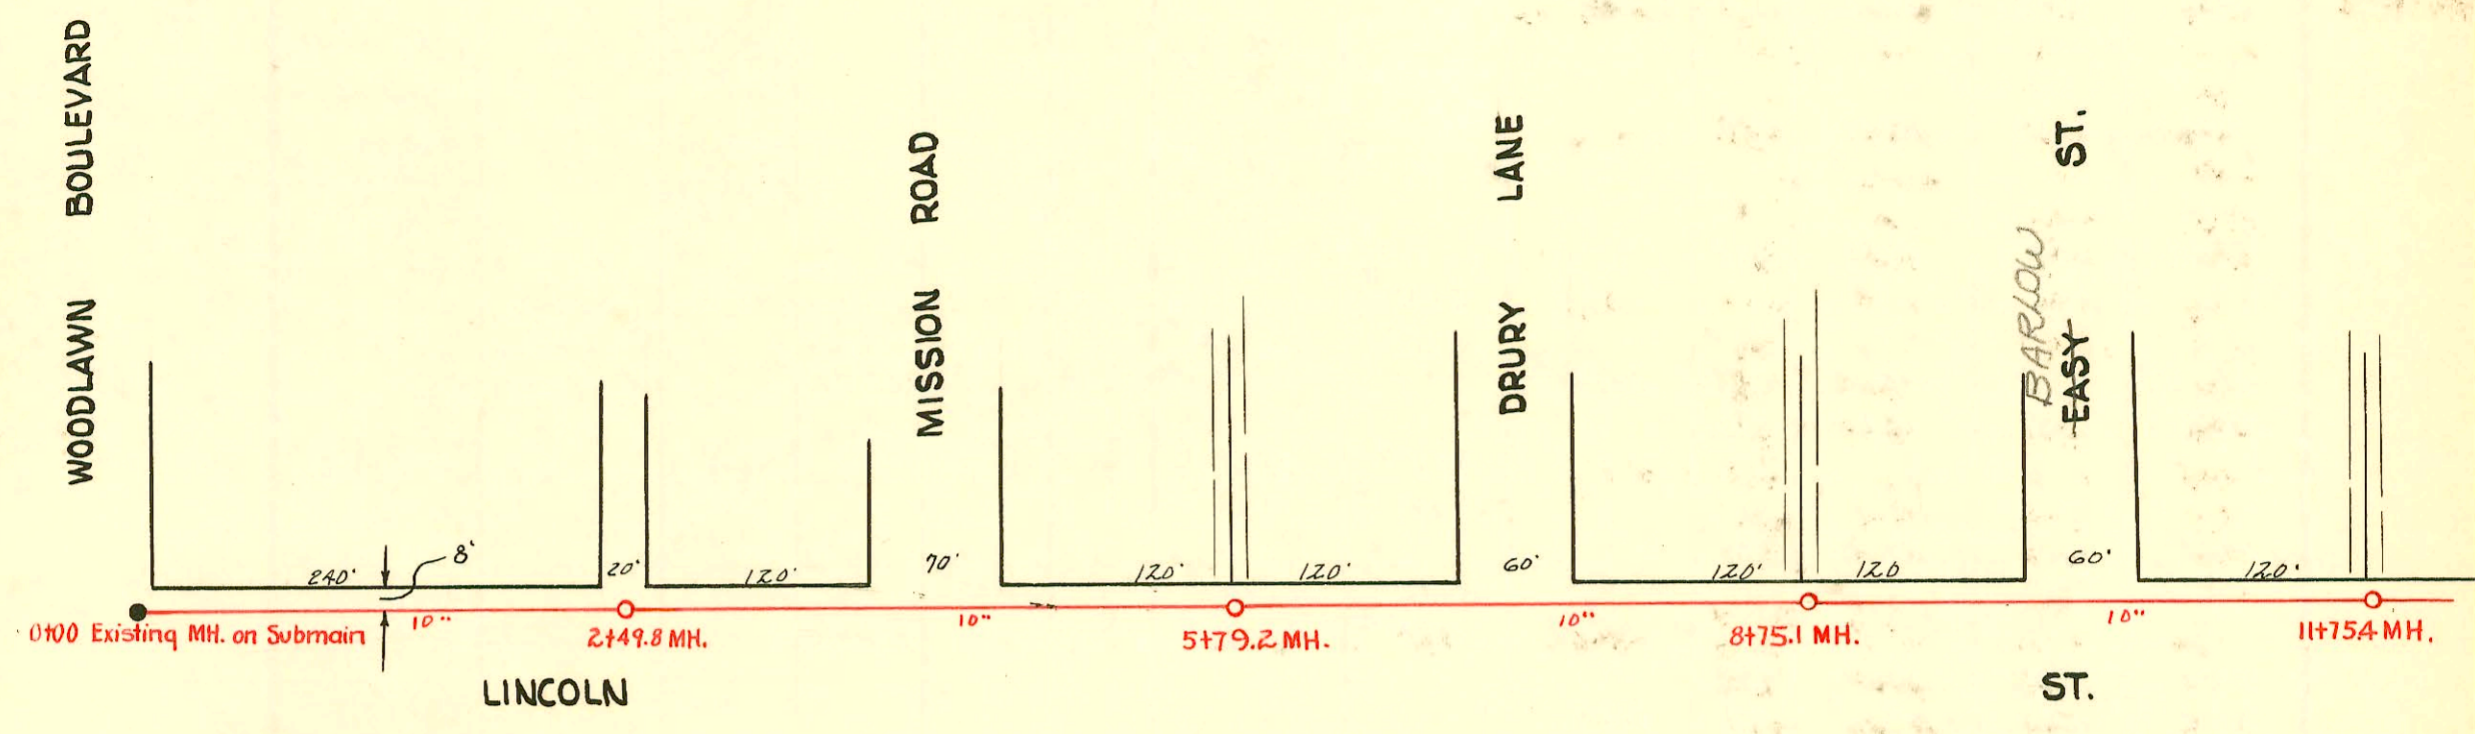


CONSTRUCTION RECORD SERVICE RECORD

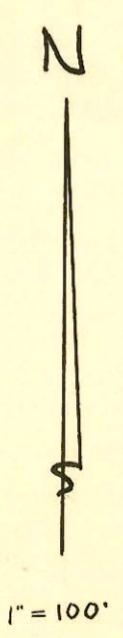

LINE NO. 1

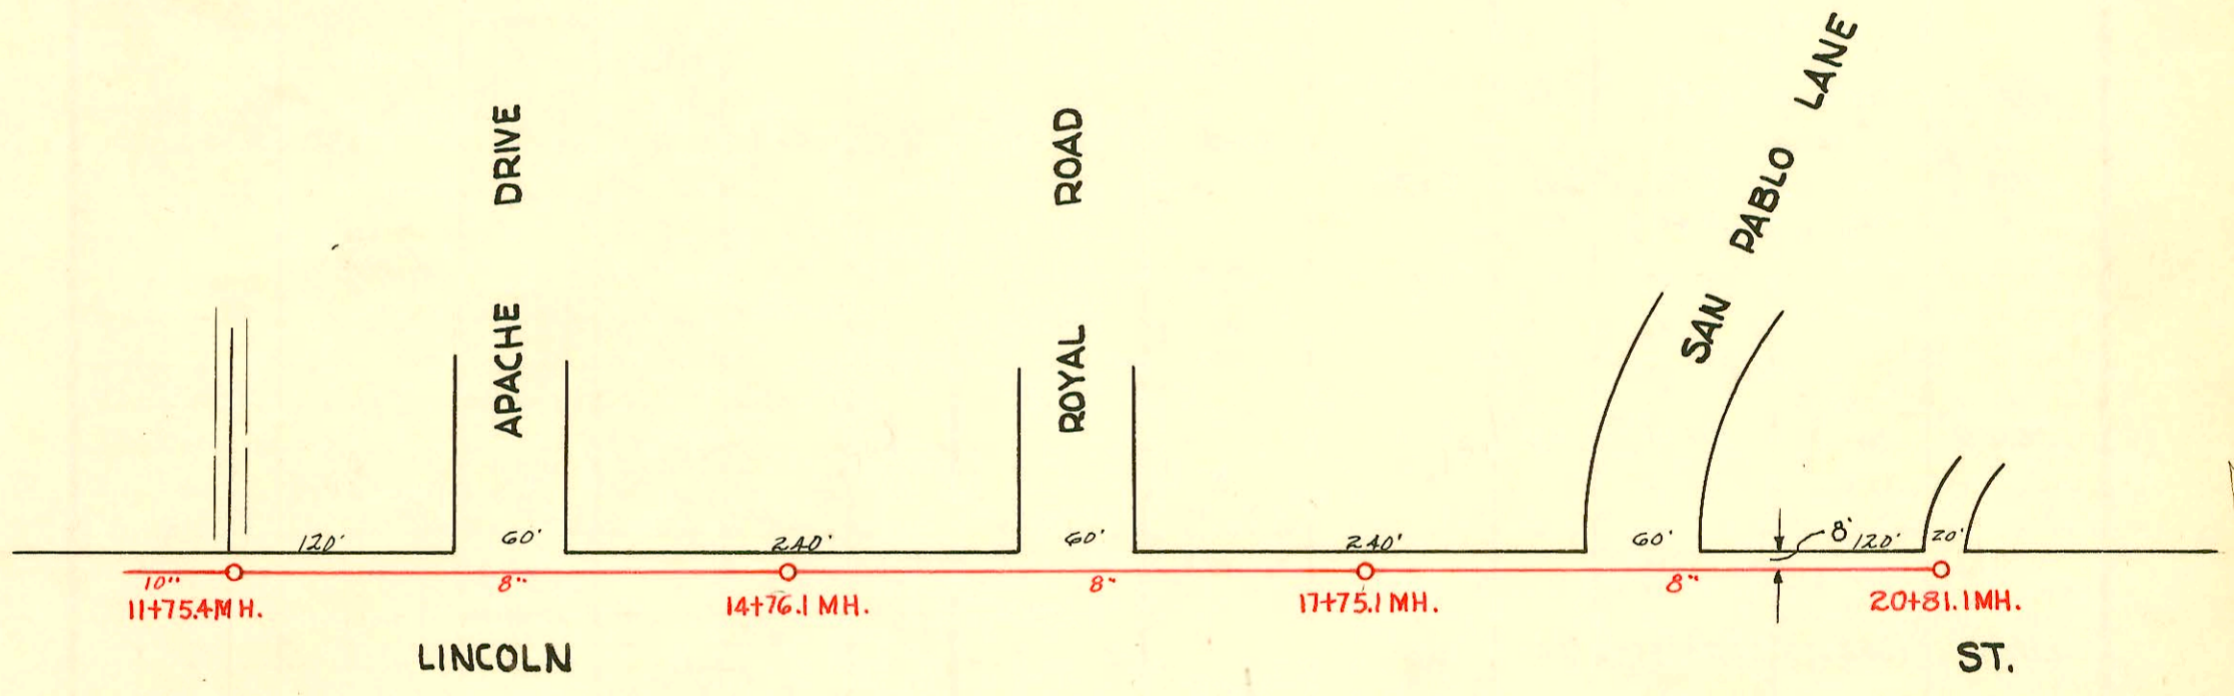

LAT. 1, DIST. 3, WAR INDUSTRY SEWER  
 IN EASTRIDGE ADDITION  
 CITY OF WICHITA, KANSAS  
 L.K. WHITE CITY ENGINEER  
 W.B. CARTER CONTRACTOR  
 SEPT. 1950, PROJ. NO. C20-2  
 BOOK M-10

NOTE: This sewer project is booked on pages 235, 236, 237, 238, 240, 241, 242, 246, 247 and 248.

