242 A

WAR INDUSTRIES S.S.

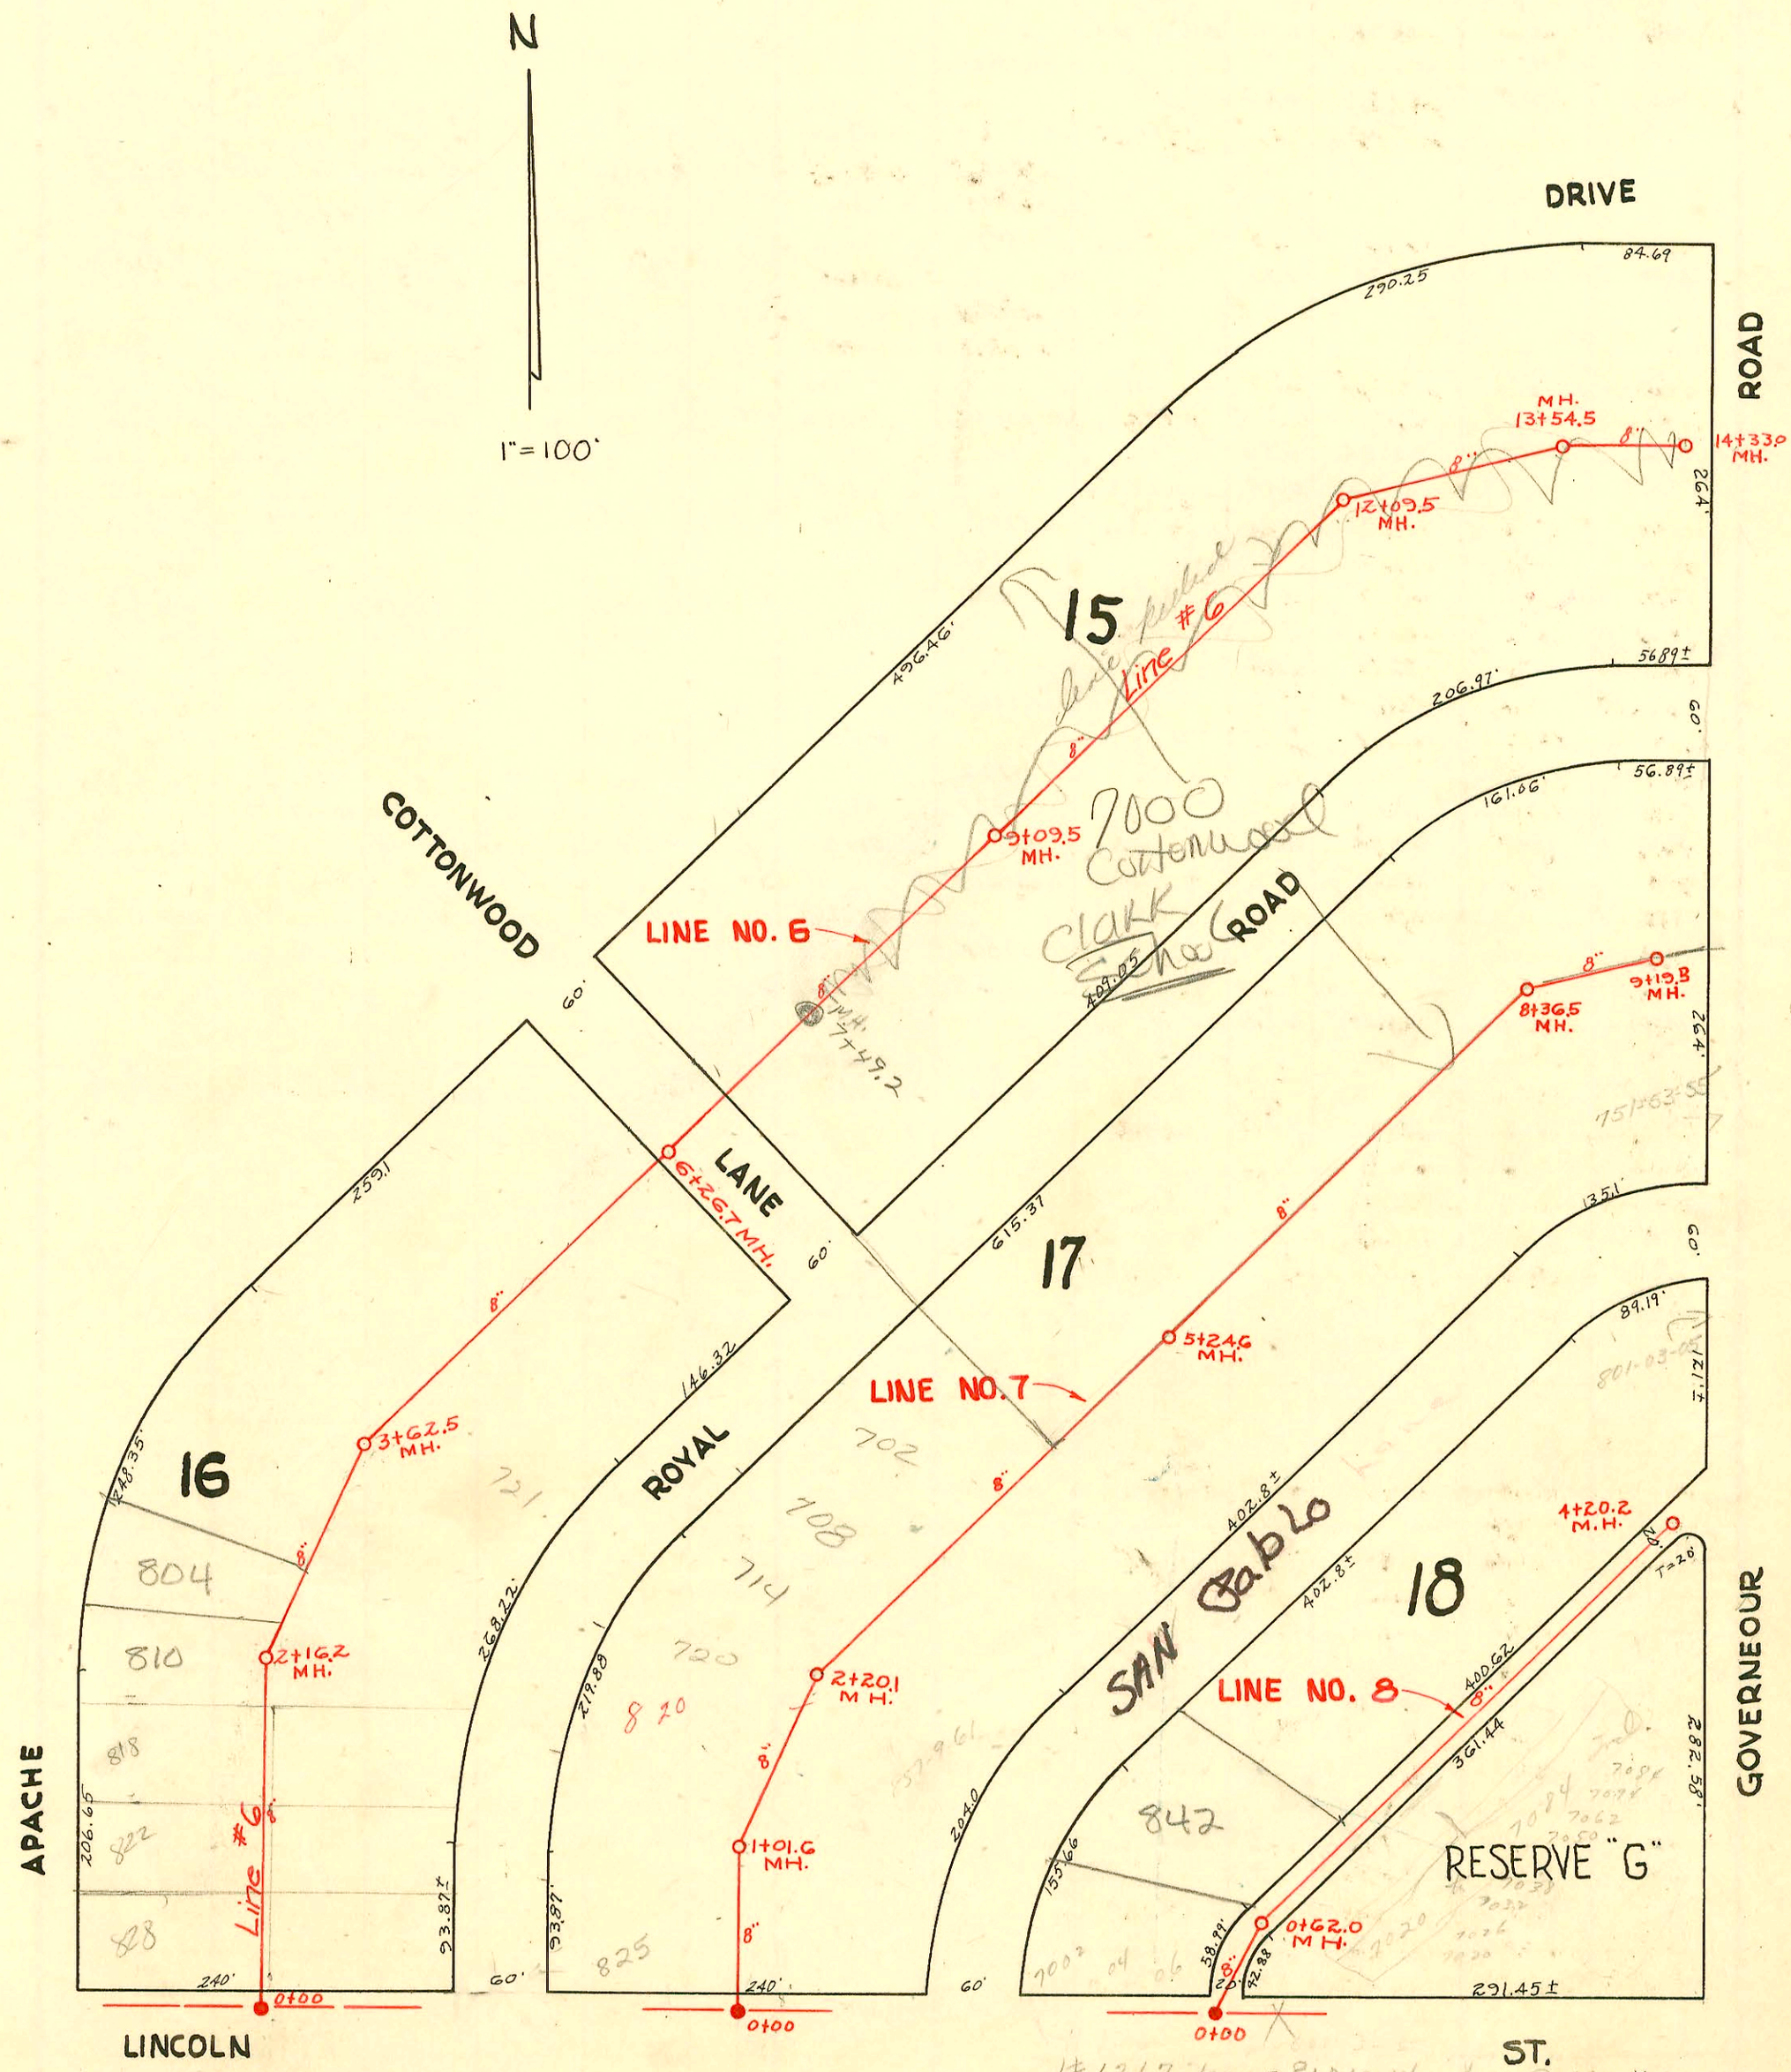

#5511 - 815 San Pablo
#5510 - 829 San Pablo
#5509 - 835 San Pablo
#5508 - 6920 E Lincoln
} Wichita Plbg Co 6-10-53

#5536 - 823 San Pablo - 6-11-53 - Wichita Plbg.

(53+55) #1236 - 78 Governeour - 6-21-53 (9+05.1) Wichita Plbg.
#1235 - 805 San Pablo - 6-21-53
Sup #1266 - 801-03-05 R Governeour 6-23-54 - Wichita Plbg
4"ABS 40 5-23-94 (wye 4+09.2) 4"ABS40 Repl all but lower 2'

2004-00178 842 San Pablo 1/20/04 AE Henning - replace entire line 4"PVC tied to clay 5' S of mH 0+62 (0+57)

#1267 - Sup - 810-12-14 San Pablo - Wichita Plbg 6-23-54
#1268 - Sup - 818-20-22 San Pablo - Wichita Plbg. Co 6-23-54
#1269 - Sup - 824-26-28 San Pablo - Wichita Plbg Co 6-23-54
#1270 - Sup - 830-32-34 San Pablo - Wichita Plbg Co - 6-23-54
#1271 - Sup - 836-38-40 San Pablo - Wichita Plbg Co - 6-23-54 R (67' N of mH) 10-16-90
#1272 - Sup 842-44-46 San Pablo - Wichita Plbg 6-23-54
#1273 - Sup 7002-04-06 E Lincoln - Wichita Plbg 6-23-54
R see arrow
R

2004-00177 1/20/04 - 7002 Lincoln AE Henning - 4"PVC pipe - no fittings full replacement, tied to clay tile tap is apx 15' S of mH 0+62 (0+47)

Sup #2175 - 701 Royal
Sup #2176 - 709 Royal
Sup #2177 - 715 Royal
Sup #2178 - 721 Royal
97-B2617 - Sup #2179 - R 803 Royal
Sup #2180 - 809 Royal
2001-01960 Sup #2181 - 817 Royal - 8/9/01 - Reddi 4"SCH40 1 Twin Co, 2 Fernco
} Wichita Plbg Co 8-15-82 8547

Sup #2182 - 821 Royal (0+94)
Sup #2183 - 825 Royal
Sup #2184 - 702 Royal
Sup #2185 - 708 Royal
Sup #2186 - 714 Royal 113-2001
Sup #2187 - 720 Royal Repair (1+79.5)
Sup #2188 - 802 Royal
Sup #2189 - 808 Royal (9+39.1)
Sup #2190 - 814 Royal
Sup #2191 - 820 Royal
} Wichita Plg Co 6-9-53

tap #5499 - 867 San Pablo Lane
tap #5500 - 861 San Pablo Lane
tap #5501 - 855 San Pablo Lane
tap #5502 - 847 San Pablo Lane
tap #5503 - 841 San Pablo Lane
R/ 5549 Lincoln

The Wichita Eagle Press—76405

	CONSTRUCTION RECORD						SERVICE RECORD					
	STATION	ELEVATION		Depth	MANHOLE	4-INCH "Y" BRANCHES		No. of Permit		House Number		DATE OF PERMITS	
		Ground	Grade			North ~~West~~	South ~~East~~	North West	South East	North West	South East	North West	South East
Line #5	Contined	from	page 241										
	17+00	158.1	149.25	8.85									
	17+36.4	157.8	149.35	8.45	17+36.4								
						17+42.8	17+45.8	#5221	#6143	614 Barlow	609 apache	7-10-51	10-16-51
						+84.0		#5222		610 Barlow		7-10-51	
	18+00	155.3	149.55	5.75			4" SDR 35 18+15.4		94-11219-7 #6144		605 R apache		7-18-94 10-16-51
						18+32.6		#5223		606 Barlow		7-10-51	
						18+97.3	19+00.3	#5224	#645	602 Barlow	601 apache	7-10-51	10-16-51
	19+00	153.8	148.85	4.95									
	19+46.1	154.2	149.98	4.22	19+46.1								
LINE NO. 6	0+00	158.2	145.69	12.51	0+00 = 14+75 in Line # 1								
	1+00	158.1	145.97	12.13									
	2+00	158.4	146.27	12.13									
	2+16.2	158.5	146.32	12.13	2+16.2	WYE- CITY rep 2+39.2	6" Predco	2003-02509		804 Apache		9-26-03	
	3+00	158.9	146.57	12.33									
	3+62.5	159.6	146.76	12.84	3+62.5								
	4+00	159.9	146.87	13.03									
	5+00	160.9	147.17	13.73									
	6+00	161.8	147.47	14.33									
	6+26.7	161.7	147.55	14.15	6+26.7								
	7+00	161.9	147.77	14.13	7+49.2	6+61.5		C54853		7000 Cottonwood (School)		4-11-76	
	8+00	162.1	148.07	14.03									
	9+00	162.0	148.37	13.63									
	9+09.5	161.8	148.40	13.40	9+09.5								
	10+00	161.6	148.67	12.93									
	11+00	159.7	148.97	10.73									
	12+00	157.7	149.27	8.43									
	12+09.5	157.8	149.30	8.50	12+09.5								
	13+00	156.1	149.57	6.53									
	13+54.5	155.3	149.74	5.56	13+54.5								
	14+00	154.3	149.87	4.43									
	14+33.0	154.6	149.97	4.63	14+33.0								
LINE NO. 7	0+00	159.5	148.92	10.58	0+00 = 17+75.1 in line # 1								
	1+00	159.6											
	1+01.6	159.6	149.31	10.29	1+01.6				10531		857-9-61 R Sec Table		3-28-84
	2+00	159.8	149.70	10.10									
	2+20.1	159.9	149.78	10.12	2+20.1								
	3+00	160.3	150.10	10.20									
	4+00	160.9	150.50	10.40									
	5+00	161.2	150.90	10.30				2003 02351		7000 Cottonwood	(Bldg Addl)	9-9-03	
	5+24.6	161.3	151.00	10.30	5+24.6								
	6+00	161.8	151.30	10.50									
	7+00	161.8	151.70	10.10									
	8+00	160.2	152.10	8.10									
	8+36.5	159.5	152.24	7.26	8+36.5								
	9+00	157.7	152.50	5.20									
	9+19.3	157.2	152.58	4.62	9+19.3								
LINE NO. 8	0+00	158.5	150.22	8.28	0+00 = 20+81.1 in line # 1								
	0+62.0	159.2	150.45	8.75	0+62.0								
	1+00	159.6	150.60	9.00									
	2+00	160.2	151.00	9.20									
	3+00	160.9	151.40	9.50									
	4+00	161.2	151.80	9.40				#2357	Dup.	(2+21.5)	7000 block E. Lincoln		11-19-64
	4+20.2	161.0	151.88	9.12	4+20.2		End	#C3046	(2+21.5)	7090 E. Lincoln		5-11-67 - Robert McElroy	

City wye repair 6" Predco 23' N of 2+16.2 (2+39.2) TWINCO, 1122-411470 PVC
Wichita Exc - Pipeburst repl 4" PESDR17

Dup - #6302 - 704 Apache (5+77.2) Wichita Plbg Co. 10-31-51
Dup - #6303 - 710 Apache
Dup - #6304 - 716 Apache
Dup - #6305 - 720 Apache Dup (3+85.2)
Dup - #6306 - 726 Apache Dup (3+38.1)
Dup - #6307 - 732 Apache (3+15.6) repair
Dup - #6308 - 738 Apache

Dup - #6309 - 804 Apache R see above Wichita Plbg Co. 10-31-51
Dup - #6310 - 810 Apache
Dup - #6311 - 818 Apache
Dup - #6312 - 822 Apache 12-18-84B 0+90.0
Dup - #6313 - 828 Apache

#3194 - tap in Commercial - 8-14-52 Ray Nixon Plg Co. - 7000 Cottonwood