



RECORD RECORDED

0100 Exist'g MH. 10' W. & 4' S. of S.E. cor. 18th & Hyd.

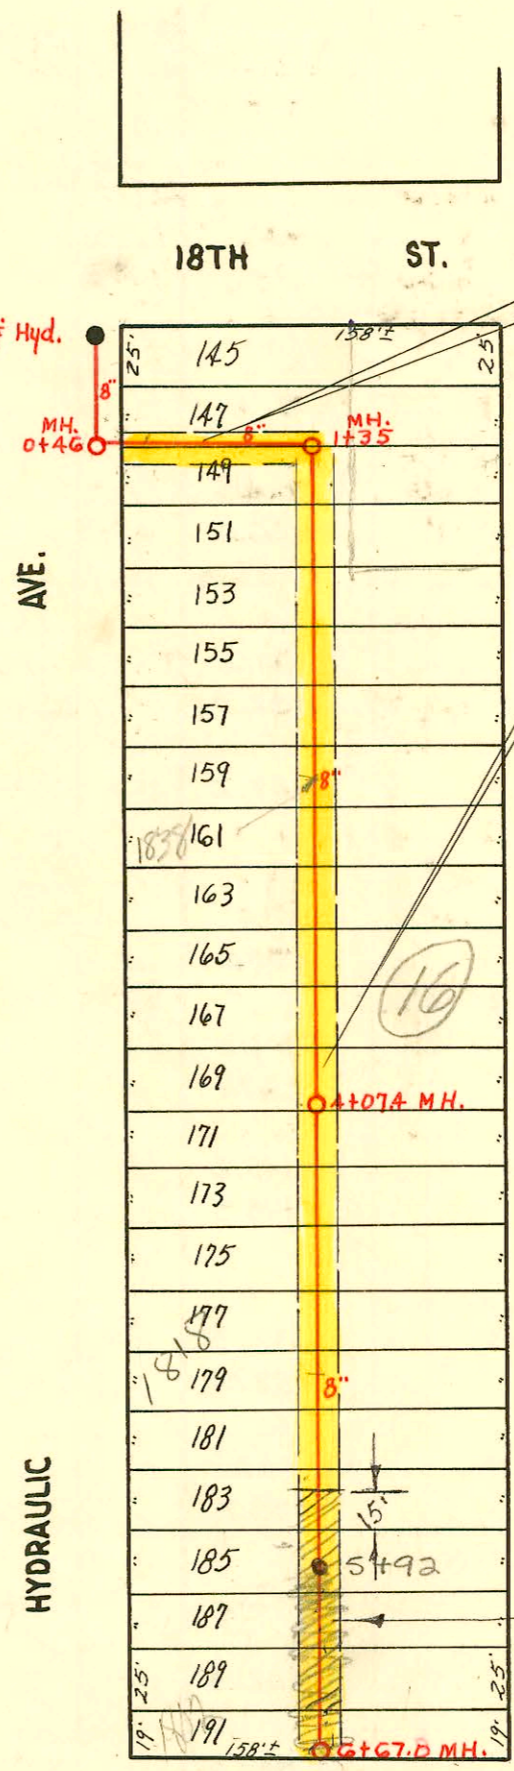

EASEMENT #2444
 Dated Sept. 8, 1950. From James E. Farmer and Gertrude M. Farmer.
 A twelve (12) foot permanent right-of-way described as follows:
 The South six (6) feet of the west seventy-nine (79) feet of Lot 147
 and the north six (6) feet of the west seventy-nine (79) feet of Lot
 149, on Hydraulic Ave. Pennsylvania Addn. to the City of Wichita, Sedgwick
 County, Kansas.

EASEMENT #2440, Dated August 4, 1950. From James E. Farmer
 and Gertrude M. Farmer.
 The west sixteen (16) feet of the east eighty-seven (87) feet of
 Lots 149 to 191, odd inclusive, on Hydraulic Avenue, Pennsylvania
 Addition to the City of Wichita, Sedgwick County, Kansas.

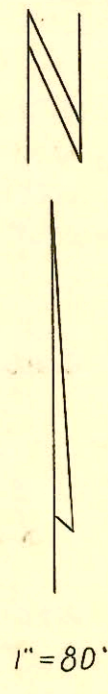

Note:
 Easement Vacated
 across 315' of Lot
 183 & Co. across Lots
 185, 187 & 189, Blk 16
 Pennsylvania Addn.

This MH Abandoned
 New M.H. Constructed
 @ Sta 5+92.2
 Use MH # 4+07.0 for
 permits

LAT. 24, DIST. T, S. S. NO. 12
 CITY OF WICHITA, KANSAS
 L.K. WHITE CITY ENGINEER
 W.B. CARTER CONTRACTOR
 OCT. 1950, PROJ. NO. C20-31
 Book # M-7

CONSTRUCTION RECORD							SERVICE RECORD					
STATION	ELEVATION		Depth	MANHOLE	4-INCH "Y" BRANCHES		No. of Permit		House Number		DATE OF PERMITS	
	Ground	Grade			North West	South East	North West	South East	North West	South East	North West	South East
0+00	122.3	116.08	6.22									
0+46	122.2	116.13 out 116.33 in	6.07 5.87	0+46								
1+00	122.0	116.38	5.62									
1+35.0	122.0	116.42 out 116.62 in	5.58 5.38	1+35.0	1+31.0 Y WEST	Y EAST	#3278		17018 Hyd		12-4-50	
					1+58.1	1+46	#3277		18507 Hyd		12-4-50	
						1+69 +95	#879		18517 Kansas			5-10-54
2+00	121.9	116.68	5.22									
					2+20.3	2+17.3	#2923		18467 Hydraulic		11-1-50	
					+47.7	+44.7	#4740		18427 Hydraulic		4-7-53	
					+71.2	+68.2	#6833		18387 Hydraulic		4-15-52	
					+99.1	+96.1	5725		18337 Hydraulic		4-26-52	
3+00	121.4	116.78	4.62									
					3+20.9	3+17.9			18327 Hydraulic		4-7-53	
					+48.4	+45.4	#4739					
					+69.6	+66.6	#4738		18287 Hydraulic		4-7-53	
					+98.0	+95.1						
4+00	121.2	116.88	4.32									
	121.0	116.89	4.11	4+07.4	4+22.6	4+19.6			18227 Hydraulic		4-9-53	
					+41.5	+38.5	#4737					
					+72.9		2001-02101 2000-02480		18187 Hydraulic		11-14-00	8/22/01
					+94.0	4+91.0	#4736		Below		4-7-53	
5+00	120.8	116.98	3.82									
					5+21.5	5+18.5			18127 Hydraulic		4-7-53	
					+49.5	+46.5	#4735					
					+74.0	+71.0						
					+98.9	+95.9						
6+00	120.3	117.08	3.22	5+92 (6" stub so)			9011		18027 Hydraulic		1-12-59	
					6+23.6	6+20.6						
					+49.2	+46.2						
					+61.1	+58.1						
6+67.0	120.2	117.15	3.05	6+67.0								

2001-02101-8/22/01-1818 N Hydraulic - Royal Pkg. - Soil Pipe Extension - ITWIN CO, 1H22, 2H45 SCH40 PVC