7A

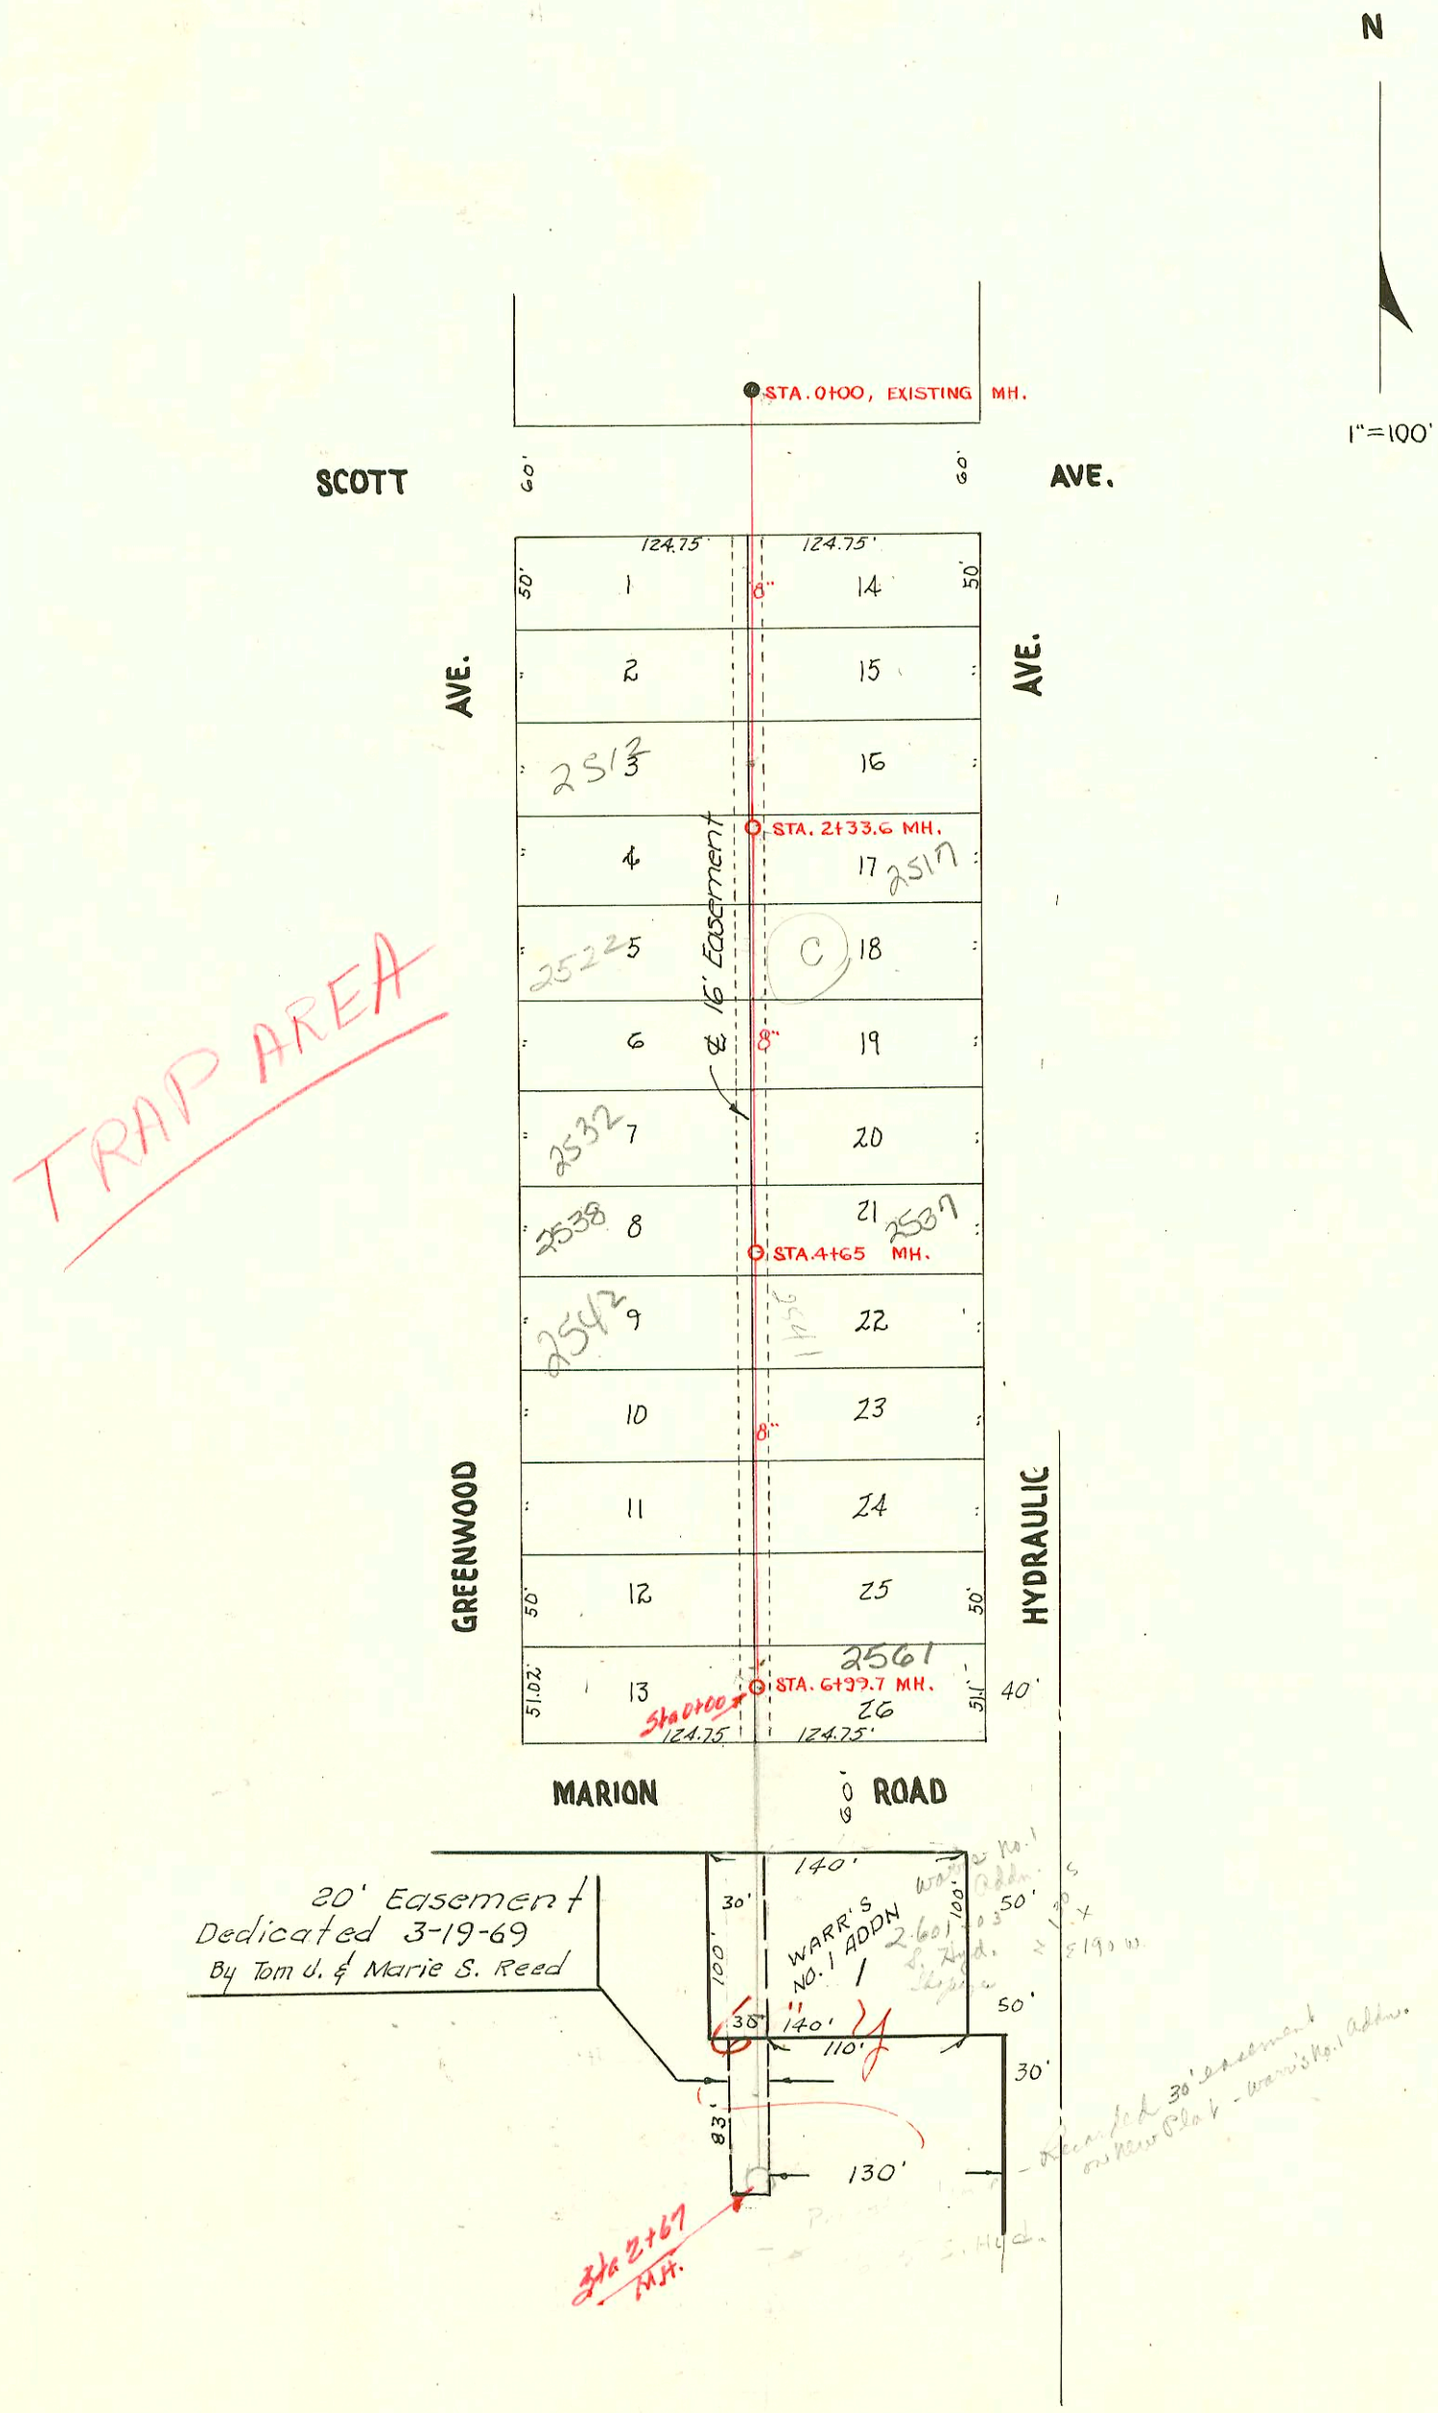

LAT. 18, DIST. B, S. S. NO. 20
CITY OF WICHITA, KANS.
L. K. WHITE CITY ENGINEER
W. B. CARTER — CONTRACTOR
Booked May, 2, 1951
Book M-7, Proj. No. C21-1

7

Form 41-(54) 3-51

CONSTRUCTION RECORD / SERVICE RECORD

STATION	ELEVATION Ground	ELEVATION Grade	Depth	MANHOLE	4-INCH "Y" BRANCHES ~~North~~ West	4-INCH "Y" BRANCHES ~~South~~ East	No. of Permit North West	No. of Permit South East	House Number North West	House Number South East	DATE OF PERMITS North West	DATE OF PERMITS South East
0+00	97.20	89.40	7.80	0+00 Exist'g MH.								
					0+97.0	0+94.0	#4532	#4518	2502 S. Greenwood	2501 S. Hydraulic	5-3-51	5-3-51
1+00	97.15	89.50	7.65									
					1+49.2	1+46.2	#4533	#4519	2508 Greenwood	2507 S. Hydraulic	5-3-51	5-3-51
					1+97.0	+94.0	#4534	#4520	2512 Greenwood	2511 S. Hydraulic	5-3-51	5-3-51
2+00	97.43	89.60	7.83									
2+33.6	97.25	89.63	7.62	2+33.6								
					2+45.8	2+42.8	#4535	#4521	2518 Greenwood	2517 S. Hydraulic	5-3-51	5-3-51
					+94.0	+91	#4536	#4522	2522 Greenwood	2521 S. Hydraulic	5-3-51	5-3-51
3+00	97.09	89.70	7.39									
					4"SCH40 3+43.0	3+40.0	2000-01469 #4537	#4523	2528 R Greenwood	2527 S. Hydraulic	6-20-00 5-3-51	5-3-51
					3+94.5	+91.5	#4538	#4525	2532 Greenwood	2531 S. Hydraulic	5-3-51	5-3-51
4+00	97.24	89.80	7.44									
					4"SCH40 -CO 4+45.5	4+42.5	2000-00557 #4539	#4526	2538 R Greenwood	2537 S. Hydraulic	3-1-00 5-3-51	5-3-51
4+65.0	96.75	89.87	6.88	4+65.0								
					4+93.9	4+90.9	#2002-03197 #4542	6788 #4527	2542 R Greenwood	see Below 2541 S. R Hydraulic	11-25-62 5-3-51	10-14-82 5-3-51
5+00	96.47	89.90	6.57									
					5+44.3	5+41.3	#4543	#4528	2548 Greenwood	2547 S. R Hydraulic	5-3-51	5-3-51
					+94.0	+91.0	#4544	#4529	2552 Greenwood	2551 S. R Hydraulic	5-3-51	5-3-51
6+00	96.01	90.00	6.01									
					6+43.0	6+40.0	#4545	#4530	2558 Greenwood	2557 S. Hydraulic	5-3-51	5-3-51
					6+92.2 of 4"PVC-CO	+89.2	#91-39318 #4546	#4531 2003-81862	2562 R Greenwood	2561 S. R Hydraulic	12-20-91 5-3-51	7-17-03 5-3-51
6+99.7	95.25	90.10	5.15	6+99.7 = 0+00 Line Ext. South								
1+00						6+87.3 = trap		#C14964 15488		2601 S. 03 So. Hydraulic		7-16-69 1-10-86
2+00												
				2+67.9								

Priv. line connion 8" line so. from 6+99.7 m.H.
Recorded ~~[illegible]~~ on New Plat - Wann's No. 1 Addn.

2002-03197-11/25/62-2542 Greenwood - A Good Plbr - 4" PVC, 1 TWINCO, 24/45, New house trap, tied to clay tile

SWR 2000-01392 6-9-00 2623 S Hydraulic (House) - A E Hennis
(Refer to Book F. 223 for Reconnect.

#5513 to #5539, inc + #5541 to #5583, inc
70 trailers connected to private line
2635 S. Hydraulic 8-13-51

#5809 + #5810 - 2635 S. Hydraulic - 9-14-51
Trailer - Private Line - Eugene Reynolds