


N
SCALE: 1" = 100'

G 58
0+00 EXISTING M.H. 74A



LAT. X, DIST. T, S.S. #20
CITY OF WICHITA, KANS.
L.K. WHITE - CITY ENGINEER
UTILITY CONTRACTORS, INC.
BOOKED JULY 1, 1952
BK. J.H.T. 56 PROJ. C22-14

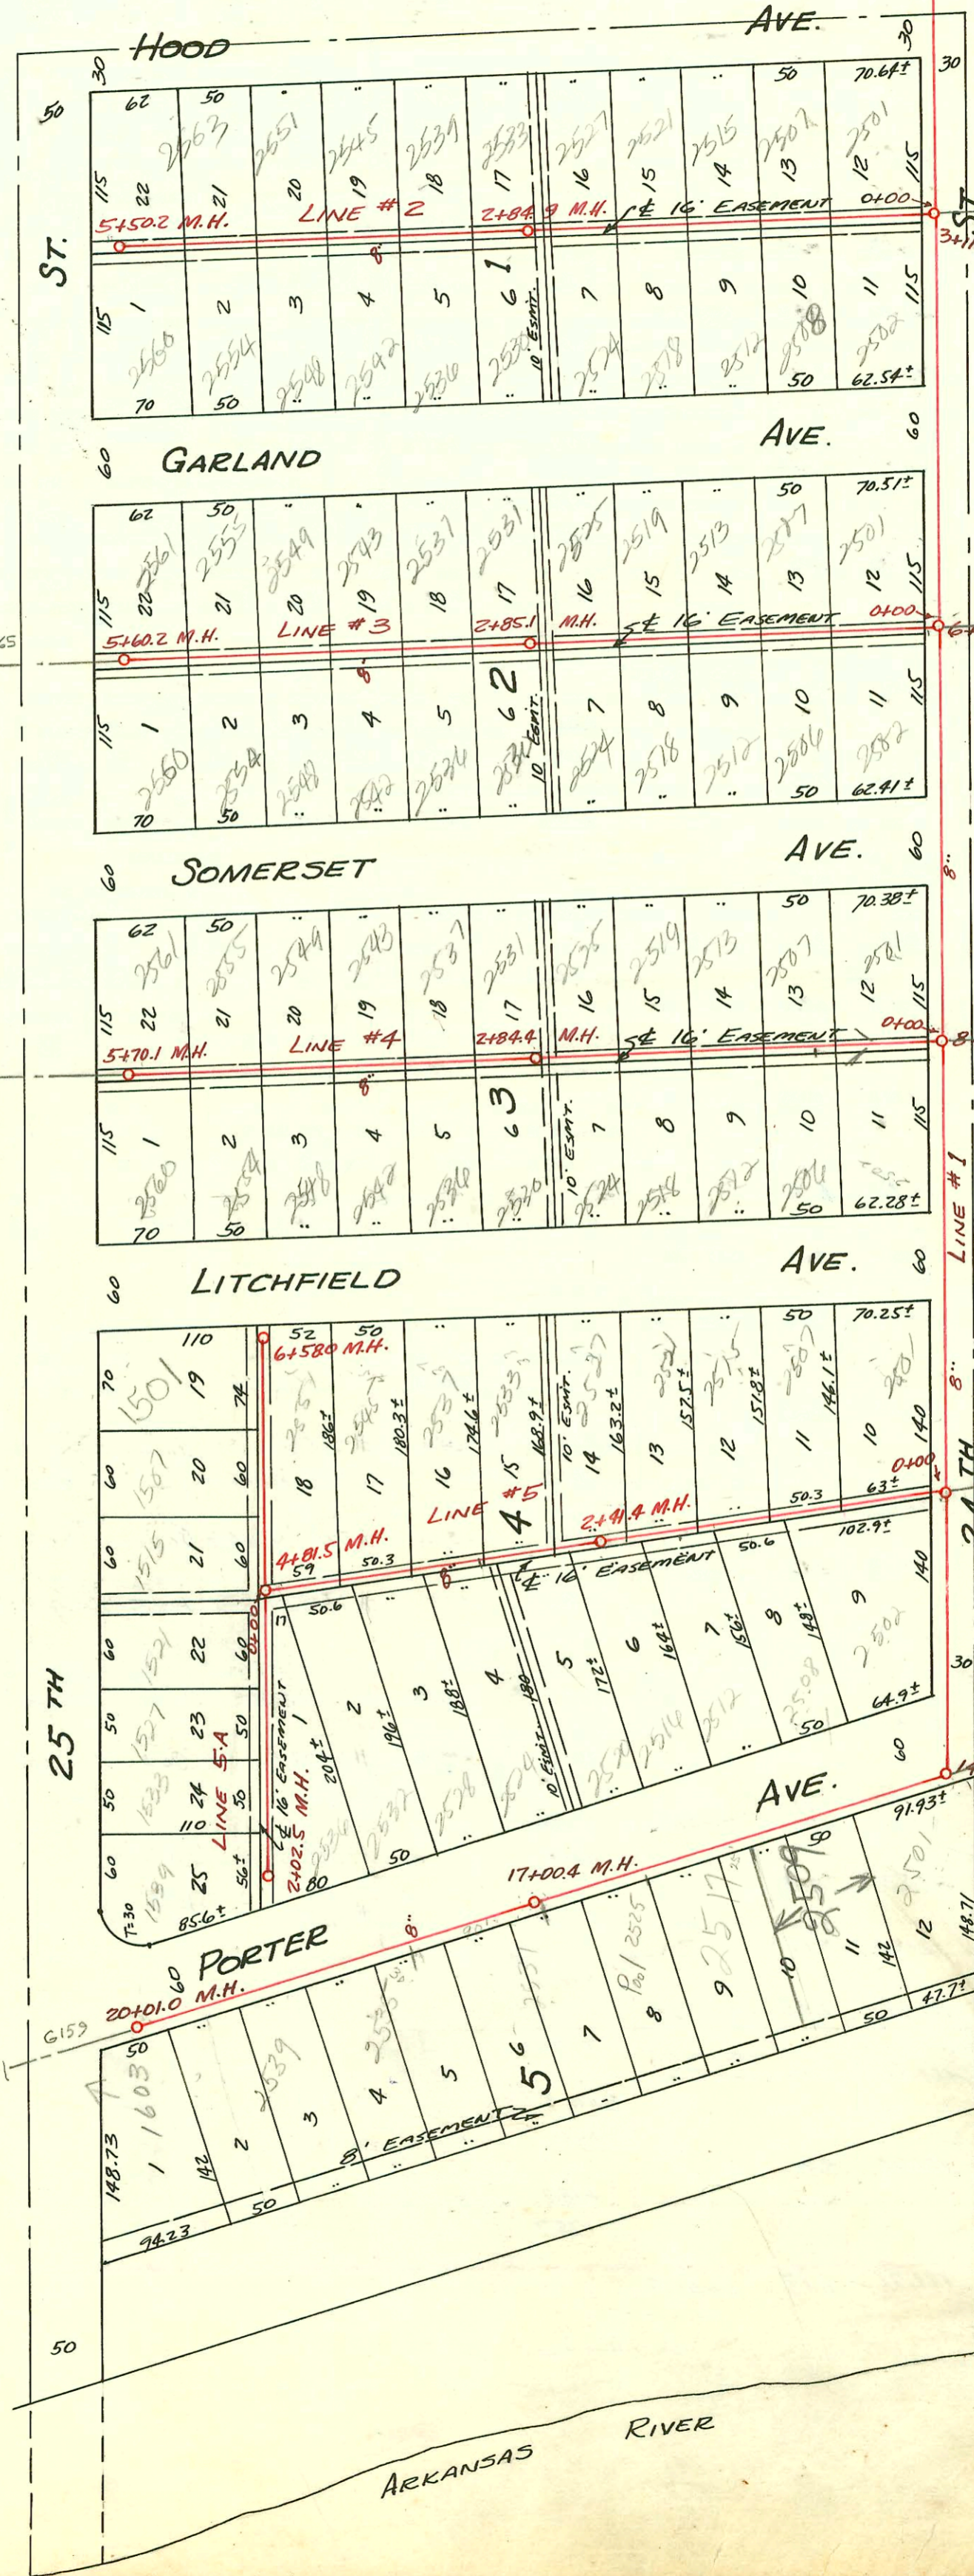