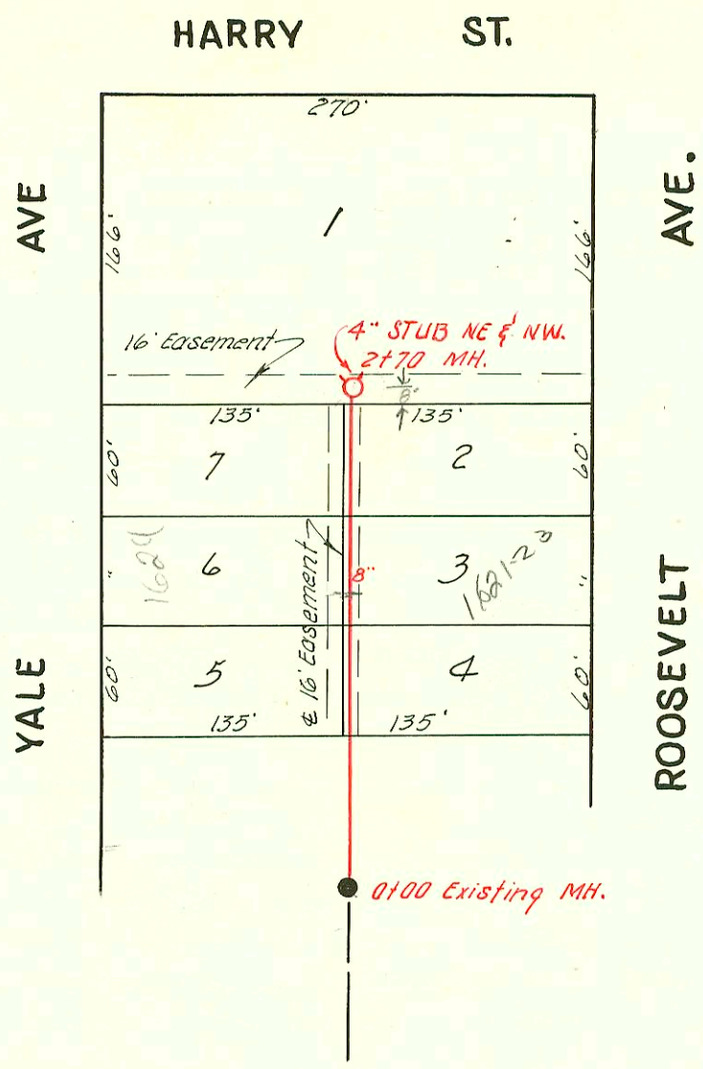

4" wyes

LAT. 15, SUB. W, S. S. #12

W. B. CARTER JULY 3, 1953

Book J.H.K. Misc. PROJ. NO. C23-21

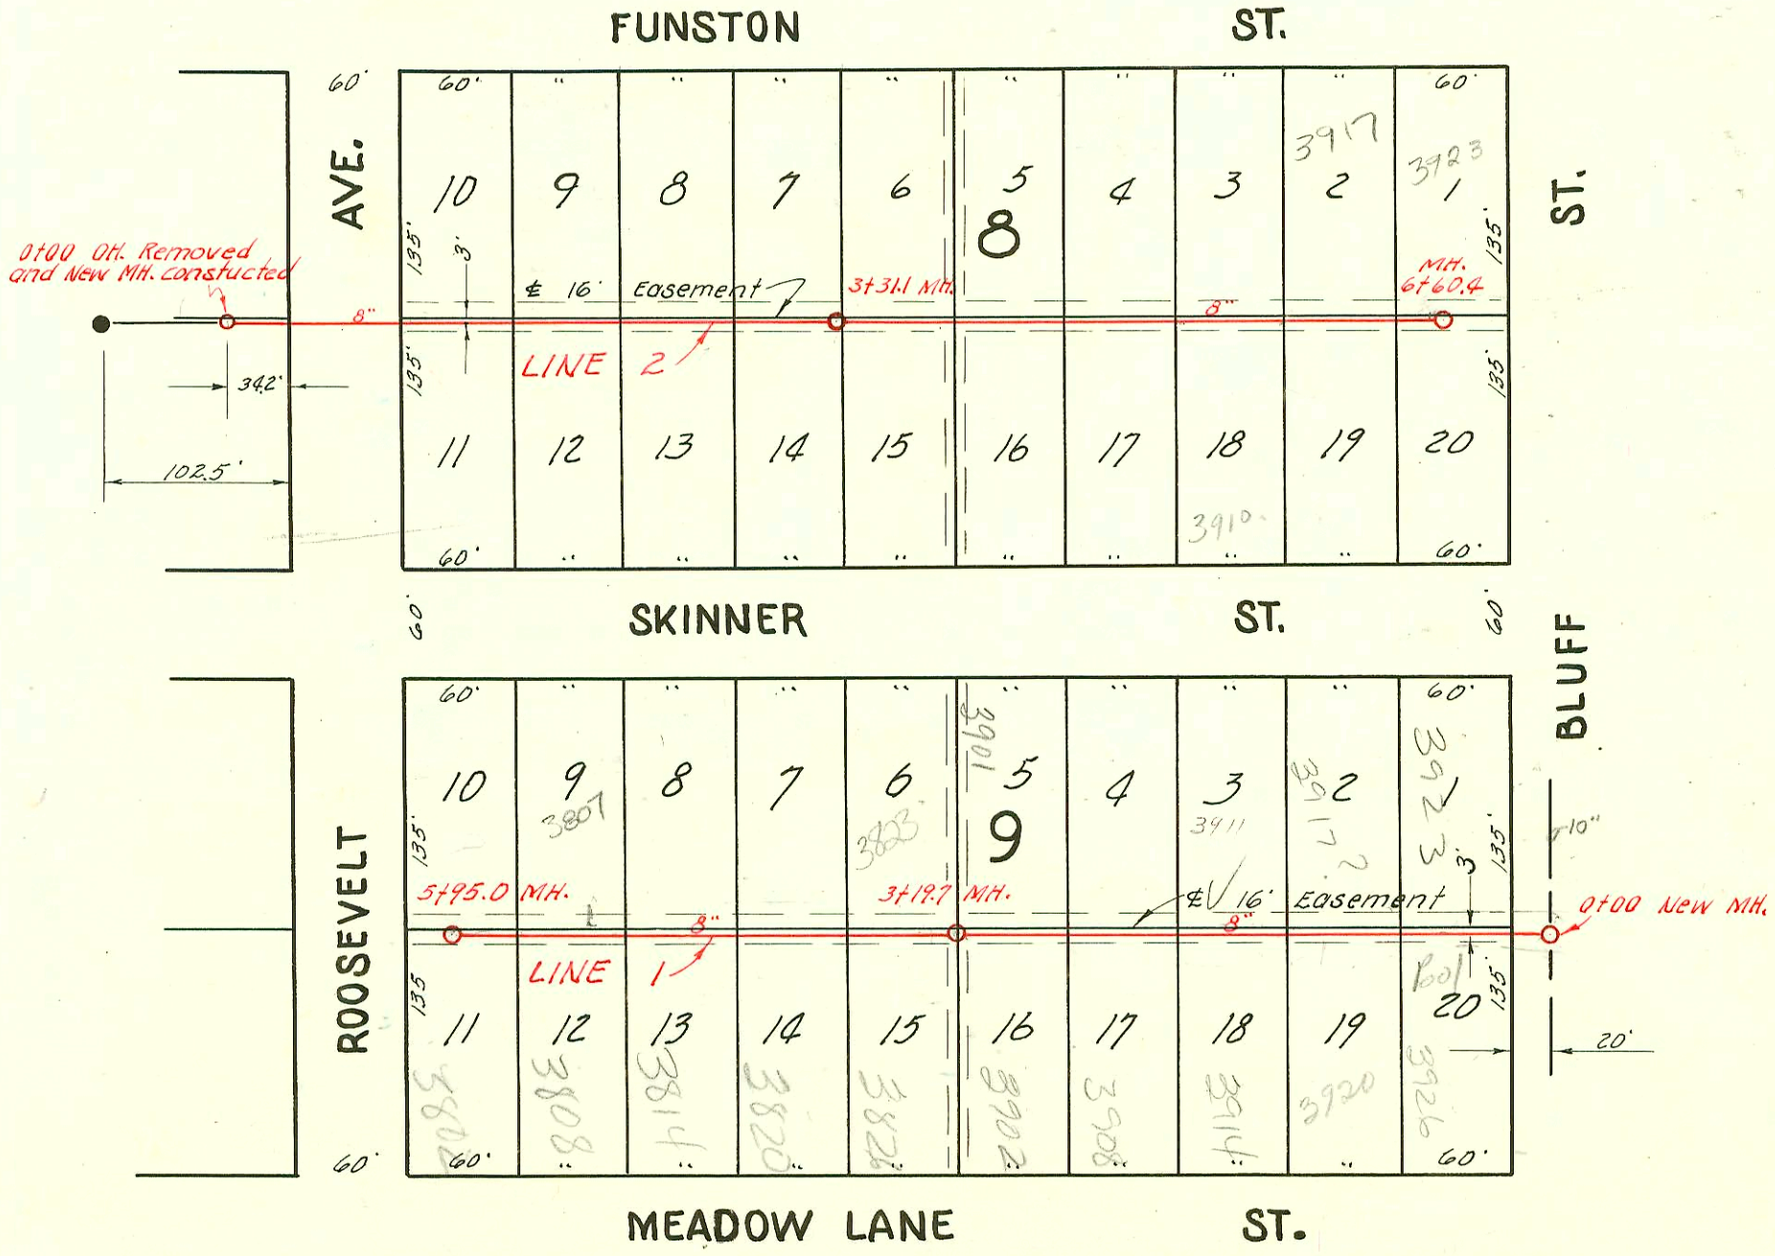

MT. VERNON

LAT. 28, D.C.S. #2, S.S. #12

W. B. CARTER — MARCH. 1953

BK. Nº JT. 56 — PROJ. NO. C 22-96

Form 41-(54) 3-51

LINE NO.	STATION	ELEVATION Ground	ELEVATION Grade	Depth	MANHOLE	4-INCH "Y" BRANCHES ~~North~~ West	4-INCH "Y" BRANCHES ~~South~~ East	No. of Permit North West	No. of Permit South East	House Number North West	House Number South East	DATE OF PERMITS North West	DATE OF PERMITS South East
	CONSTRUCTION RECORD							**SERVICE RECORD**					
3 Continued	6+0												
					6+85	50' 38' N of 7+38 SPL		12810 7767		682 S. Byrd		4-14-95 8-16-54	
	7+0						7+50		#4780		601 Beech		4-10-53
							+77						
						7+83		4095		604 Byrd		2-11-53	
	8+0						8+12						
						8+28		#5196		614 Byrd		6-14-55	
						8+85		#5842		618 Byrd		7-20-53	
	9+0					9+19		#2978		626 Byrd		10-30-54	
					9+29		9+28		#3831		621 Beech		1-20-53
					9+50	9+67		#2939		628 Byrd		11-1-56	
						+79							
					29		9+91						
	10+0					10+18		#5820		630 Byrd		7-29-55	
							10+49		#920		635 Beech		9-26-54
						10+73		#4074		636 Byrd	641 + Pa'ler	2-9-53	
	11+0						11+07		#3830		Beech		1-20-53
						11+40		#4856		638 Byrd		4-16-53	
							11+55		4650		645 Beech		5-24-57
						11+70		#3693		650 Byrd		1-6-53	
	12+0						12+03		#3970		655 Beech		3-28-55
						12+33	12+36	#3692		660 Byrd		1-6-53	
					12+43								
Lot 15, Sub. W. S.S. #12						Y West	Y East						
	0+0	149.7	134.22	15.5	0+00 Exist'g MH.		0+98						
	1+0	150.7	134.62	16.1		1+01		#4096		1636 S. Yale	R	4-7-55	8-8-97
						1+60.3	1+57.3	#4078 #4097		1624 S. Yale	1621-23 R Roosevelt	4-7-55	4-7-55
	2+0	150.6	135.02	15.6		2+21.0	2+18.0	#4094		1612 S. Yale		4-7-55	
		150.5	135.29	15.2	2+70.0	(4" Stub NE & NW)		13978 #415		3735 S. Harry		6-13-85 4-54	
								12250		3701 S. Harry		2-1-60	
						4" wyes							
1.						Y North	Y South						
	0+0	136.6	126.00	10.6	0+00 New MH.	0+40.1	0+37.1	#1917 4985	#2149	3923 E. Skinner	3920 Meadowlane	11-19-80 4-28-53	8-29-56
						+94.7	+97.7	#4986	3636	3917 E. Skinner	3920 Meadowlane	4-28-53	2-1-57
	1+0	137.1	126.40	10.7		1+59.5	1+62.5	#2833 #4987	3285	3911 E. Skinner	3914 Meadowlane	3-12-81 4-28-53	12-6-56
	2+0	136.7	126.80	9.9		2+18.7	2+21.7	#4988	#1943	3907 E. Skinner	3908 Meadowlane	4-28-53	9-10-54
						+77.3	+80.3	#4989	#2076	3901 E. Skinner	3902 Meadowlane	4-28-53	9-21-54
	3+0	135.2	127.20	8.0									
		135.2	127.28	7.9	3+19.7	3+38.0	3+41.0	95-78172 #4990	#2321	3923 E. Skinner	3926 Meadowlane	5-29-95-R 4-28-53	12-21-54
						+95.8	4"40-20 +98.8		2003-01826 2322		3820 R Meadowlane		7-11-03 10-21-57
	4+0	136.0	127.60	8.4		4+59.8	4+62.8	#4992	#1159	3811 E. Skinner	3814 Meadowlane	4-28-53	6-11-54
	5+0	137.4	128.00	9.4		5+18.9	5+21.9	#4993	#41	3807 E. Skinner	3808 Meadowlane	4-28-53	2-8-54
						+84.2	+87.2	#4994	#1053	3801 E. Skinner	3802 Meadowlane	4-28-53	
		138.0	128.40	9.6	5+95.0								
2.													
	0+0	134.4	126.17	8.2	0+00 New MH.								
	1+0	137.1	126.37	10.7		1+15.8	1+12.8	#7213	#6438	3809 E. Junior	3800 E. Skinner	12-16-53	9-15-53
						+75.7	+72.7	#1059	#6439	3807 E. Junior	3806 E. Skinner	5-27-54	9-15-53
	2+0	138.0	126.57	11.4		2+37.3	2+34.3	#1058	#6440	3811 E. Junior	3810 E. Skinner	5-27-54	9-15-53
	3+0	139.2	126.77	12.4		+96.8	+93.8	#1057	#6441	3817 E. Junior	3816 E. Skinner	5-27-54	9-15-53
		139.2	126.84	12.4	3+31.1	3+59.4	3+56.4	#1056	#6442	3823 E. Junior	3822 E. Skinner	5-27-54	9-15-53
	4+0	139.7	126.97	12.7		4+15.7	4+12.7	#7489	#5826	3901 E. Junior	3900 E. Skinner	2-1-54	7-16-53
						+75.5	+72.5	#7490	#5827	3907 E. Junior	3906 E. Skinner	2-1-54	7-16-53
	5+0	138.7	127.17	11.5		5+34.4	5+31.4	#7491	#5828	3911 E. Junior	3910 E. Skinner	2-1-54	7-16-53
						+96.8	+93.8	96-81151 #7492	#5829	3917 E. Junior	3916 E. Skinner	10-29-96 2-1-54	7-16-53
	6+0	136.2	127.37	8.8		6+53.7	6+50.7	#7493	#5830	3923 E. Junior	3922 E. Skinner	2-1-54	7-16-53
		134.9	127.50	7.4	6+60.4								

2002-00138 - 1/15/02 - 633 N Beech - Royal Plbg - TWIN CO, 4" 40PVC, 1/4" fall, 2V20, tied back to claytile - NO MSMT

Dr # 13979 - 3725 E Harry - 6-12-85 - Donald Thompson - 2+70.0 4" Stub NE &

#4991 - Dup - 3819 E. Skinner - 4-28-53 - Joe McDonald

#7231 - Dup - 1635 S. Roosevelt - 12-15-53 - C. R. Leidy

#792 - Dup - 1613-15 S. Roosevelt - 4-28-54 - C. R. Leidy

3636 - Dup - 3920 Meadowlane - 2/28/57 - Leidy

24359 - 11-27-85 662 N. Byrd (Trailer) NC - Bowers Plbg -