134A

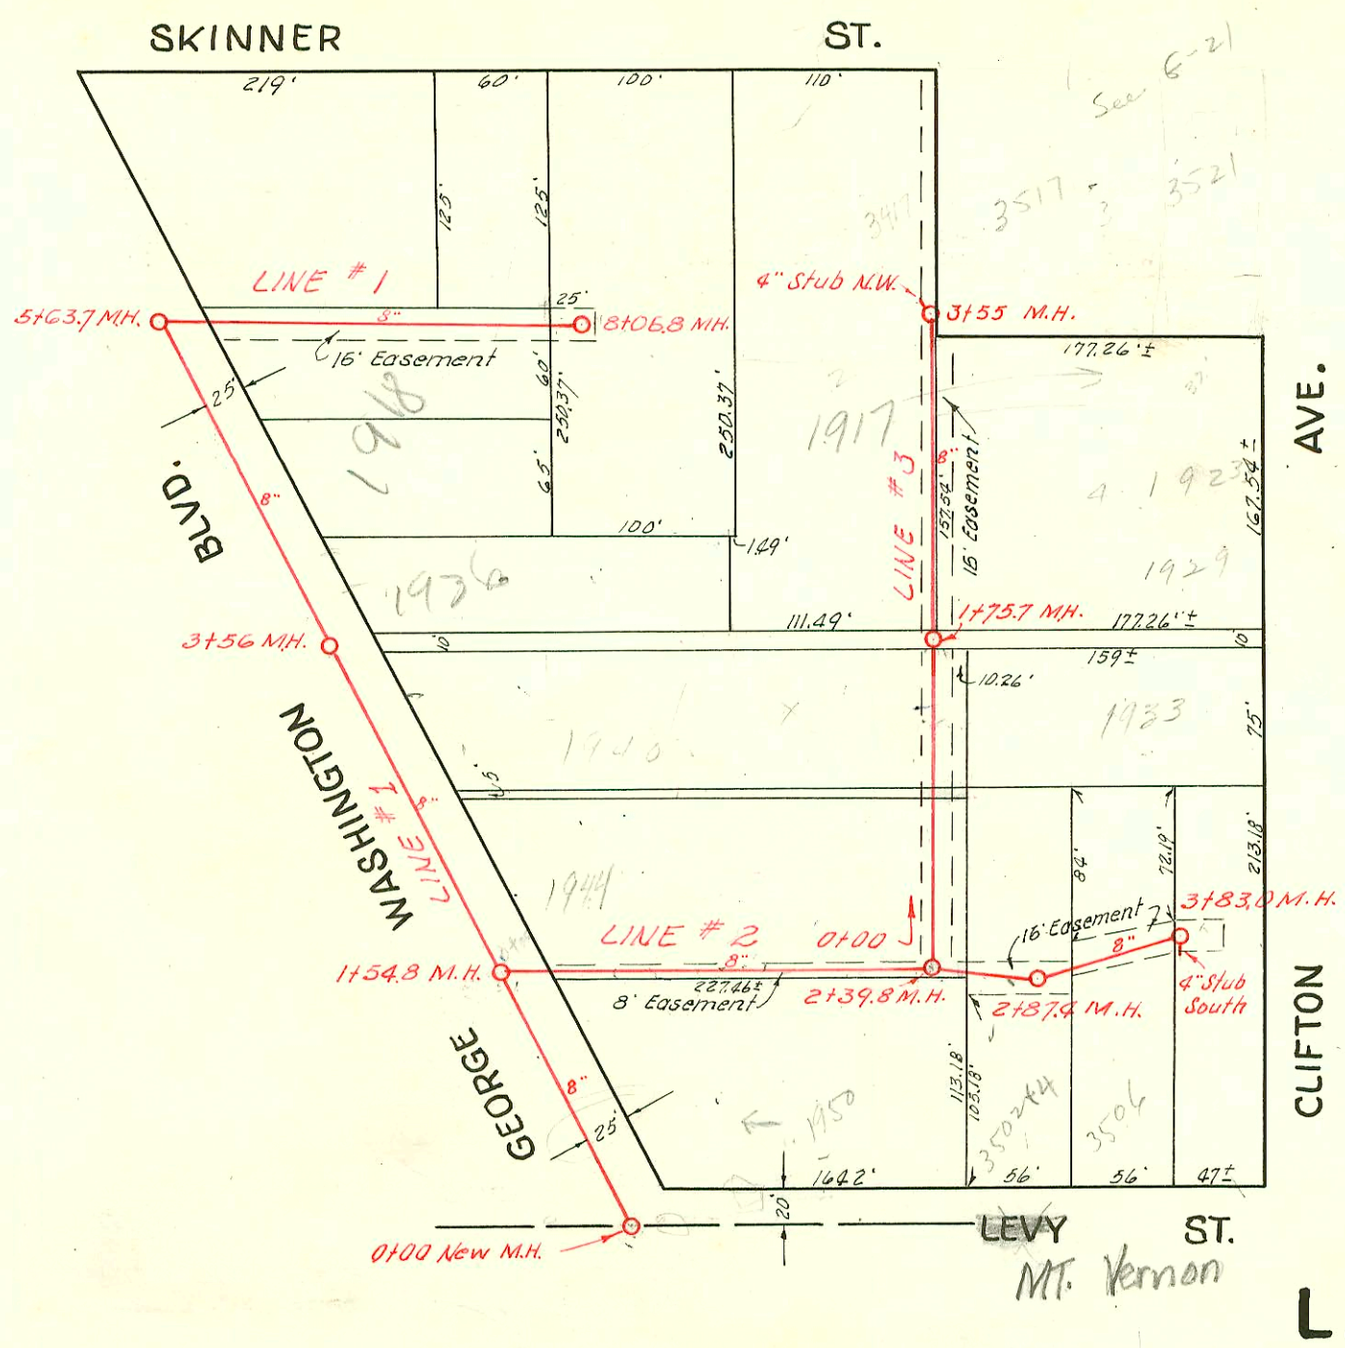

SCALE 1"=100'

LAT. 8, D.C.S#2, S.S.#12

W. B. CARTER, JULY 16, 1953

BK. NO. JT. 63, PROJ. NO. C21-70

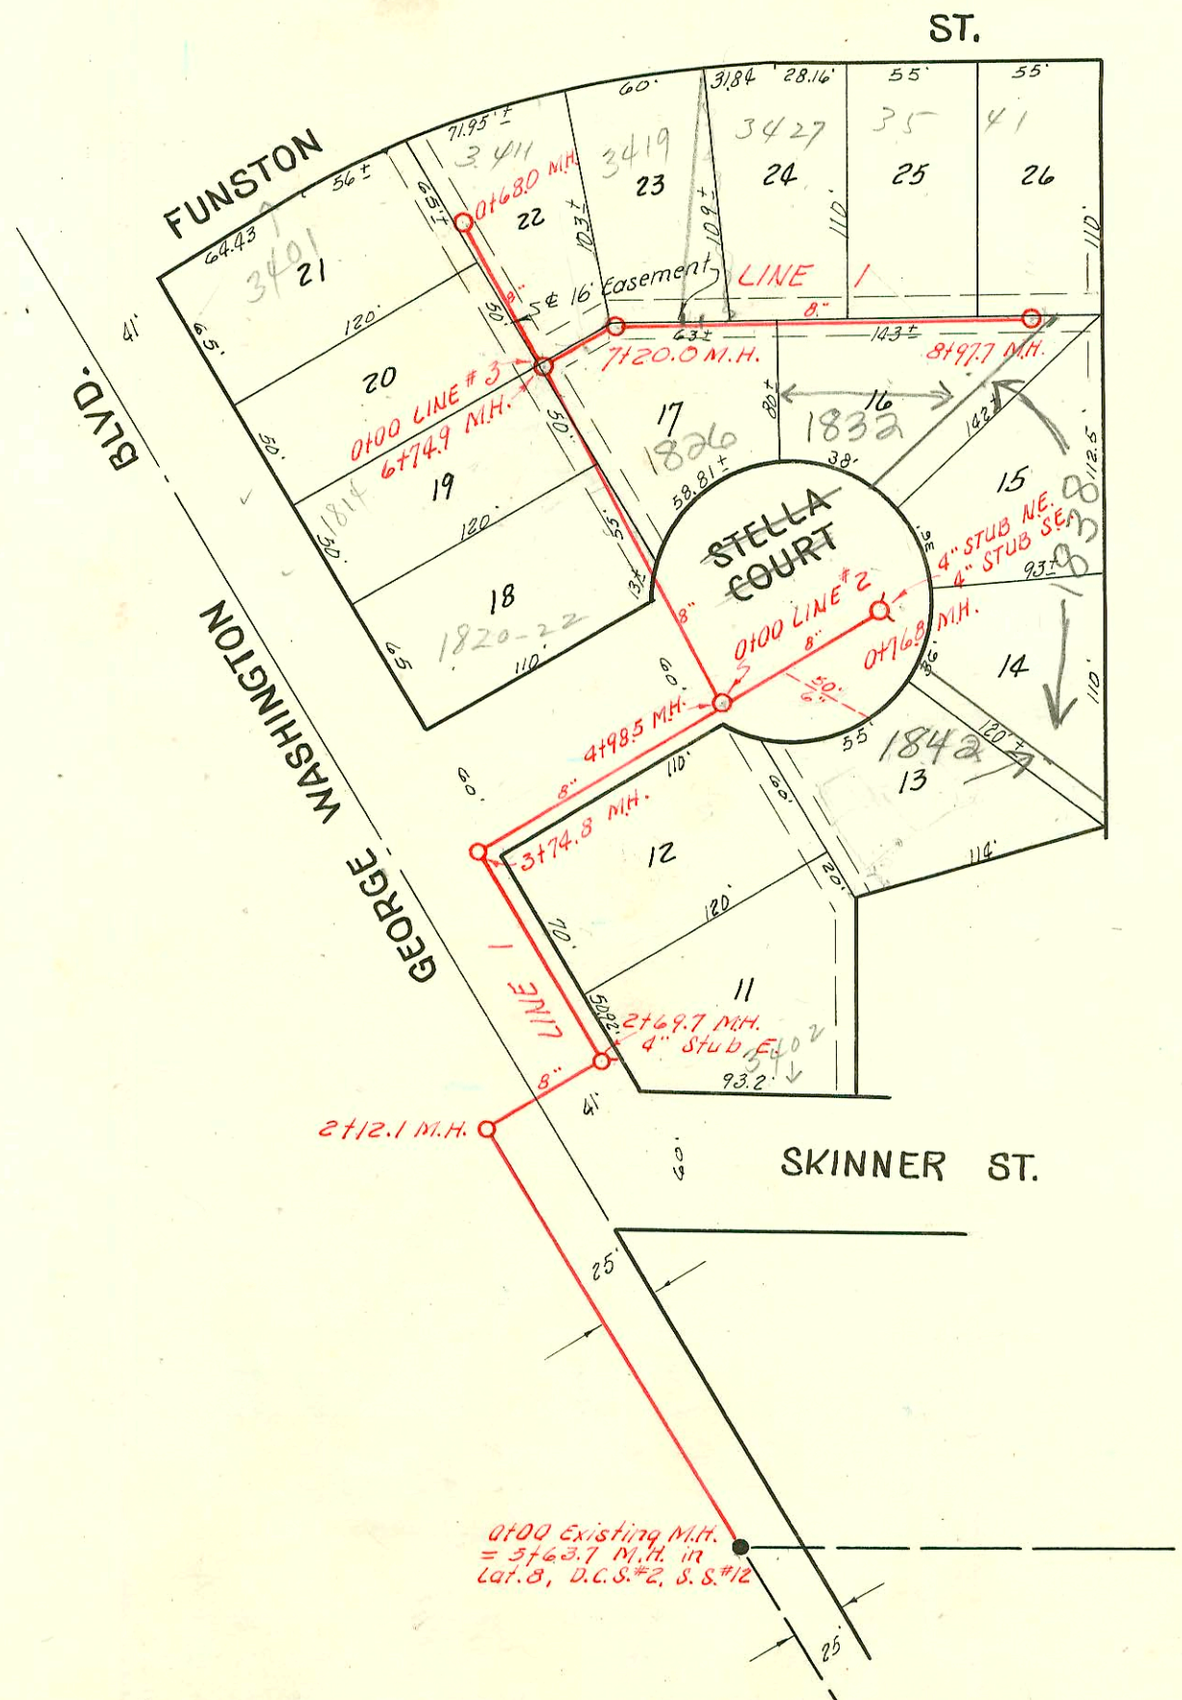

SCALE 1"=80'

2002-02282- 8/21/02- 1826 S George Washington- Quality Affordable- 7.8'E of MH 7+20 (7+27.8) twin co, 4" SCH40 PVC 1½"+ Fall, 2V22 - tied to wye w/donut

#12394 top 1944 Geo. Wash. Blvd. Bradford Irvine (1+40) line 2 3-29-60

15544 top 1950 Geo. Wash. Blvd - Artice Ray - 4-26-62 (1+51.8 line 2)

16609 top - 1917 S. Clifton - R.A. Smith Bldg. 2-7-63 (3+24)

B2137 top - 3419 E. Funston - Dean Lee - 12-10-64 (7+25.6)

LAT. 11, D.C.S.#2, S.S.#12

W. B. CARTER, JULY 16, 1953

BK. NO. JT. 63, PROJ. NO. C 22-26

Form 41-(54) 3-51

	CONSTRUCTION RECORD							SERVICE RECORD					
	STATION	ELEVATION Ground	ELEVATION Grade	Depth	MANHOLE	4-INCH "Y" BRANCHES North West	4-INCH "Y" BRANCHES ~~South~~ East	No. of Permit North West	No. of Permit South East	House Number North West	House Number South East	DATE OF PERMITS North West	DATE OF PERMITS South East
Line #1	0+0	102.8	95.44	7.4	0+00 New MH.								
	1+0	102.7	95.54	7.2									
		102.6	95.60	7.0	1+54.8								
	2+0	102.6	95.64	7.0									
	3+0	102.9	95.74	7.2			3+24.2				1936 Elizabeth		
		102.9	95.80	7.1	3+56.0		3+59.7		#6958				11-28-55
	4+0	103.2	95.84	7.4			4+47.0						
	5+0	103.6	95.94	7.6									
		103.7	96.01 out 96.21 in	7.7 7.5	5+63.7								
	6+0	103.7	96.24	7.5		Y NORTH 6+77.0	Y SOUTH	#321		1900 Geo Washington Blvd		3-16-54	
	7+0	104.9	96.34	8.6			7+18.7						
						7+66.7	7+48.0 to 2	#5923	9798	3411 E Skinner	1918 Reg Wood Blvd	7-24-53	12-6-83
	8+0	105.6	96.44	9.2		8+00.8 2		#3898		3415 E Skinner		3-14-55	
		105.6	96.45	9.2	8+06.8	(Old Tap in M.H)		#C 811 (Repair)					
Line #2	0+0	102.6	95.80	6.8	0+00 = 1+54.8 in line #1								
	1+0	103.7	95.90	7.8		1+44.0							
							1+72.0		#775 2000-00950		1950 Geo Washington Blvd (R)		4-18-00 4-26-54
	2+0	105.7	96.00	9.7									
		107.0	96.04 out 100.04 in	11.6 7.0	2+39.8								
							4"SCH40 2+62.8		#5928		3502 & 04 Int Vernon	R Replace 8' High End ITUBIN CO-1H22	7-7-53
		109.2	100.09	9.1	2+87.4								
	3+0	109.4	100.10	9.3			3+50.0		#3602 #5929		3506 Int Vernon	R	7-2-81 7-7-53
		113.5	100.18	13.3	3+83.0	(4" Stub South.)							
Line #3	0+0	107.2	100.00	7.2	0+00 = 2+39.8 in Line 2	Y West	Y EAST						
	1+0	107.7	100.10	7.6		4"SCH40-CO 1+35.4	1+14.4	2001-02875 #121		1940 R Sunset Blvd		11-9-01 2-17-54	
		107.9	100.18	7.7	1+75.7		1+99.4		#1345		1929 S Clifton		6-29-54
	2+0	108.2	100.20	8.0			2+44.0 +81.0		4343		1923 S Clifton		4-16-57
	3+0	108.3	100.30	8.0									
		108.4	100.36	8.0	3+55.0	(4" Stub N.W.)		#5994		3417 E. Skinner		7-30-53	
Line #1	0+0	103.7	96.01	7.7	0+00 Exist'g MH.								
	1+0	104.3	96.11	8.2									
	2+0	104.7	96.21	8.5									
		105.0	96.22 out 96.42 in	8.8 8.6	2+12.1								
		104.9	96.48 out 96.68 in	8.4 8.2	2+69.7	(4" Stub E.)							
							Y EAST 2+83.0		#5910		3452 Sitka Ct		7-23-53
	3+0	105.3	96.71	8.6									
		104.8	96.78 out 96.98 in	8.0 7.8	3+74.8								
	4+0	104.9	97.01	7.9									
		106.6	97.11 out 97.31 in	9.5 9.3	4+98.5								
	5+0					Y WEST 5+75.2							
	6+0	105.7	97.41	8.3		6+40.6		#4016		1814 Geo Wash. Blvd		3-29-55	
		106.0	97.48 out 97.68 in	8.5 8.3	6+74.9								
	7+0	105.8	97.71	8.1									
		105.6	97.77	7.8	7+20.0	Y NORTH	Y SOUTH		2002-00282		1826 Geo Washington	R see next S	8-21-02
						7+35.6	~~7+32.6~~ #27.8		#3753		~~Helen~~		3-4-55
						7+92.8							
	8+0	106.9	97.81	9.1			8+05.3						
						8+49.7		5157		3435 E Funston		8-26-57	
						8+85.0		16009 5156		3441 E Funston		3-21-86 8-26-57	
		108.6	97.90	10.7	8+97.7								
Line #2	0+0	106.6	97.09	9.5	0+00 = 4+98.5 in line 1		(6" Y SOUTH 0+28.0 0+48.5 End of 6" Lead 50" of 6" V.C.P.)		15093		1842 Geo Wash Blvd.		1-8-62
		106.5	97.17	9.3	0+76.8	{4" Stub N.E. 4" Stub S.E.}	4"40-CO	2062-01851 Int SE #6805		Lot 15 New 1838 Geo Ct	1838 R	7-2-02 10-29-53	
Line #3	0+0	106.0	97.46	8.5	0+00 = 6+74.9 in Line 1	Y WEST 0+07.8	Y EAST 0+35.0						
						0+55.4							
		106.8	97.53	9.3	0+68.0								

Taps approx 12' out not per Olson's Cleanups on 3/11/ BSL

#7398 - Tap - 3402 E. Skinner - 1-13-54 - Rugg Bldg.
#3363 - Tap - 1820-22 Geo Washington Blvd - 2-9-55 - Reynolds Bldg
#5945 - Tap - 3428 Sitka Ct - Hamling Bldg. - 10-25-55
5698 Tap 1933 S Clifton 12-13-57 Nichol Heseley
10349 Tap 3401 E Funston Advance Bldg 5-28-59 0+45 line 3
2003-03402 R 10890 Tap 3427 E Funston Advance Bldg 7-21-59 7+65.6 Wichita Ex. Predco saddle (on msmt) TWINCO 4" SCH40 1/4" fall 2H22 full replacement
10889 Tap 3411 E Funston Advance Bldg 8-7-59 7+04.5