


NE. 1/4 SEC. 35, TWP. 27 S. R. 1 E.

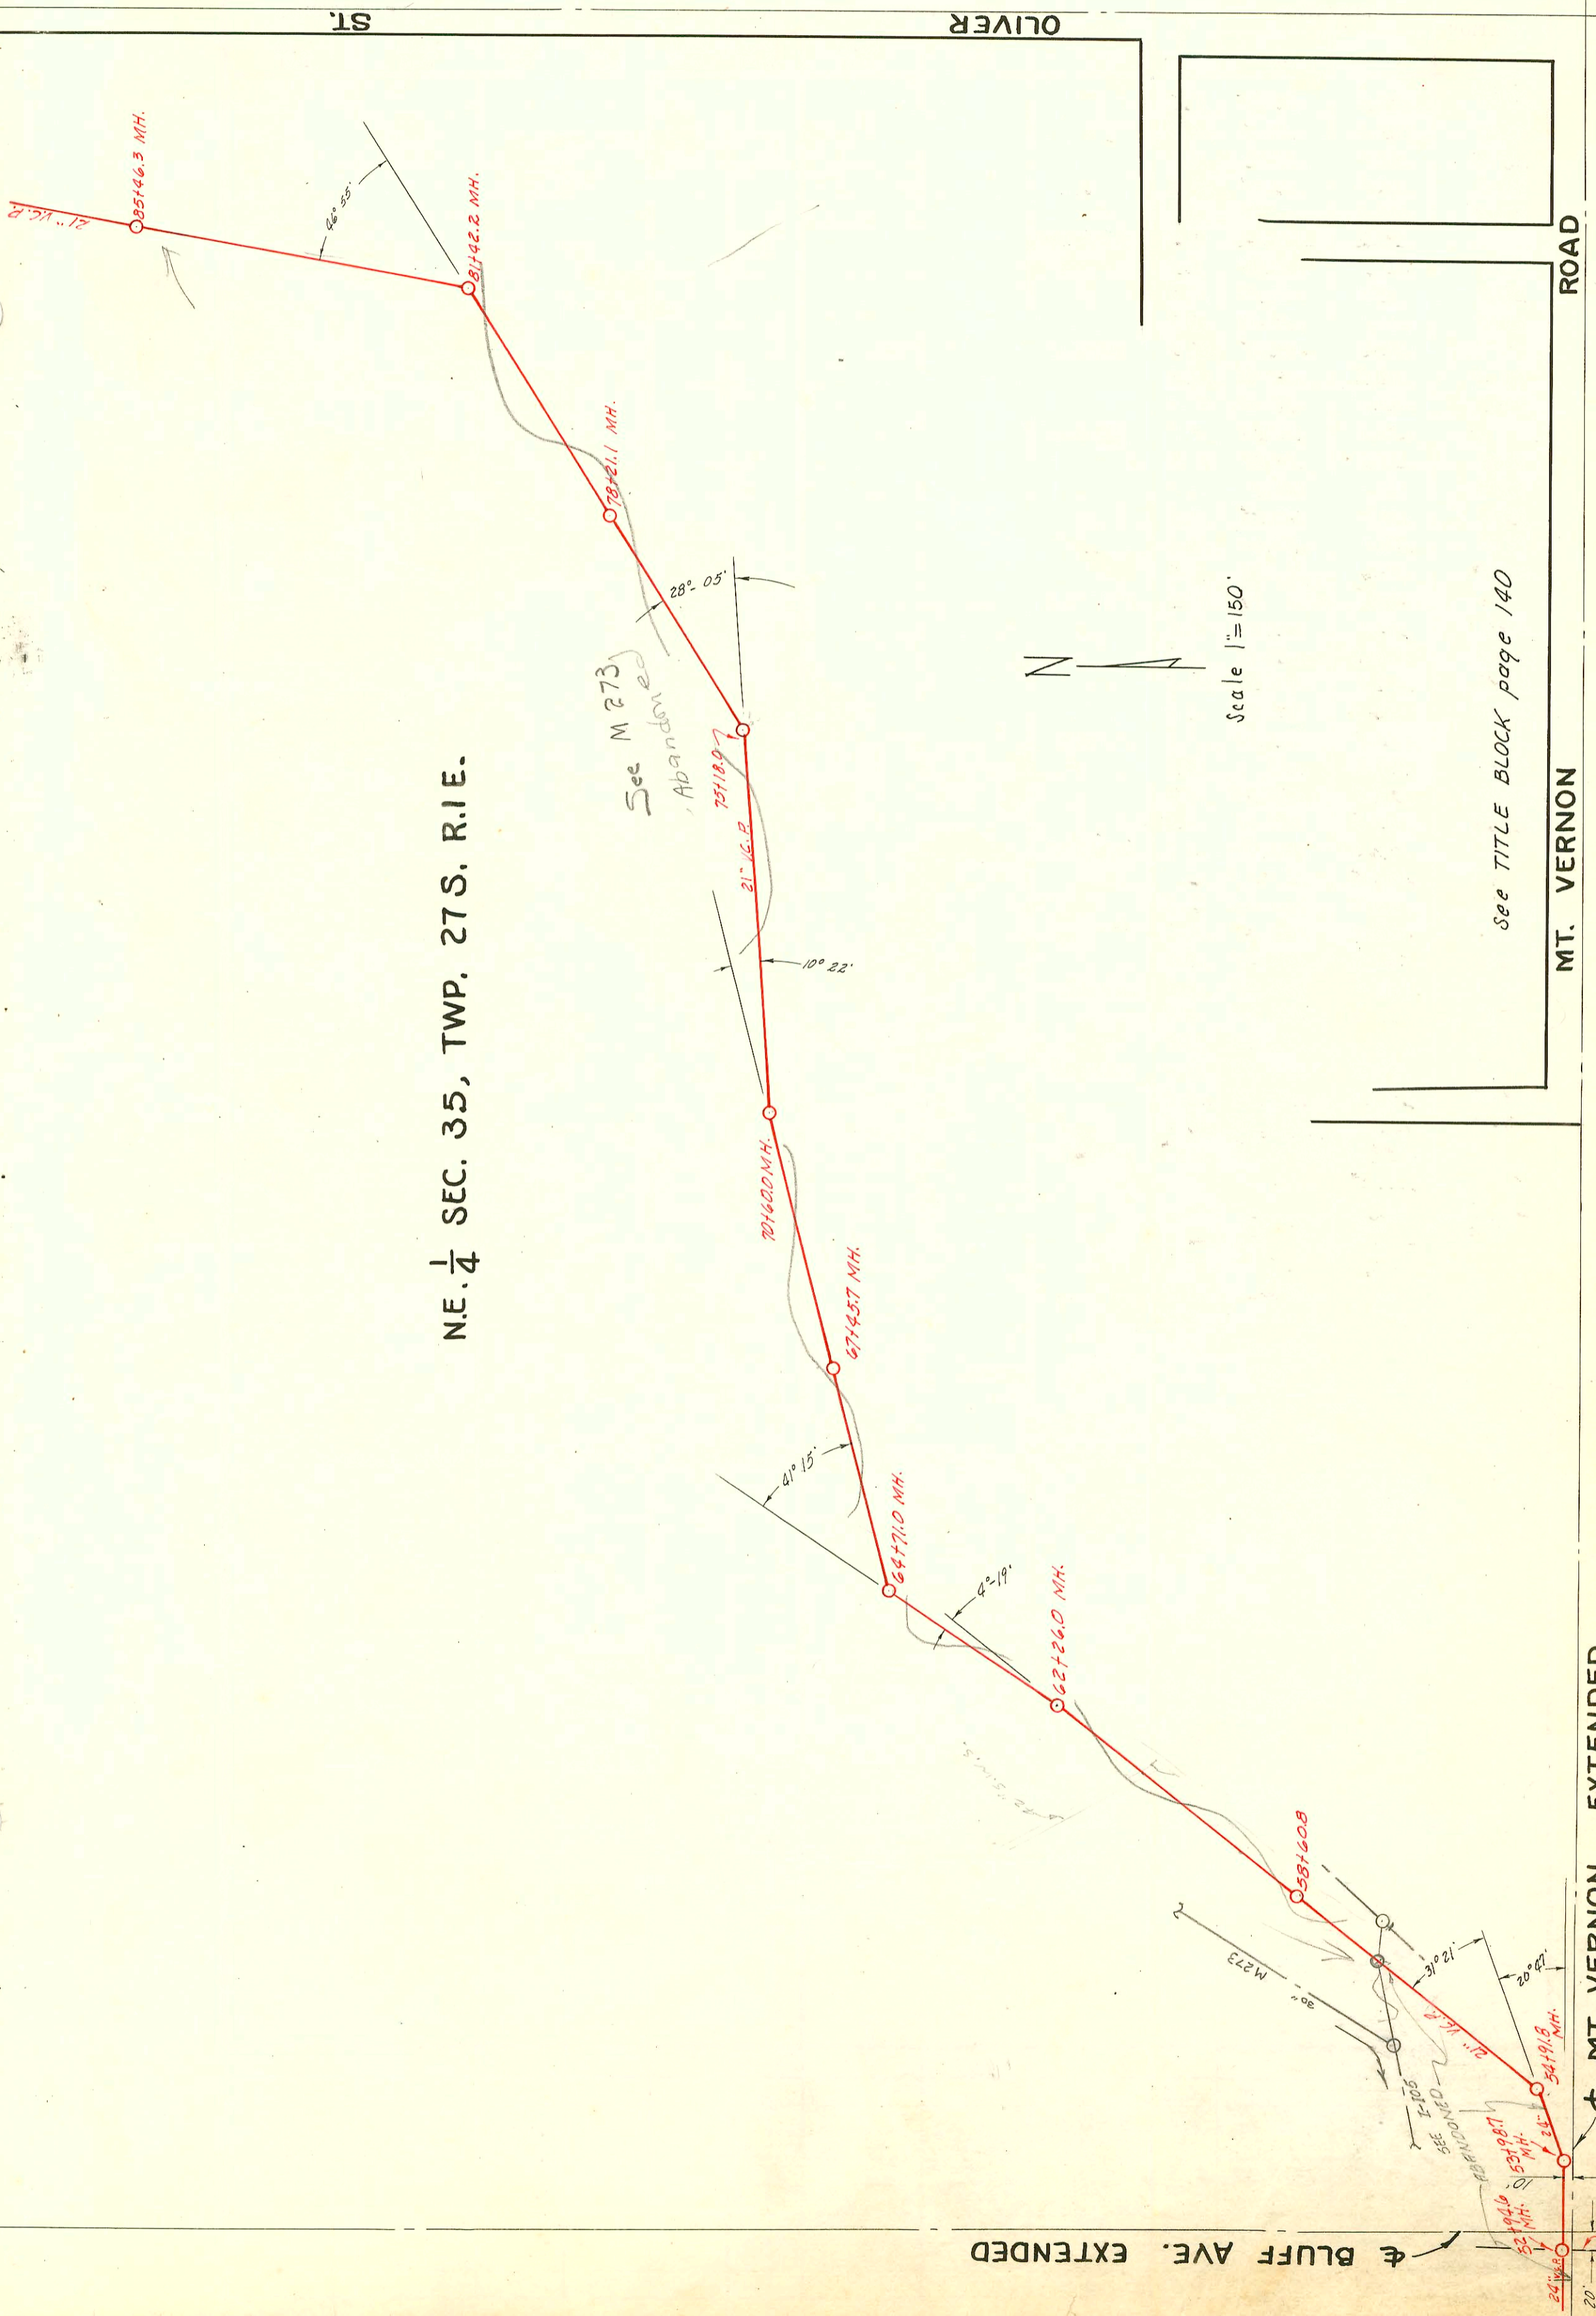

See M 273
Abandoned



Scale 1" = 150'

See TITLE BLOCK page 140

MT. VERNON ROAD

MT. VERNON EXTENDED

BLUFF AVE. EXTENDED

Abandoned Pipe betw. Manholes.
Plugged Both Ends.

