


Reconstructed
SEE P-14

5811 S. 9th
Activity Center

C 74719-555 71 Woodlawn (office bldg) - Howard Add
Temp. conn. in E.W. line out of m.H. 6+06.7 - to be replaced
when new lateral is built. 10/5/79 - R.M.
Spec Lat Assess
top into m.H. 9+80 in private line. See #1002

LAT. 92, D.C.S. 2, S.S. 12
W. B. CARTER CONST. CO. INC.
PROJ. NO. C27-73 BK. I.H. 3
4-4-68
SEE TITLE PAGE 140

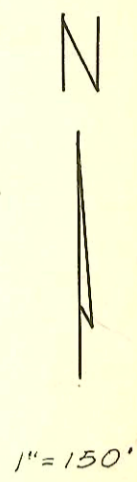

0+00 Existy drop MH. on
15" Sanitary Sewer

KAPAWN
Sewer

CONSTRUCTION RECORD						SERVICE RECORD						
STATION	ELEVATION		Depth	MANHOLE	4-INCH "Y" BRANCHES		No. of Permit		House Number		DATE OF PERMITS	
	Ground	Grade			North West	South East	North West	South East	North West	South East	North West	South East
0+0	178.0	165.95	11.0	0+00 Exist'g MH.								
1+0	176.1	166.15	10.0									
2+0	176.7	166.35	10.3									
	177.9	166.55	11.3	2+98.7								
3+0												
4+0	177.1	166.75	10.4		4+16.1			C40552	5919 E. Central		8-10-73	
5+0	177.2	166.95	10.3		5+84.1 tap			13796	5940 E. Central		5-20-85	
6+0	175.8	167.15	8.7									
	176.0	167.17	8.8	6+06.7								
7+0	177.9	167.35	10.5									
8+0	177.8	167.55	10.2									
	179.0	167.65	11.4	8+47.9	MH tap							
9+0	180.3	167.75	12.6									
10+0	179.7	167.95	11.8									
	180.4	168.12	12.3	10+86.5								
11+0	180.6	168.15	12.5									
12+0	181.8	168.35	13.5									
13+0	180.9	168.55	12.4									
	181.0	168.60	12.4	13+25.7								
14+0	181.4	168.75	12.7									
15+0	181.4	168.95	12.5									
16+0	182.8	169.15	13.6									
	183.6	169.25	14.3	16+49.0								
17+0	183.9	169.35	14.6									
18+0	183.9	169.55	14.3									
19+0	183.7	169.75	14.0									
	180.4	169.90	10.5	19+73.4								
20+0	183.8	169.95	13.8									
21+0	184.8	170.15	14.6									
22+0	184.6	170.35	14.2									
	185.4	170.55	14.9	22+98.8								
23+0												
24+0	186.7	170.75	16.0									
25+0	187.4	170.95	16.5									
26+0	187.0	171.15	16.2									
	187.6	171.28	16.3	26+56.5								
27+0	188.4	171.35	17.0									
28+0	190.0	171.55	18.5									
29+0	192.1	171.75	21.3									
30+0	193.6	171.95	21.7									
	194.5	172.05	22.4	30+51.4								
31+0	195.2	172.15	23.0									
32+0	196.9	172.35	24.5									
33+0	198.6	172.55	26.0									
	198.6	172.56	26.0	33+06.3								
34+0	201.0	172.75	28.3									
	202.1	172.84	29.3	34+44.5								
35+0	203.6	172.95	28.6									
36+0	204.6	173.15	31.4									
37+0	205.6	173.35	32.2									
	206.2	173.45	32.7	37+49.3								
LAT 110 - MAIN 2 - S.S. # 12												
	161.31	149.85	11.5	MH 174+24.0	6" stub E 150.67 HD			19791	350 E. Carrigan		12-2-87	
LAT. 92, D. C. S. 2, S. S. NO. 12												
0+00	177.0	166.65	10.3	0+00.0 M.H.	4" stub W.			C10146	59008 Central		8-21-68	
1+00	178.0	166.95	11.0									
	179.2	167.03	12.2	1+19.0	4" stub E.			C1725	6000 E. Central		4-4-68	
9780237 S20-97 818 N Carrigan Pkwy - Wichita Clinic												
11582 - 650 Carrigan Park - 7-25-84 - Mike Bratcher - MH tap 8+47.9												
C405773 tap-5811 E. 9th - Donald Thompson - 11-16-67 (Comm. Dept. Diag.) No Spec. Fee - per Wilton (top 22+98.8)												
#B4511 - 5920 E. Central - 4-7-66 - Dean - top (3+57.7) Spec. fee 25.00 - Rec 89305												
8-8-55 - Regg. Pkwy. Co. Special Comm. fee - 40.00 - 8-8-55 (5901 E. Central) - receipt # 31963												
8-8-55 - Regg. Pkwy. tap - 5908 E. Central - #5935 (No measure)												
#C13426 Deal off 5908 E. Central - Al Henning - 4-7-69												
#C22290 Deal off - 5920 E. Central - Al Henning 12-21-70 (3+57.7)												

G
145