


WASSALL AVE

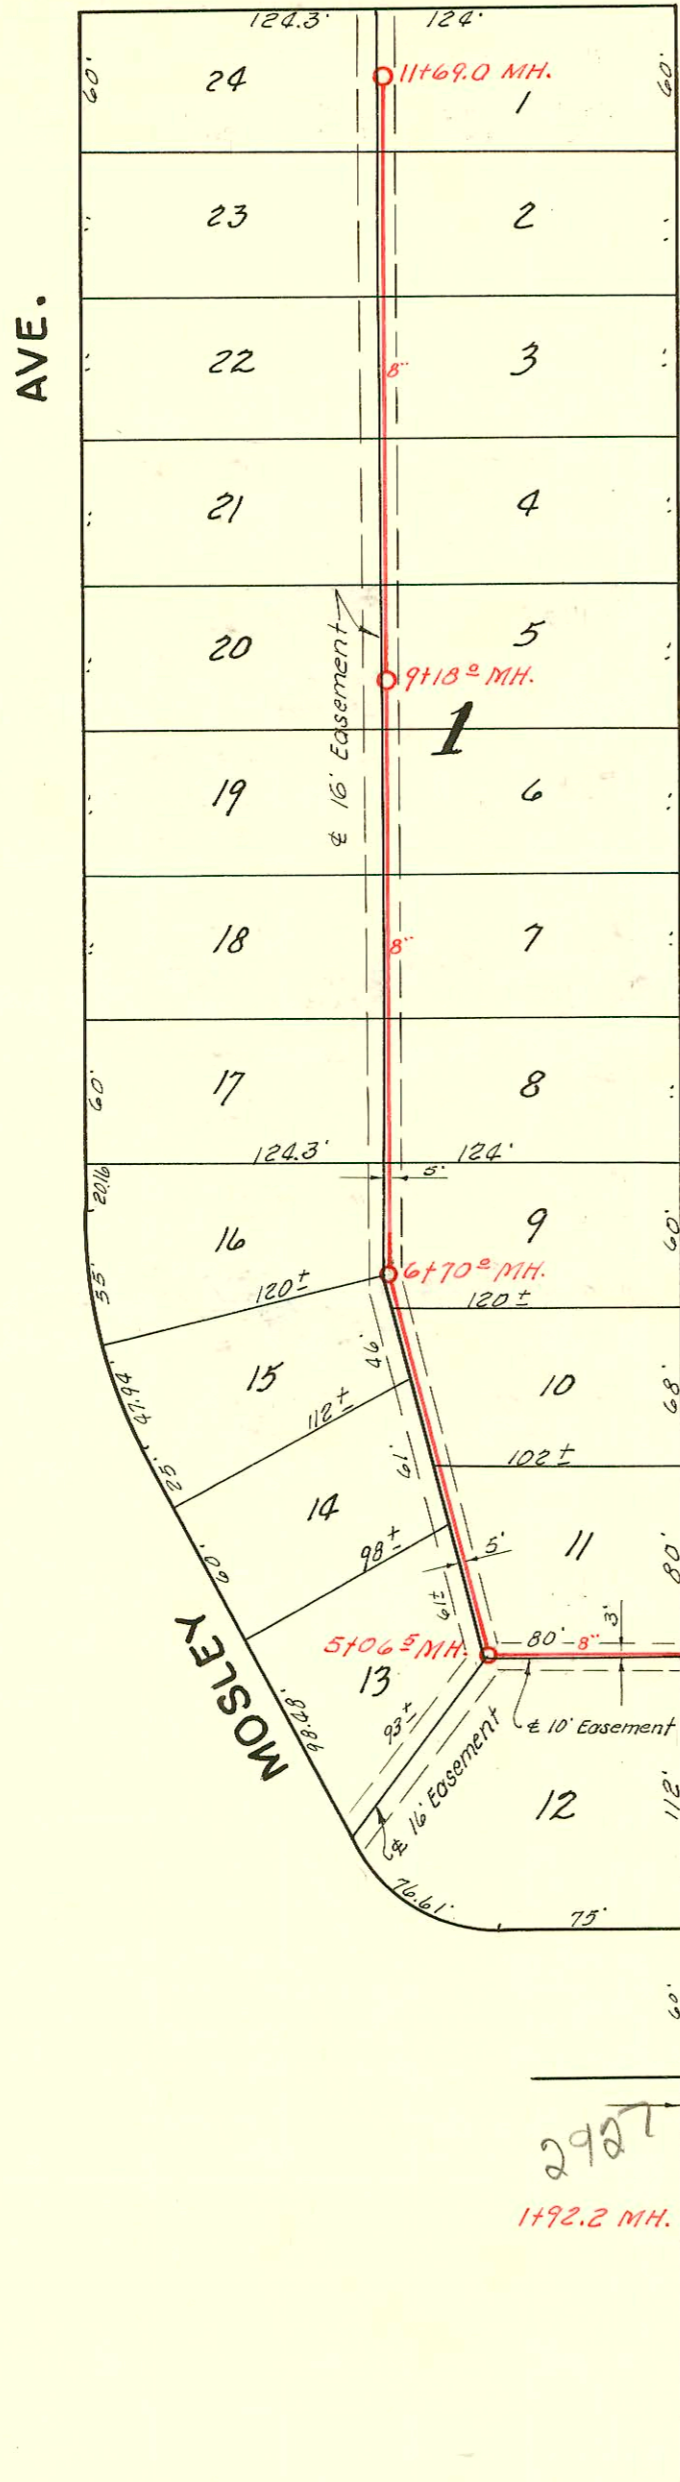

TRAP AREA



SCALE 1"=80'

WASHINGTON AVE

LAT. 20, DIST. A, S. S. # 20

W. B. CARTER, OCT. 20, 1953

BK. NO. JT. 67 PROJ. NO. C23-16

