WICHITA STATE UNIVERSITY DORMITORY COMPLEX
Relocation San. Sewer
JAN. 4, 1966
BK. No. K-77

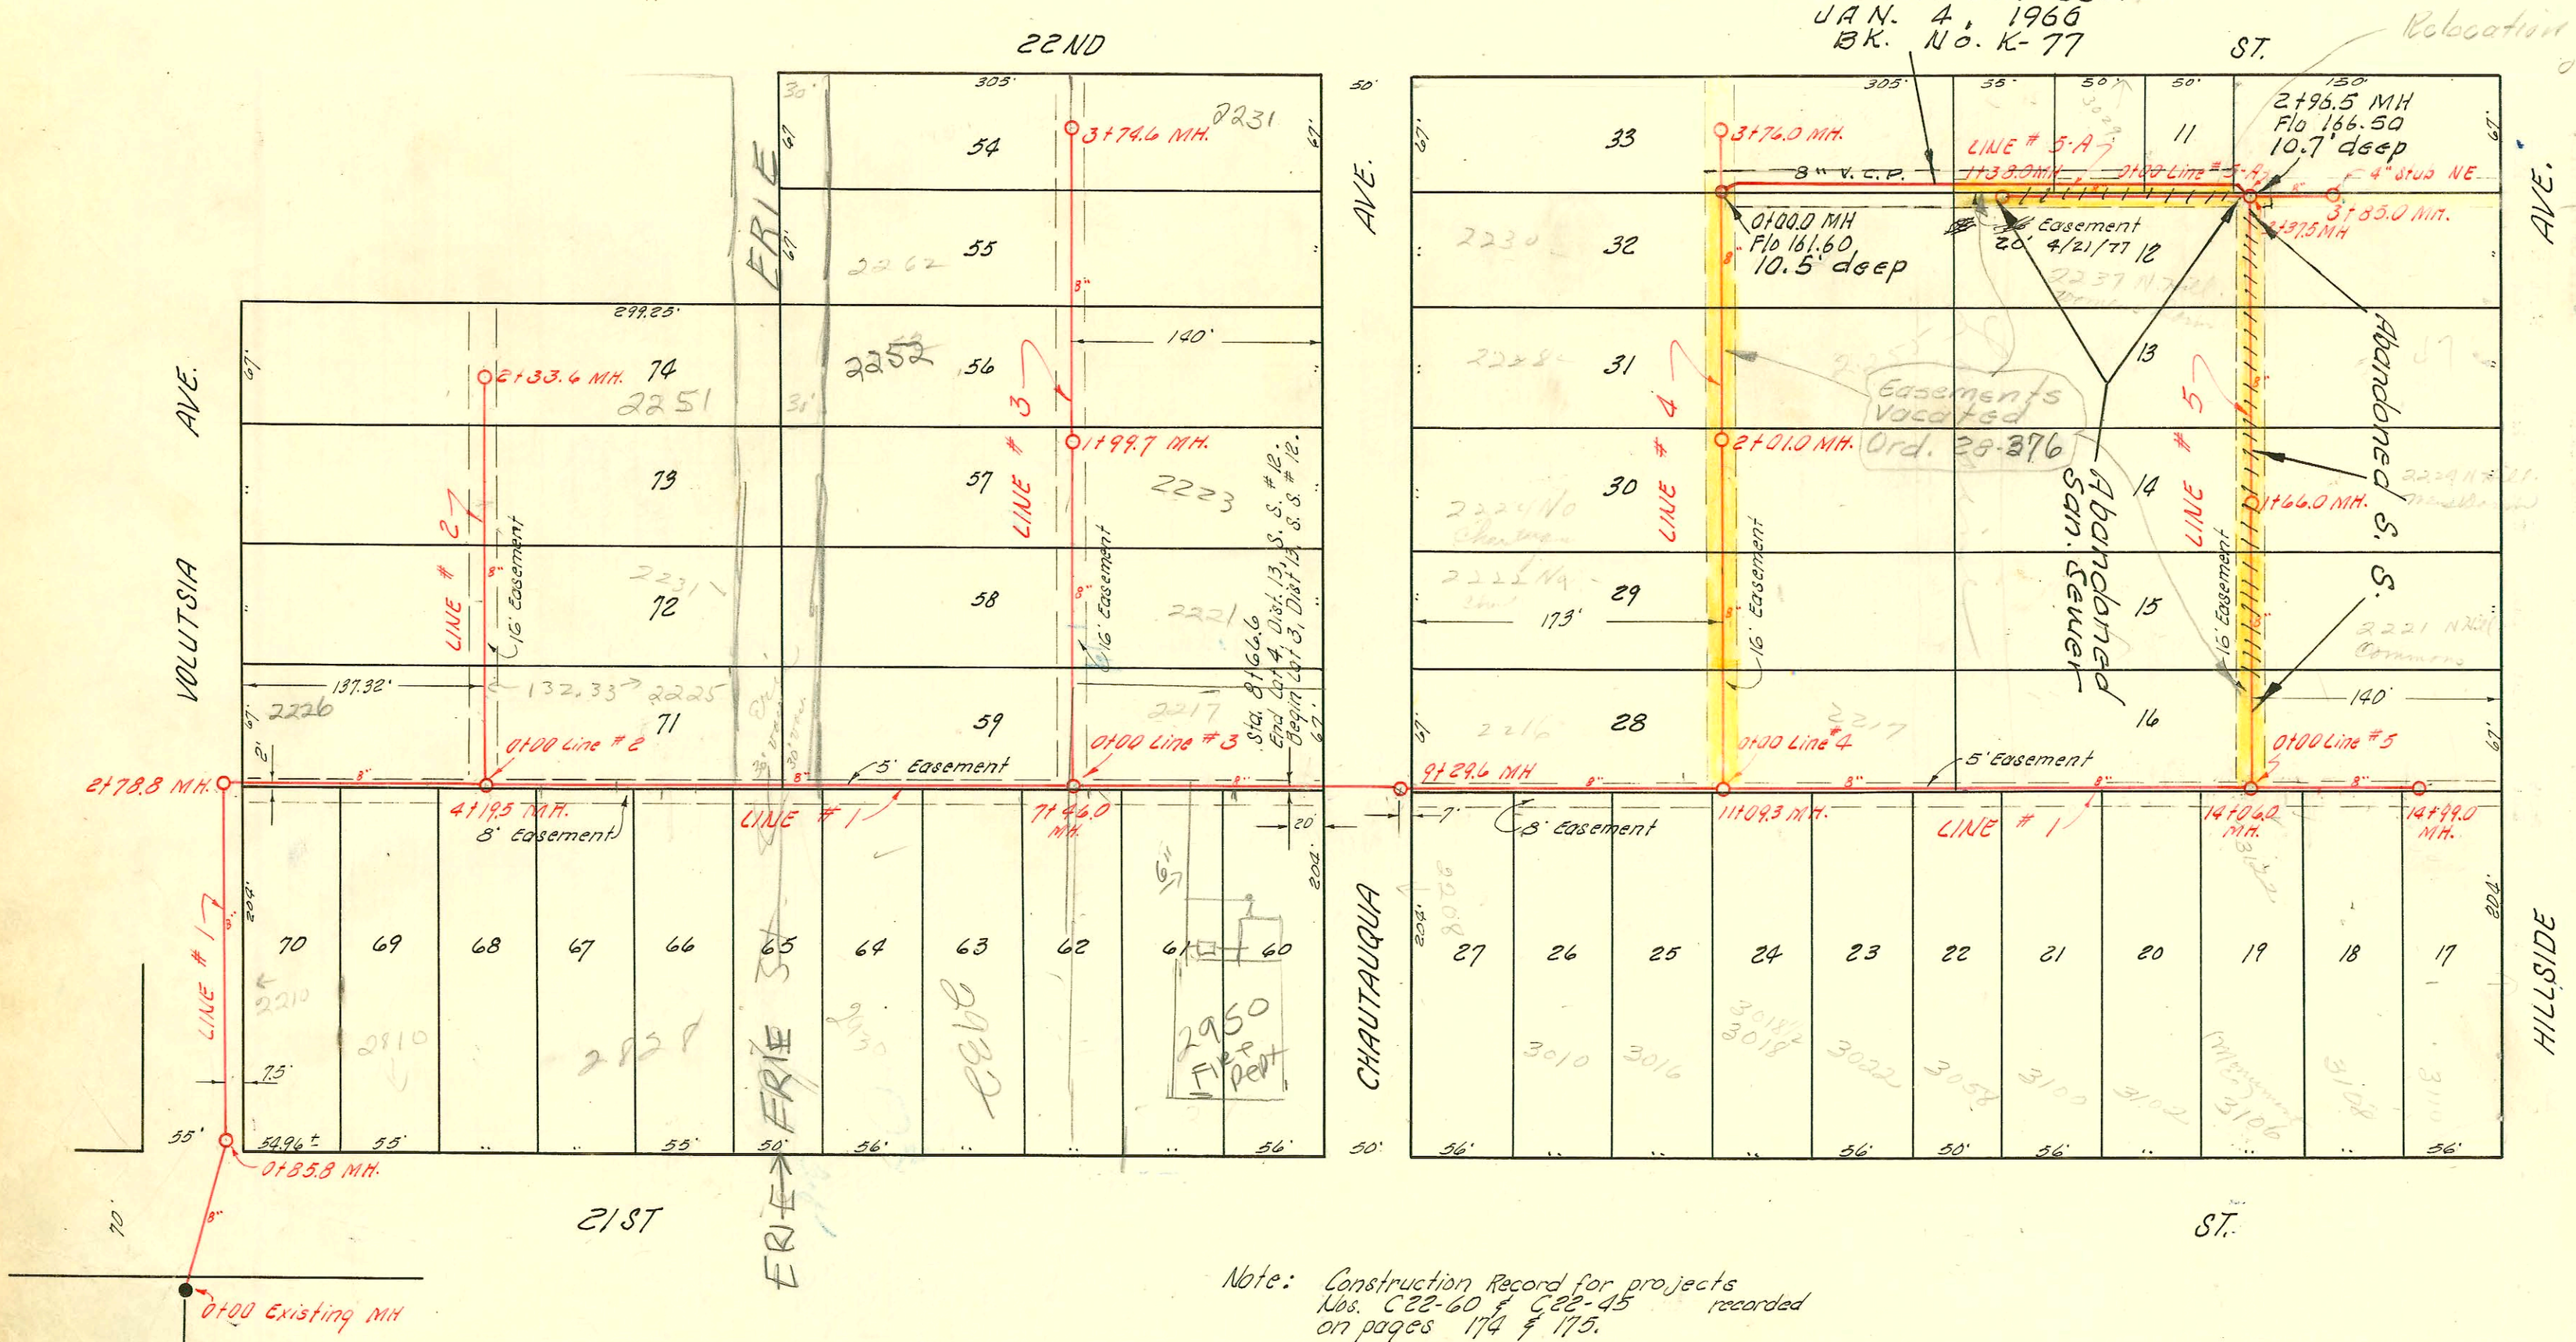

Note: Construction Record for projects Nos. C22-60 & C22-45 recorded on pages 174 & 175.

LAT. 4, DIST. 13, S. S. NO. 12
W. B. CARTER, APRIL 14, 1954
BK NO. K-19, PROJ. NO. C22-60

Project No. C22-60 include:
Sta. 0+00 to 8+66 Line #1
Line #2
Line #3

LAT. 3, DIST. 13, S. S. NO. 12
W. B. CARTER, APRIL 14, 1954
BK. NO. K-19, PROJ. NO. C22-45

Project No. C22-45 include:
Sta. 8+66 to Sta 14+99 Line #1
Line #4
Line #5
Line #5-A

G 174A

Do not issue permit until plumbing is O.K'd by Inspection on 2924 E. 21st

Form 41-(54) 8-53

	CONSTRUCTION RECORD							SERVICE RECORD					
	STATION	ELEVATION Ground	ELEVATION Grade	Depth	MANHOLE	4-INCH "Y" BRANCHES North ~~West~~	4-INCH "Y" BRANCHES South ~~East~~	No. of Permit North West	No. of Permit South East	House Number North West	House Number South East	DATE OF PERMITS North West	DATE OF PERMITS South East
Line #1	0+0	151.4	143.00	8.4	0+00 Exist'g MH.								
		153.7	143.34 out 146.00 in	10.4 7.7	0+85.8								
	1+0	154.4	146.06	8.3									
	2+0	156.4	146.46	9.9									
		158.6	146.78 out 147.00 in	11.8 11.6	2+78.8								
	3+0	158.2	147.08	11.1									
							3+01.0 Tap 3+96.8 ~~3+52.0~~		59402		2210 N. Valentine		1-7-77
	4+0	156.6	147.48	9.1			4+00.0						
		156.5	147.56	8.9	4+19.5								
							5+18.5 TAP ~~4+55.5~~		18281	2225	2828 E. 21st		5-7-87
	5+0	156.0	147.88	8.1		5+00.9	5+17.5 S10	B4388	17628	N. Erie	2810 E. 21st	10-20-65	1-13-87
							5+09.5						
							5+15.5		#3978		2920 E. 21st		11-6-56
							5+67.0 See Note at top						
	6+0	156.0	148.28	7.7									
							6+21.0		#6266		2930 E. 21st		9-6-55
							6+79.0		#666		2932 E. 21st		6-19-8 4-19-54
	7+0	156.7	148.68	8.0					3849		2932 E. 21st		8-7-81
		158.3	148.87 out 152.06 in	9.4 6.3	7+46.0				2663, 1534				6-11-63
							Seal off 7+52.0		#16969 1132		2934 E. 21st	S10 on North side of lot	9-15-86 6-9-54
							7+89.0						
	8+0	159.7	152.20	7.5									
						Seal off 34	8+31.6		2053, 1533 C42389		2938 E. 21st	S10 on North side of lot	6-11-63 11-26-73
	8+77	End Lat. 4, Dist. 13, S.S. # 12											
		Begin Lat. 3, Dist 13, S.S. # 12											
	9+0	162.7	152.60	10.1									
		163.8	152.72 154.00	11.1 9.8	9+29.6								
							9+48.6	Seal	B#5007 739		2208 N. Vanburen		1-31-66 4-31-54
	10+0	164.5	154.28	10.2									
							10+09.3	Seal	B5005 #790		3010 E. 21st		1-31-66 4-28-54
						10+24.3							
							10+97.3	Seal off	#B4472 #791		3016 E. 21st		11-3-65 4-28-54
	11+0	166.3	154.68	11.6									
		166.3	154.72 out 158.00 in	11.6 8.3	11+09.3								
							11+46.5	Seal	B5006 #632		3022 E. 21st		1-31-66 4-14-54
	12+0	168.1	158.36	9.7									
							12+43.3	Seal	B5008 #631		3100 E. 21st		1-31-66 4-14-54
	13+0	171.1	158.76	12.3		top	12+47 3		B5095		~~2229 N. Hillside~~		3-1-66
							13+09.8	Seal	B5009 #1054		3102 E. 21st		1-31-66 12-14-55
							13+43.0		#5283		3106 E. 21st		6-22-55
	14+0	173.5	159.16	14.3									
		173.7	159.19 163.00	14.5 10.7	14+06.0			Seal	B5015 #309		3120 E. 21st	310	1-31-66 3-23-56
							14+15.5						
							14+27.5						
							14+54.5						
		174.1	163.37	10.7	14+99.0								
						Y West	Y East						
Line #2	0+0	156.5	149.08	7.4	0+00 = 4+19.5 in Line #1								
						4" ABS Repl 15' @ Main only 0+41.0	0+23.0	95-12237 #1800		2226 N. Valentine R		8-7-95 8-20-54	
							0+84.0		#14294		2231 N. Erie		6-8-61
	1+0	160.1	149.40	10.7									
						1+09.0							
						1+45.0	1+48.0	C35958 #1627	18449 #278	Sealed off	2238 N. Valentine	2237 Erie R	11-13-72 4-14-54 6-8-87 3-26-56
	2+0	161.4	149.80	11.6									
							2+14.0 ok	92-42244-7 #869	14312 9605	2242 N. Valentine R	2251 N. Erie R	5-16-72 5-3-54	7-23-85 3-12-59
						4" SDR 35 2+26.0							
		160.9	149.96	10.9	2+33.6								
Line #3	0+0	158.3	153.00	5.3	0+00 = 7+46.0 in Line #1								
						0+23.0 0+80.0	0+20.0						
	1+0	160.4	153.40	7.0									
							1+01.0		#1246 #776		2221 N. Chautauqua		10-2-54 4-26-54
						1+40.5	1+37.5		#628		2223 N. Chautauqua		4-14-54
		164.7	153.80 156.60	10.9 8.1	1+99.7								
	2+0												

Note: This project continues on page 175

See Page 11-10-65 6-26-55

B4516 14+51) #5284 - top - 3108 E. 21st - Calkins Bldg.

4303 - Tap - 2201 N. Hillside - McDonald - 4-26-54

#5946 - top - 2237 N. Valentine - Lafay Bldg. Dr. 1-7-55

Seal off C25859 #7003 - top - 2217 N. Chautauqua - Lafay Bldg. Dr. 12-7-55 - 7/26/71

#2165 - top - 2211 N. Hillside - Phipps - 2/2/57 - C68018 - Henning 30. (14+34.1)

C Rutlife #02986 Seal #3122 E. 21st - Frederick Bldg. 3-15-65

13454 Tap 2259 N. Hillside Lee Tide 10-14-60

B4897 - top - 2216 N. Chautauqua - 1-6-66 Robt McDonald (9+97.2)

Seal off B4898 - top - 2218 N. Chautauqua - 1-6-66 (13+72.4)

B6127 - " - 8-4-66