


### LAT. II, SUB. Y, S.S. 12

W. B. CARTER  
BK. NO. JT-70

JUNE 15, 1954  
PROJ. NO. C24-12

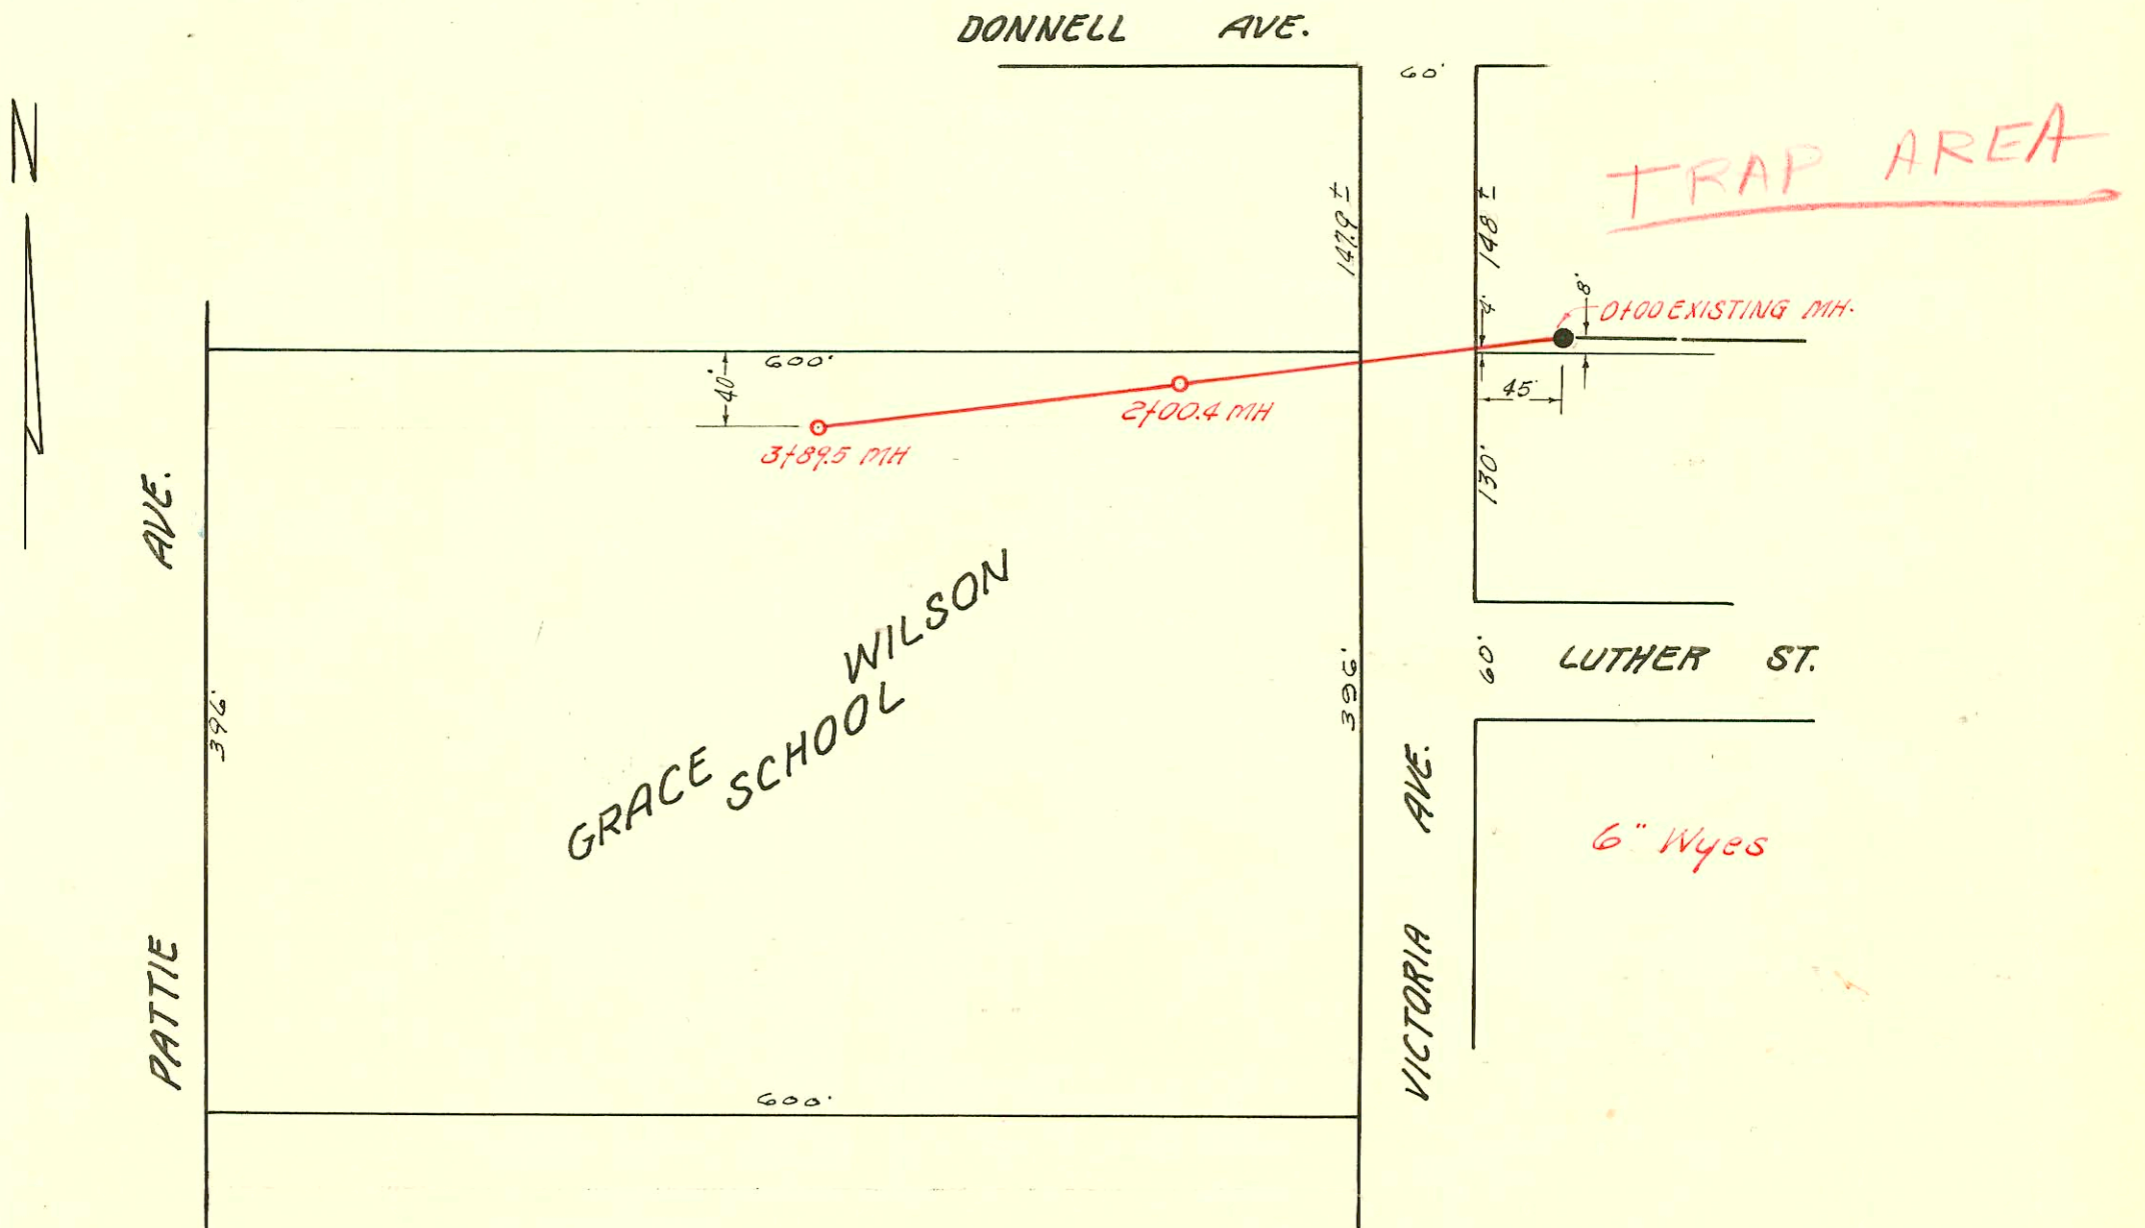

GRACE WILSON SCHOOL S. S.  
UTILITIES CONT. INC., JULY 7, 1954  
BOOK NO. JT. 61, PRIVATE CONTRACT

