


TRAP AREA

(6" Wyes used on this project.)

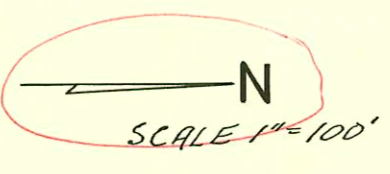

LAT. 1 S.S. 22

Utilities Contractor
W.B. CARTER JUNE 16, 1954
 BK. NO. JI-61 PROJ. NO. C24-3

ST.

ST.

TULSA

CROWLEY

VICTORIA AVE.

CONSTRUCTION RECORD

SERVICE RECORD

Line #1

STATION	ELEVATION		Depth	MANHOLE	4-INCH "Y" BRANCHES		No. of Permit		House Number		DATE OF PERMITS			
	Ground	Grade			North West	South East	North West	South East	North West	South East	North West	South East	North West	South East
0+00	89.3	82.00	7.3	0+00 EXIST'G MH										
1+00	89.7	82.20	7.5											
	90.3	82.28	8.0	1+38 NEW MH										
1+66.7	91.7	82.33 out 82.51 in	9.4 9.2	1+66.5										
2+00	90.7	82.60	8.1		2+36	2+39	#1725	20500 20499	1239 1238	1238 1238	8-10-54	4-19-88 6-14-54		
3+00	89.8	82.80	7.0		3+00	3+03	#1726	#1169	1233 1227	1233 1236	8-10-54	6-14-54		
					3+64.4	3+67.4	#1727	#1170	1227 1227	1236 1236	8-10-54	6-14-54		
4+00	90.4	83.00	7.4		4+24.3	4+27.3	#1728	#1171	1221 1221	1220 1220	8-10-54	6-14-54		
					4+77									
4+83	90.8	83.17	7.6	4+82.9										
5+00	91.2	83.20	8.0			5+01		#1172	1214 1214	1214 1214		6-14-54		
						5+36.3		#1730	1207 1207	1207 1207	8-10-54	6-14-54		
						5+94.6								
6+00	91.1	83.40	7.7					96-3492	1201 E R 1201 E R	1202 A 1202 A	3-14-96	11-7-97 6-14-54		
						6+28.8		#1174						
						6+55.8								
						6+92.2		#1175				6-14-54		
7+00	91.5	83.60	7.9		7+16									
						7+55		#1247	1133 1133	1132 1132		6-21-54		
					7+78			#1734			8-10-54			
8+00	92.4	83.80	8.6	8+00		8+17		#1246		1126 1126		6-21-54		
						8+35.5								
						8+96	8+83.4	#1736	#1245	1121 1121	1120 1120	8-10-54	6-21-54	
9+00	92.5	84.00	8.5			9+56.8	9+47.6	#1439	#1244	1115 1115	1114 1114	7-9-54	6-21-54	
10+00	92.4	84.20	8.2			10+17.2	10+11.2	#1438	#1243	1107 1107	1108 1108	7-9-54	6-21-54	
							10+74.5		#1242		1102 1102		6-21-54	
11+00	93.8	84.40	9.4		11+08			#1437		1101 1101		7-9-54		
11+18	94.3	84.44	9.9	11+17.9										

Line #2

0+00	90.3	82.28 out 84.28 in	8.0 6.0	0+00 New MH								
					0+57	0+54	#1752		1301 1301	1301 1301		8-13-54
1+00	91.8	84.46	7.3		1+18.4	1+15.4	#1753		1307 1307	1307 1307		8-13-54
					1+85	1+82	#1754		1315 1315	1315 1315		8-13-54
2+00	91.5	84.66	6.8		4+40 P/C-CD 2+49.4	2+46.4	2003-2042 1755		1319 R 1319	1319 1319	1-6-03 8-13-54	
2+90	91.9	84.84	7.1	2+88.9								
3+00	91.9	84.86	7.0		3+16.5	3+13.5	#1756		1320 1320	1320 1320		8-13-54
					3+84	3+81	#1757		1401 1401	1401 1401		8-13-54
4+00	92.1	85.06	7.0		4+47 4+40 P/C-CD 4+96.3	4+44 4+93.3	#1758 2002-02180 1759	#2004 #2005	1407 1415 R	1408 R 1412	8-13-54 10-10-02	9-14-54 9-14-54
5+00	92.6	85.26	7.3			5+71	5+68	#1760	1419 1419	1419 1419		12-16-80
5+80	93.8	85.42	8.4	5+80.2								

R# 15719 - 1302 Tulsa - Kent Boyce - 2 28 56 - 0+00 E (1430.0)
42216 - 1317 Tulsa - Extension - 11-12-73 - Wipeed Drake

- # 1729 - 2nd - 1215 Crowley - 8-10-54 - Brodie Pllg. Co
- # 1731 - 2nd - 1201 Crowley - 8-10-54 - Brodie Pllg. Co
- # 1732 - 2nd - 1145 Crowley - 8-10-54 - Brodie Pllg. Co
- # 1733 - 2nd - 1139 Crowley - 8-10-54 - Brodie Pllg. Co
- # 1735 - 2nd - 1127 Crowley - 8-10-54 - Brodie Pllg. Co

#93-7733-7-1138 Tulsa - R-4" ABS 40 - Wye not uncovered. Replaced all but lower 5 ft of line. Installed 6" trap, 5 ft from main, 4" of shallow