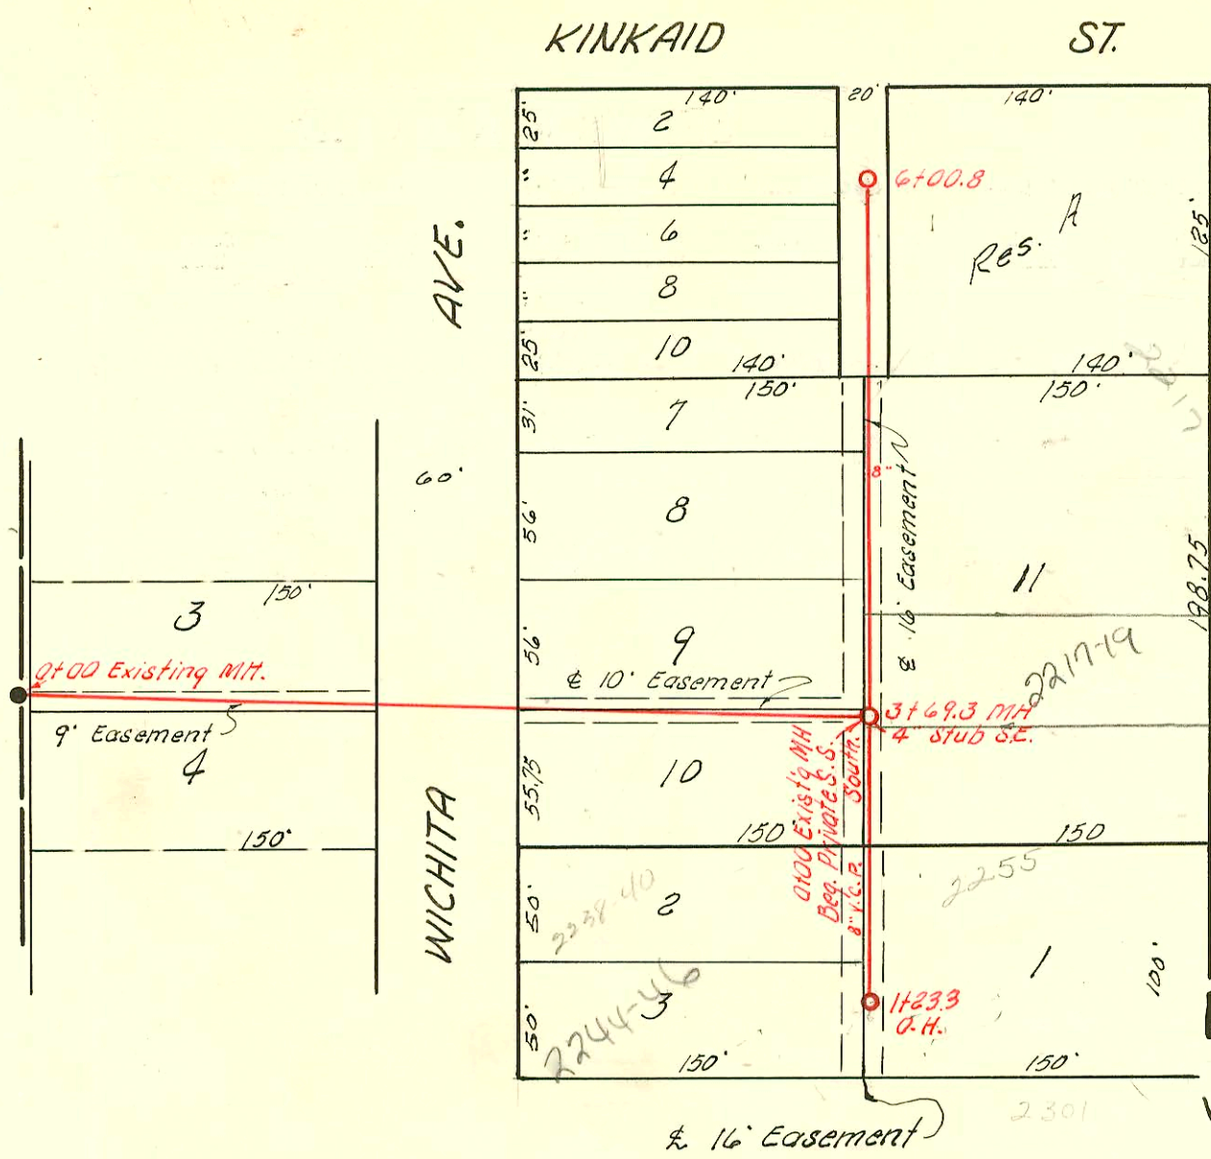

LAT. 25, DIST. B, S. S. № 20

W. B. CARTER JULY 7, 1954

BK. № K-18, PROJ. NO. C24-26

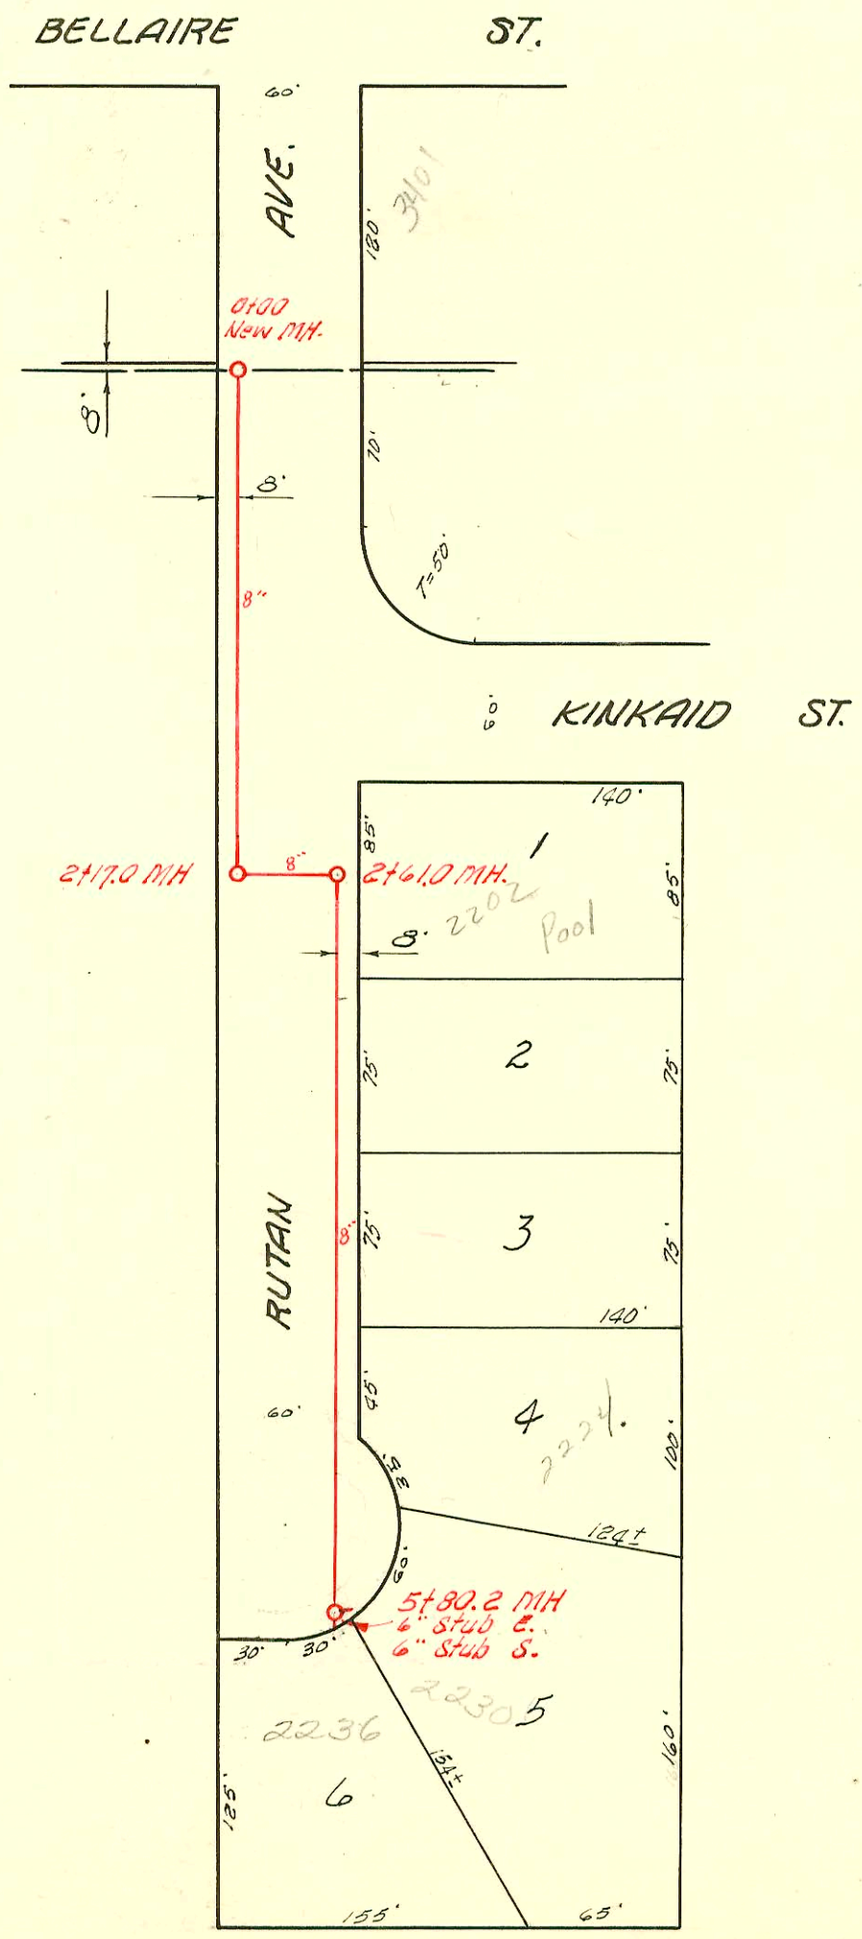

N

LAT. 38, D.C.S.# 2, S. S.# 12

W. B. CARTER SEPT. 21, 1954

BK. NO. JT 62, PROJ. NO. C24-42

Form 41-(54) 8-53

CONSTRUCTION RECORD / SERVICE RECORD

STATION	ELEVATION Ground	ELEVATION Grade	Depth	MANHOLE	6-INCH "Y" BRANCHES North ~~West~~	6-INCH "Y" BRANCHES South ~~East~~	No. of Permit North West	No. of Permit South East	House Number North West	House Number South East	DATE OF PERMITS North West	DATE OF PERMITS South East
Line #2 Continued												
5+0	90.60	82.60	8.0									
					5+35.0	5+39.0	#1365	#1375	1145 Sulsa	1132 Sidley	6-30-54	6-30-54
	90.8	82.68	8.1	5+78.5								
						5+93.0		#1376		1126 Sidley		6-30-54
6+0	91.1	82.70	8.4									
					6+05.0		#1366 97-18976-7		1139 Sulsa		6-30-54	
					6+61.0	6+64.0	#1367	#1377	1133 Sulsa	1120 Sidley	6-30-54	6-30-54
7+0	92.3	82.80	9.5									
						7+24.0		#1661		1114 Sidley		8-5-54
					7+44.0		#1658		1137 Sulsa		8-5-54	
						7+95.0		#1660		1108 Sidley		8-5-54
8+0	92.0	82.90	9.1									
					8+19.5		#1659		1121 Sulsa		9-29-88 8-5-54	
					8+72.0	8+69.0	96-354-7 #1656	#1659	1115 Sulsa	1102 Sidley	9-29-96 8-5-54	8-5-54
	92.8	82.98	9.8	8+78.2								
LAT. 25, DIST. B, S.S. No 20												
					4" wyes North	South						
0+0	98.3	93.00	5.3	0+00 Exist'g MH.								
1+0	98.0	93.10	4.9									
2+0	96.8	93.20	3.6									
						2+55.9		#1611		2232 S. Wichita		7-27-54
					2+88.5		#1932		2226 S. Wichita		9-9-54	
					WEST	EAST						
3+0	96.6	93.30	3.3									
	96.9	93.37 out 93.57 in	3.5 3.3	3+69.3	(4" Stub	S.E.)	#3266		2223 S. Water		12-5-54	
4+0	96.6	93.60	3.0									
					4+25.0	4+28.0	111[illegible]	4258	[illegible]	2213-15 Sutter	[illegible]	4-4-57
					4+73.4	4+76.4						
5+0	97.3	93.70	3.6									
					5+09.2	5+12.2	#2308	B 4077	2219 S. Wichita	2207 S. Water	10-20-59	9-7-65
					5+72.7	5+75.7	#2309		2200 S. Wichita		10-20-59	
					5+94.1		#2955		201-03 W. Kingsville		12-14-54	
6+0												
	97.1	93.80	3.3	6+00.8								
LAT. 38, D.C.S. #2, S.S. NO 12												
					4" Wyes Y East							
0+0	105.2	97.40	7.8									
1+0	104.8	97.80	7.0									
2+0	104.6	98.20	6.4									
	104.5	98.27 out 98.47 in	6.2 6.0	2+17.0								
	108.0	98.65 out 98.85 in	9.4 9.2	2+61.0								
						2+68.5		#02944 1315		2202 S. Dalton		3-26-81 7-2-56
3+0	107.9	99.00	8.9									
						3+16.0		#2860		2210 S. Dalton		12-6-54
						3+90.5						
4+0	107.8	99.40	8.4									
						4+65.0		44684		2210 S. Dalton		5-9-55
5+0	108.3	99.80	8.5					#6658		2208 S. Dalton		10-12-55
	108.5	100.13	8.4	5+80.2	6" Stub E. 6" Stub S.			7726		2236 S. Dalton		8-8-58
Ext. LAT. 25, DIST. B, S.S. #20 W.B. CARTER, JULY 8, 1955 BK. K-19, PRIVATE JOB												
					Y West	Y East						
0+0	96.9	93.60	3.3	0+00 Exist'g MH								
					0+61.3	0+58.3	#6258	#6259	2238-40 S. Wichita	2255 S. Water	9-2-55	9-2-55
1+0	98.3	93.70	4.6									
					4" SDR 35 1+15.8	1+12.8	96-1473-0101 #6257		2241-40 S. Wichita		2-9-96 9-2-55	
	98.4	93.73	4.7	O.H. 1+23.3								

#1931 - Tap - 2220 S. Wichita - Lee Shaylor - 12-9-54

2002-01370 4257 - WYE - 2217-19 S. Water R. A. Ray - 4-26-57 - Reddi - 4" 40 PVC 6" Wye repaired 5' N of MH 3+69.3 (3+74.3) Shallow - 1/4" fall - 2-4" twin co @ house, Replaced entire line - 2 Stubouts, No alley

6300 Tap 2224 Shuter Kennedy 3-12-58